


S75°11'12"E
591.85

SCALE 1" = 100'

LIBER 1831 FOLIO 425
5.341 AC.

800139479

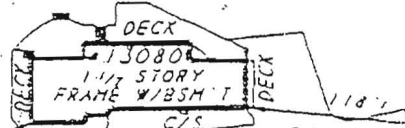

SEPTIC TANK
PDI
WELL
FENCE
ACCESS
GRAVEL DRIVEWAY
H.C.H.C.

11/21/02
Proposed pool
OK, maintain
30' to well
& 20' to trenches
SRK

S22°46'16"W
499.31


TO WILLIAMFIELD
DRIVE

N86°44'53"E
282.84

S72°42'12"W
293.49

S86°44'53"W
282.84

Contractor to verify
location of trenches
prior to installing
pool. SRK

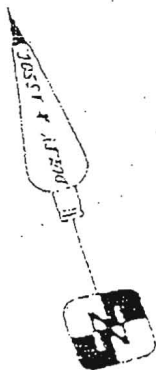

LOCATION SURVEY OF:
#13080 WILLIAMFIELD DRIVE
ELLICOTT CITY, MD 21042
RAMIN & HOPE SMITH REZVANI
ACCT# 02-031614-3

A LAND SURVEYING AND DESIGN COMPANY