

2357
STATE OF MARYLAND
WATER RESOURCES ADMINISTRATION
TAVES STATE OFFICE BLDG., ANNAPOLIS, MD. 21401
WELL COMPLETION REPORT

DATE RECEIVED (WRA USE ONLY) December 29, 1977
DEPTH OF WELL 200
COUNTY NUMBER W25922
PERMIT NO. FROM "PERMIT TO DRILL WELL" 1-1-1-2099
DRILLER'S IDENTIFICATION NO. 296

OWNER Thomas Associates, Inc.
STREET OR RFD Suite #302, 2000 Century Plaza
POST OFFICE Columbia, Md. 21044

WELL LOG
STATE THE KIND OF FORMATIONS PENETRATED, THEIR COLOR, DEPTH, THICKNESS AND IF WATER BEARING

DESCRIPTION (USE ADDITIONAL SHEETS IF NECESSARY)	FEET FROM	TO	CHECK IF WATER BEARING
Dirt	0	2	
Soft Red Sand & Clay	2	14	
Brown Sand	14	36	X
Brown Mica & Sand	36	54	
Brown Mica	54	63	
Blue Mica	63	65	
Soft Brn. Mica & Sand	65	73	X
Hard Brn. Mica	73	80	
Black Sandstone	80	86	
Brown Sandstone	86	88	X
Blue Mica	88	93	
Gravel	93	94	X
Blue Mica mixed with Pink & Green & Black	94	200	

GROUTING RECORD
WELL HAS BEEN GROUTED (CIRCLE APPROPRIATE BOX) YES Y NO N
TYPE OF GROUTING MATERIAL (CIRCLE BOX) CEMENT CM BENTONITE CLAY BC
NO. OF BAGS 25 NO. OF POUNDS 2,632
GALLONS OF WATER 168
DEPTH OF GROUT SEAL (TO NEAREST FOOT) 81
FROM 0 TO 81 FT.

CASING RECORD
Casing Type: STEEL X
MAIN CASING TYPE: S T
NOMINAL DIAMETER TOP (MAIN) CASING (NEAREST INCH) 6
TOTAL DEPTH OF MAIN CASING (NEAREST FOOT) 83
OTHER CASING (IF USED) DIAMETER (INCH) DEPTH (FEET) FROM TO


SCREEN RECORD
SCREEN TYPE OR OPEN HOLE: INSERT APPROPRIATE CODE BELOW
STEEL ST BR BR HO HO
SPRINGS OR BRONZE PL PL OT OT
PLASTIC PLASTIC OTHER OTHER

PUMPING TEST
C 3
HOURS PUMPED (TO NEAREST HOUR) 6
PUMPING RATE (GALLONS PER MINUTE TO NEAREST GALLON) 4
METHOD USED TO MEASURE PUMPING RATE Flowmeter
WATER LEVEL (DISTANCE FROM LAND SURFACE) BEFORE PUMPING 83 WHEN PUMPING 94
TYPE OF PUMP USED (CIRCLE APPROPRIATE BOX) A AIR P PISTON T TURBINE C CENTRIFUGAL R ROTARY O OTHER (DESCRIBE BELOW) J JET S SUBMERSIBLE

PUMP INSTALLED
TYPE OF PUMP (WRITE APPROPRIATE LETTER IN BOX - SEE ABOVE: A, C, J, P, R, S, T, O)
DRILLER WILL INSTALL PUMP (CIRCLE APPROPRIATE BOX) YES Y NO N
CAPACITY: GALLONS PER MINUTE (TO NEAREST GALLON) 31 35
PUMP HORSE POWER 37 41
PUMP COLUMN LENGTH (NEAREST FOOT) 43 47

CASING HEIGHT (CIRCLE APPROPRIATE BOX AND ENTER CASING HEIGHT) + ABOVE - BELOW
LAND SURFACE 2
LOCATION OF WELL ON LOT: SHOW PERMANENT STRUCTURE SUCH AS BUILDINGS, SEPTIC TANKS, AND/OR OTHER LAND MARKS AND INDICATE NOT LESS THAN TWO DISTANCES (MEASUREMENTS TO WELL).

CIRCLE APPROPRIATE BOXES
A WELL WAS ABANDONED AND SEALED WHEN THIS WELL WAS COMPLETED
E ELECTRIC LOG OBTAINED
P TEST WELL CONVERTED TO PRODUCTION WELL
I HEREBY CERTIFY THAT I HAVE COMPLIED WITH ALL CONDITIONS STATED ON THE ABOVE-CAPTIONED "PERMIT TO DRILL WELL", AND THAT INFORMATION CONTAINED IN THIS REPORT IS TRUE, ACCURATE, AND COMPLETE TO THE BEST OF MY KNOWLEDGE, INFORMATION AND BELIEF.
DRILLER'S NAME Ronald L. Kyker
SIGNATURE
HEALTH

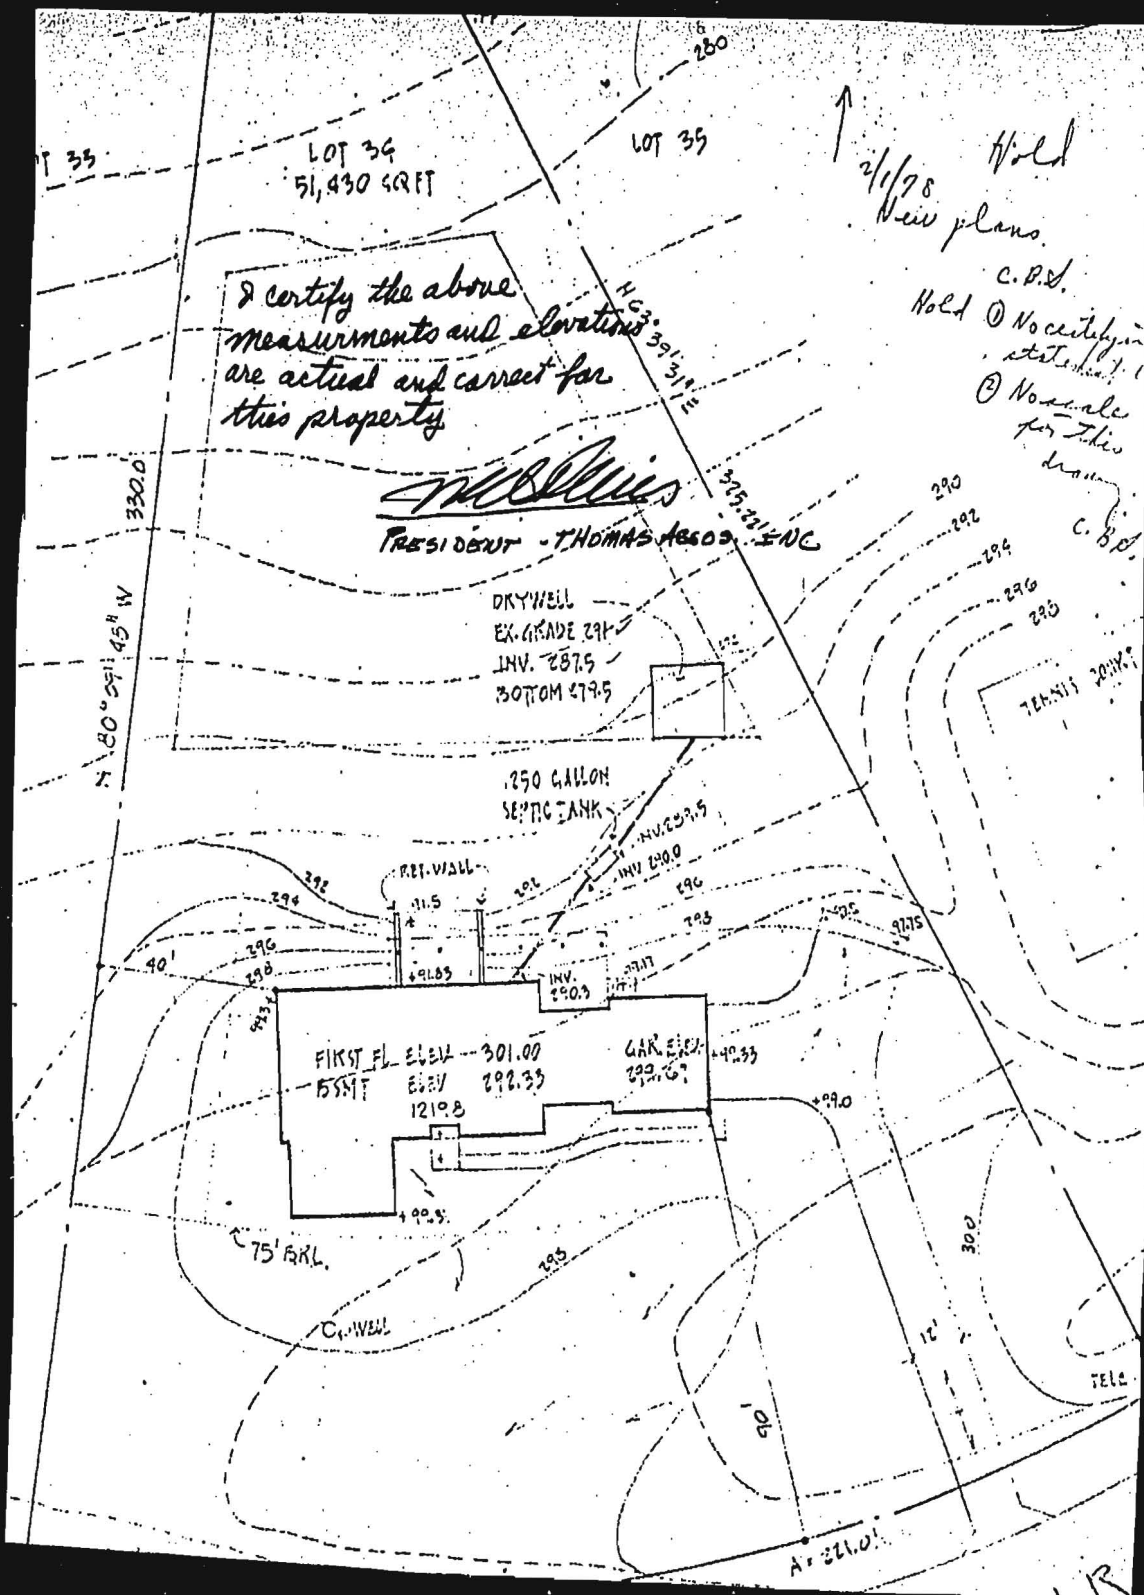

I certify the above
measurements and elevations
are actual and correct for
this property

McEllis
PRESIDENT - THOMAS ASSOC. INC.

DRY WELL
EX. GRADE 291.5
INV. 287.5
BOTTOM 279.5

250 GALLON
SEPTIC TANK

FIRST FL. ELEV. 301.00
BSMT. ELEV. 292.33

GAR. ELEV. 299.6

TENNIS COURT

TELE