

APPLICATION

SEWAGE DISPOSAL TESTING

A 14076
P _____

MARYLAND STATE DEPARTMENT OF HEALTH

HOWARD COUNTY

Septic tanks for House 1-2 750 sq. ft. each
ELLICOTT CITY

DISTRICT 3

DATE 11/4/68

Dry lot cells for path houses to be 300 sq. ft. at adjacent sidewalk area below the inlet pipe. House NO 1 ~~Septic~~ Well 184 ft from Right side line and 36 ft from rear lot line. Width to 11 ft. - Right - at 12 ft. House NO 2 located by Well 60 ft from left side line and 35 ft from rear lot line. As path house sites are seen from facing lot standing on River Road.

TO: THE COUNTY HEALTH OFFICER
ELLICOTT CITY, MARYLAND

I, HEREBY, APPLY FOR THE NECESSARY TESTS IN ORDER TO CONSTRUCT (OR RECONSTRUCT) A SEWAGE DISPOSAL SYSTEM.

PROPERTY OWNER Maurice M. Miller, Jr. & Wife, Janet L.

ADDRESS 423-G Town & Country Blvd., Ellicott City PHONE 465-4903

PROPERTY LOCATION:

SUBDIVISION _____ LOT NO. _____

ROAD AND DESCRIPTION River Rd., Sykesville - approx. 2 mi. east of Rt. 32

OCCUPANT _____ PHONE _____

PERSON TO CONSTRUCT SYSTEM _____

ADDRESS _____ PHONE _____

SIZE OF LOT 5.0 acres TYPE BLDG. 2 houses

IF NOT SINGLE RESIDENCE DESCRIBE _____

3 in one house
2 in other house
(2 separate septic systems to be installed) 11/11/68

SIGNATURE OF APPLICANT Maurice M. Miller, Jr.


APPROVED BY James T. Wright FOR D. J. Wright DATE 11/13/68

REJECTED BY _____ FOR _____ DATE _____

HOLD PENDING FURTHER TESTS _____ DATE _____

REASONS FOR REJECTION OR HOLDING _____

THIS IS NOT A PERMIT

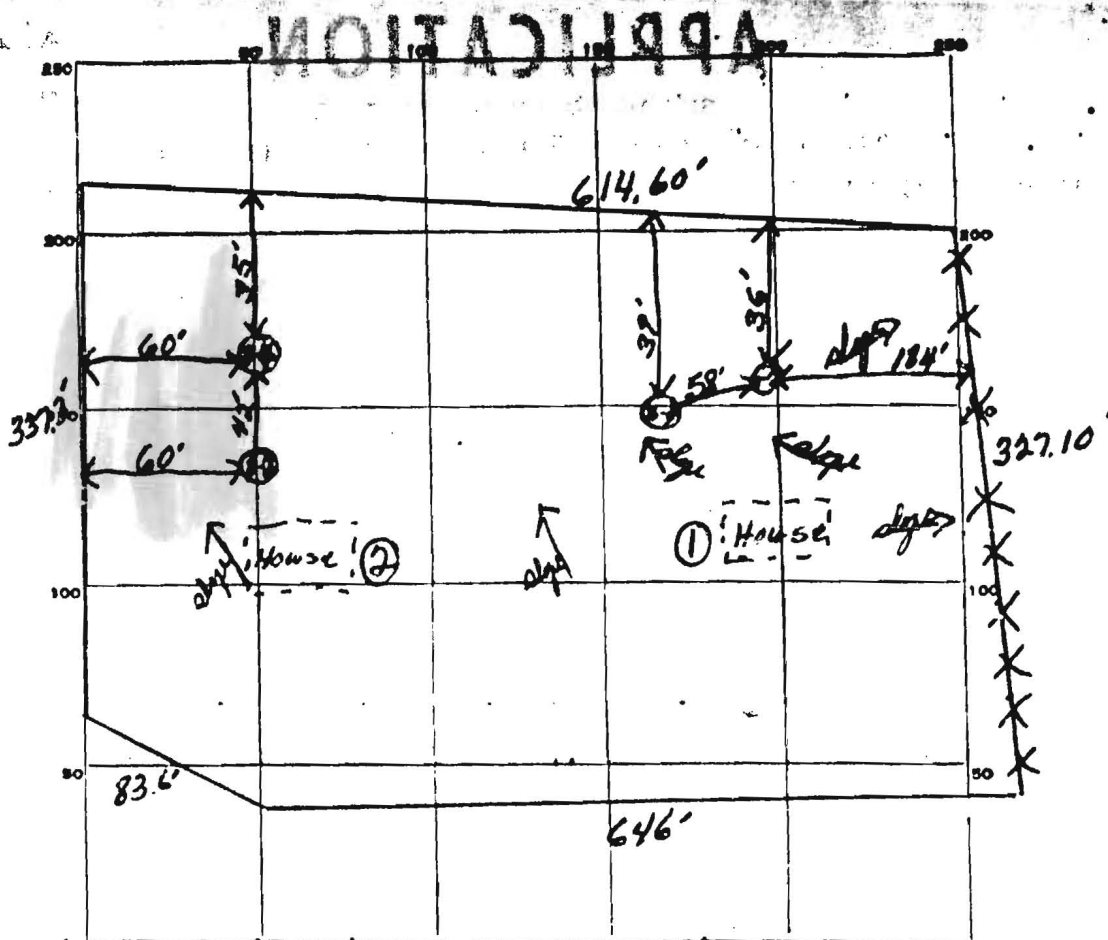

INDICATE NORTH. - NAME ADJOINING ROADWAY AS BASE LINE.

Rolling Road

DATE	TEST NO.	DEPTH	PRE-WET		TEST - 1" DROP		TIME
			START	STOP	START	STOP	
11/13/65	1	10 1/2'	11 36	11 52	11 39	11 44	5 min
	2	4'	11 37	11 39	11 39	11 43	4 min
	3	10 1/2'	12 06	12 09	12 09	12 13	4 min
	4	4'	12 10	12 11	12 11	12 13	2 min
	1	10'	11 59	12 00	12 00	12 03	2 min
	2	4'	1 15	1 20	1 20	1 25	5 min
	3	12 1/2'	1 36	1 37	1 37	1 39	2 min
	4	4 1/2'	1 39	1 43	1 43	1 48	5 min

15

4 min AV

14

4 min AV

SOIL AUGER FINDING Rock & Sand X Fence

TESTED BY John

REMARKS