

12/5/69 approved by J. J. [illegible]
PERMIT

SEWAGE DISPOSAL SYSTEM

MARYLAND STATE DEPARTMENT OF HEALTH

HOWARD COUNTY

ELLICOTT CITY

DISTRICT 3

INDEXED

DATE 11/19/69

Herman Kirk

IS PERMITTED TO INSTALL ☒ ALTER ☐

ADDRESS Annapolis Rock Road, Woodbine, Md.

PHONE 489-4724

A SEWAGE DISPOSAL SYSTEM LOCATED AT _____

SUBDIVISION _____

ROAD River Rd. Sykesville, Md.

approx. 2 mi. east of Rt. 32

PROPERTY OWNER Maurice M. Miller, Jr. & wife
Mr. Paul & Janet Sabine

ADDRESS _____

SPECIFICATIONS 2 houses - 3 bedrooms in each

DRAIN FIELD _____ DEPTH _____ FEET, BOTTOM AREA _____ SQ. FT.

SEEPAGE PITS _____ ABSORBENT SIDE-WALL AREA _____ SQ. FT.

SEPTIC TANK CAPACITY 750 GALLONS for each house.

FOR GARBAGE GRINDER, INCREASE DISPOSAL AREA 22% & TANK CAPACITY 50%.

OTHER Dry wells for both houses to be 300 sq. ft. of absorbent sidewall area

below the inlet pipe. House No. 1 locate dry well 29 1/2 ft. from right side line

and 75 ft. from rear lot line with a maximum depth of 12 ft. Inlet pipe to be

3' below original grade. House No. 2 locate dry well 60 ft. from left side line
146

and 32 ft. from rear lot line as both house sites are seen from facing lot standing
on River Road. NOTE: ALL PIPE FROM HOUSE TO SEPTIC TANK MUST BE CAST IRON.

PERMANENT RECORD BY James T. Wright DATE 11/13/68

PERMIT VOID AFTER THREE YEARS.


FILL SEPTIC TANK AND DISTRIBUTION BOX WITH WATER BEFORE CALLING FOR AN INSPECTION. COVER NO WORK UNTIL INSPECTED AND APPROVED.

NEITHER THE HOWARD COUNTY COMMISSIONERS NOR THE HEALTH DEPARTMENT IS RESPONSIBLE FOR THE SUCCESSFUL OPERATION OF ANY SYSTEM.

THIS PERMIT SIGNED
AND RETURNED 5/5/86
Serial # 70184 Prod

**NOTIFY THE HEALTH DEPARTMENT 48 HOURS
BEFORE EXCAVATIONS ARE TO BE BACK FILLED.**

12/4/69
1/8
1/9
1/10
1/100

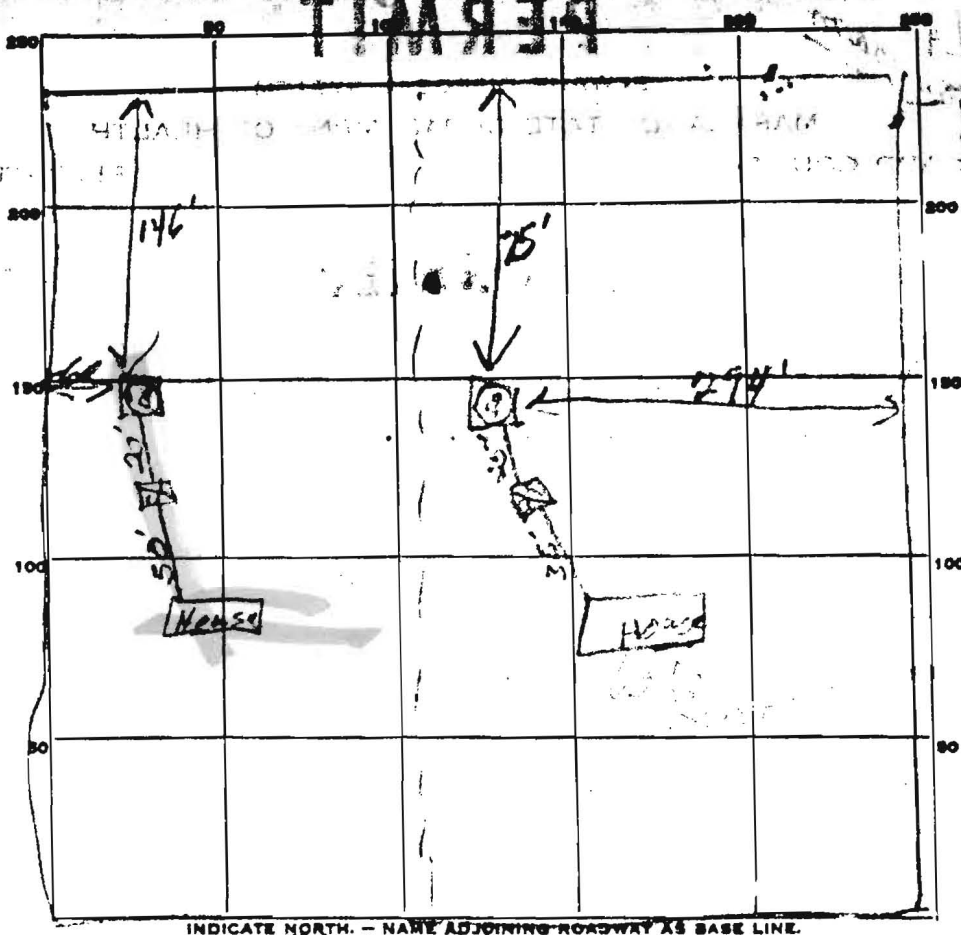

INDICATE NORTH. - NAME ADJOINING ROADWAY AS BASE LINE.

River Rd

PERMIT CARD OK

SEPTIC TANK, LEVEL 1-750 Cement
1-750 Cement

CLEANOUTS OK

DISTRIBUTION BOX, LEVEL _____

TILE FIELD, DEPTH _____ FT. TRENCH WIDTH _____ FT.

GRAVEL DEPTH _____ IN. TOTAL LENGTH _____ FT.

NUMBER OF TRENCHES 1-10 TOTAL BOTTOM AREA _____

SEEPAGE PITS, INSIDE DIAMETER 2-10 FT. DEPTH BELOW INLET 1-9 FT.

ABSORBENT AREA 1432 SQ. FT.

REMARKS _____

DATE SYSTEM APPROVED 12/5/69

INSPECTOR Jim T. Wright

