

1/29/03 NOON  
PUB. SEWER STATUS VERIFIED BY     

ISSUE DATE: \_\_\_\_\_

APPROVAL DATE: 1/29/03

**PERMIT**

**INDEXED**

P 518558

A REPAIR

**ON-SITE SEWAGE DISPOSAL SYSTEM  
HOWARD COUNTY HEALTH DEPARTMENT  
BUREAU OF ENVIRONMENTAL HEALTH**

**02-363321**

Jack Fyock Septic Service

IS PERMITTED TO INSTALL ☐ ALTER ☒

ADDRESS: PO Box 89, Glenelg, MD 21737

PHONE NUMBER: 410-988-9270

SUBDIVISION: \_\_\_\_\_

LOT NUMBER: 27

ADDRESS: 4445 Stonecrest Drive

PROPERTY OWNER: Grant

SEPTIC TANK CAPACITY (GALLONS): \_\_\_\_\_

PUMP CHAMBER CAPACITY (GALLONS): \_\_\_\_\_

NUMBER OF BEDROOMS: \_\_\_\_\_

SQUARE FEET PER BEDROOM: \_\_\_\_\_

LINEAR FEET OF TRENCH REQUIRED: \_\_\_\_\_

1/27/03 INSP REQUESTED  
FOR S.T. REPLACEMENT;  
CONTRACTOR ADVISED PUB.  
SEWER AVAILABLE, NO INSP WILL BE  
PROVIDED  
MR/GM

TRENCHES:	Trench to be _____ feet wide. Inlet _____ feet below original grade. Bottom maximum depth _____ feet below original grade. Effective area begins at _____ feet below original grade. _____ feet of stone below distribution pipe.
LOCATION:	
PURPOSE:	To replace tank. Call for inspection when ground is opened so sanitarian can recommend repair.

PLANS APPROVED: Mark Rifkin (SRK)

DATE: 1/29/03

NOTE: PERMIT VOID AFTER 2 YEARS

NOTE: CONTRACTOR RESPONSIBLE FOR SCHEDULING A PRE-CONSTRUCTION INSPECTION FOR ALL INSTALLATIONS

NOTE: WATERTIGHT SEPTIC TANKS REQUIRED

NOTE: ALL PARTS OF SEPTIC SYSTEM SHALL BE 100 FEET FROM ANY WATER WELL

NOTE: MANHOLE RISERS REQUIRED ON ALL SEPTIC TANKS AND PUMP CHAMBERS

**NEITHER THE HOWARD COUNTY COUNCIL NOR THE HEALTH DEPARTMENT IS  
RESPONSIBLE FOR THE SUCCESSFUL OPERATION OF ANY SYSTEM**

**PERMITTEE RESPONSIBLE FOR OBTAINING FINAL APPROVAL ON THIS PERMIT**

**BUILDING PERMIT SIGNED** 410-313-2640 FOR INSPECTION OF SEPTIC SYSTEM


**AND RETURNED**

1-2606 600 157894-16 PDDL

P 518558

DESIGNATED MH FOR PUB. SEWER CONN PER ENG'G

NOT TO SCALE

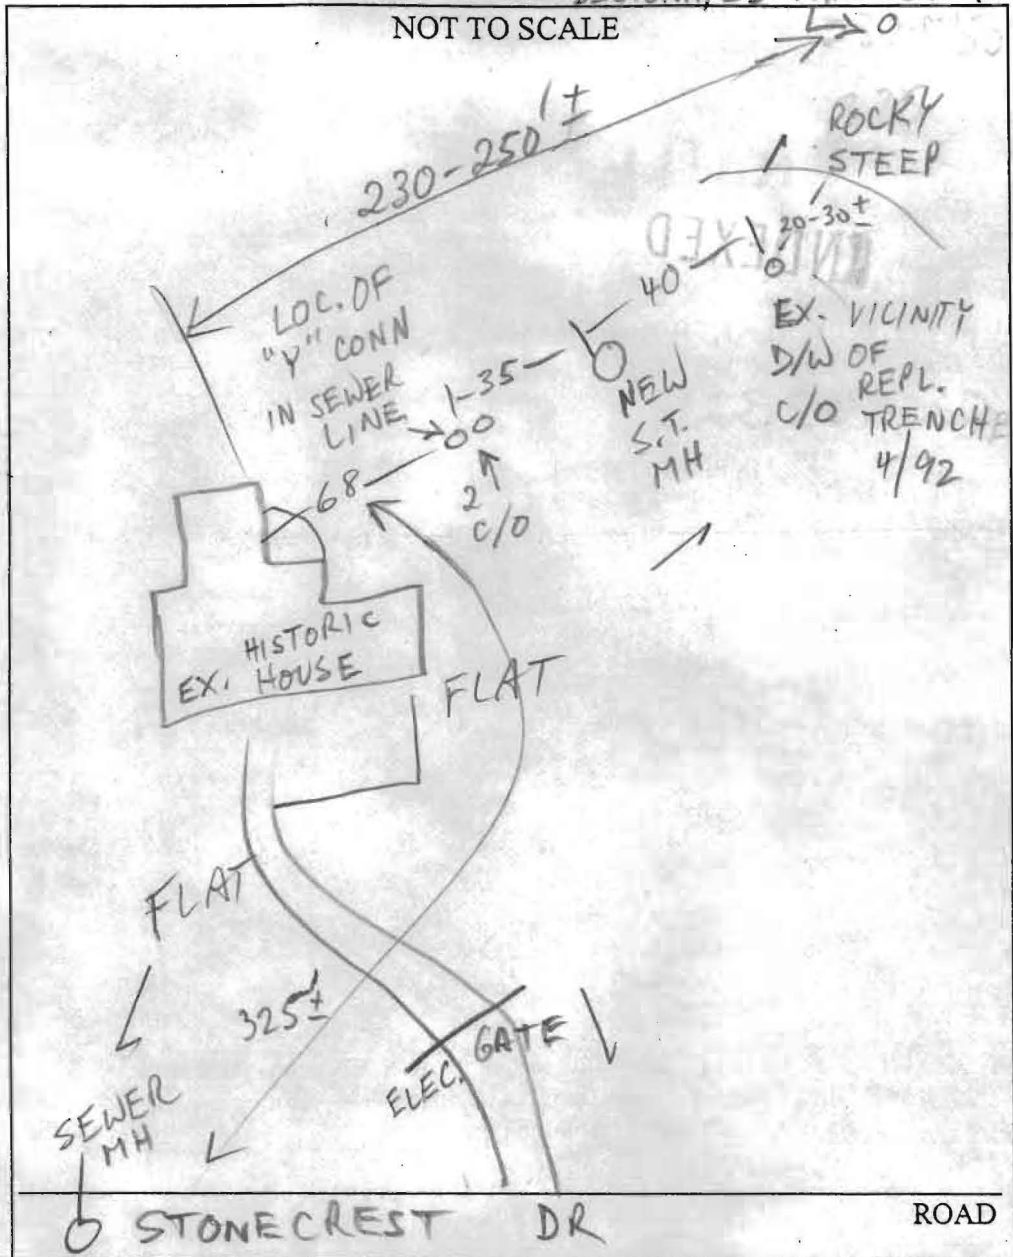

TRENCH/DRAINFIELD DATA		
WIDTH	INLET	BOTTOM
NUMBER OF TRENCHES		
TOTAL LENGTH		
ABSORPTION AREA		
DISTRIBUTION BOX LEVEL		
DISTRIBUTION BOX BAFFLE		
DISTRIBUTION BOX PORT		

SEPTIC TANK DATA	
SEPTIC TANK 1 LEVEL ✓	
CAPACITY	2000 GAL
SEAM LOC	TOP
TANK LID DEPTH	2½-3'
BAFFLES	TO BE INSTALLED
BAFFLE FILTER	
MANHOLE LOC	FRONT
6" PORT LOC	
WATERTIGHT TEST	
SEPTIC TANK 2 LEVEL	
CAPACITY	GAL
SEAM LOC	
TANK LID DEPTH	
BAFFLES	
BAFFLE FILTER	
MANHOLE LOC	
6" PORT LOC	
WATERTIGHT TEST	

PRE-CONSTRUCTION 1/29/03 MET INSTALLER TO COLLECT INFO TO DETERMINE PROPRIETY OF S.T. REPLACEMENT INSTEAD OF PUB. SEWER CONN. MR

INSTALLATION 1/29/03 AFTER REVIEW, CONN TO PUB. SEWER @ DESIGNATED MH NOT FEASIBLE DUE TO SLOPE, ROCK; S.T. REPLACEMENT ACCEPTED & APPROVED MR

BUILDING PERMIT SIGNED AND RETURNED

FINAL INSPECTOR M. Rifkin DATE OF APPROVAL 1/29/03