

6/12/73
or 6/13/73

PERMIT

SEWAGE DISPOSAL SYSTEM

MARYLAND STATE DEPARTMENT OF HEALTH

HOWARD COUNTY

ELLCOTT CITY

INDEXED

DISTRICT 2

DATE 5/17/73

P 18502

A 16179

Final
6/12/73
R. Turner

Liberty Backhoe

IS PERMITTED TO INSTALL X ALTER

ADDRESS Box 23A, Branges Road, Marriottsville, Md.

PHONE 795-2642

A SEWAGE DISPOSAL-SYSTEM LOCATED AT

SUBDIVISION

Rolling Ridge S/H

ROAD

8447 Rolling Ridge Court
Old Frederick Rd. - LOT 1
nr. Daniels Rd. - south side

PROPERTY OWNER

Stephen E. Russ & wife

ADDRESS

SPECIFICATIONS = 3 bedrooms

DRAIN FIELD DEPTH FEET, BOTTOM AREA SQ. FT.

SEEPAGE PITS ABSORBENT SIDE-WALL AREA SQ. FT.

SEPTIC TANK CAPACITY 1,000 GALLONS

FOR GARBAGE GRINDER, INCREASE DISPOSAL AREA 22% & TANK CAPACITY 50%.

OTHER Dry well - 300 sq. ft. sidewall area below inlet-the inlet to be 4 ft. and

the bottom of the dry well no deeper than 12 ft. Place the dry well 45 ft. from the back lot line

line and 40 ft. from the left side of the lot as seen when facing the lot from Old Frederick

Rd. Reserve another area for a future dry well. This area is 45 ft. from the back lot line
and 95 ft. from the left side of the lot as seen when facing lot from Old Frederick Rd.

NOTE: ALL PIPE FROM HOUSE TO DRY WELL MUST BE CAST IRON.

PERMIT VOID AFTER THREE YEARS.

PLANS APPROVED BY R. Hodges

DATE 4/13/72


NOTE: INSTALL STAND PIPE ON SEPTIC TANK AND DRY WELL.

FILL SEPTIC TANK AND DISTRIBUTION BOX WITH WATER BEFORE CALLING FOR AN INSPECTION. COVER NO WORK
UNTIL INSPECTED AND APPROVED.

NEITHER THE HOWARD COUNTY COMMISSIONERS NOR THE HEALTH DEPARTMENT IS RESPONSIBLE FOR THE
SUCCESSFUL OPERATION OF ANY SYSTEM.

A 16179

4/6/72
23

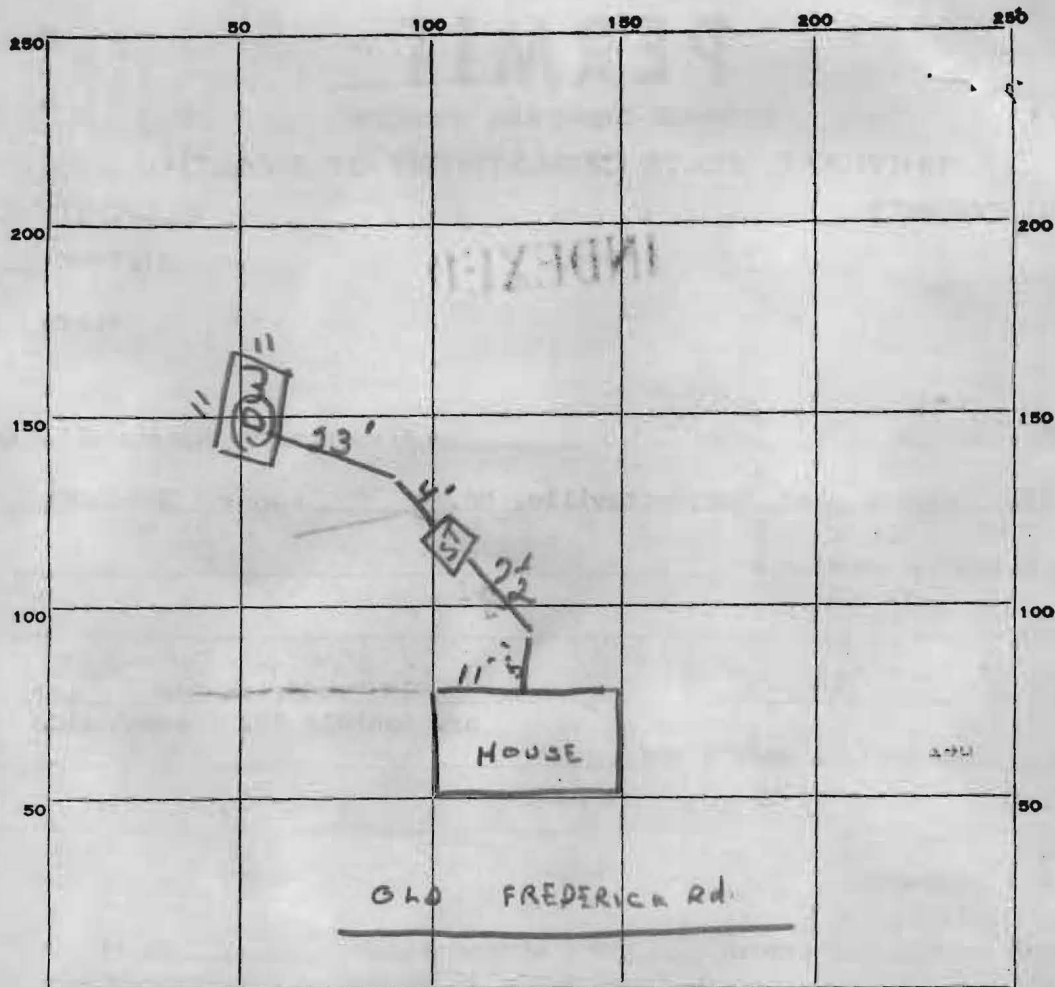

INDICATE NORTH. - NAME ADJOINING ROADWAY AS BASE LINE.

PERMIT CARD Signed

SEPTIC TANK, LEVEL 1800 gal. CLEANOUTS OK

DISTRIBUTION BOX, LEVEL _____

TILE FIELD, DEPTH _____ FT. TRENCH WIDTH _____ FT.

GRAVEL DEPTH _____ IN. TOTAL LENGTH _____ FT.

NUMBER OF TRENCHES _____ TOTAL BOTTOM AREA _____


SEEPAGE PITS, outside perimeter INSIDE DIAMETER 11 X 11 FT. DEPTH BELOW INLET 8 FT.

ABSORBENT AREA 352 SQ. FT.


REMARKS _____

DATE SYSTEM APPROVED 6/10/73 INSPECTOR R. Toner

50' R/W FOR INGRESS AND EGRESS

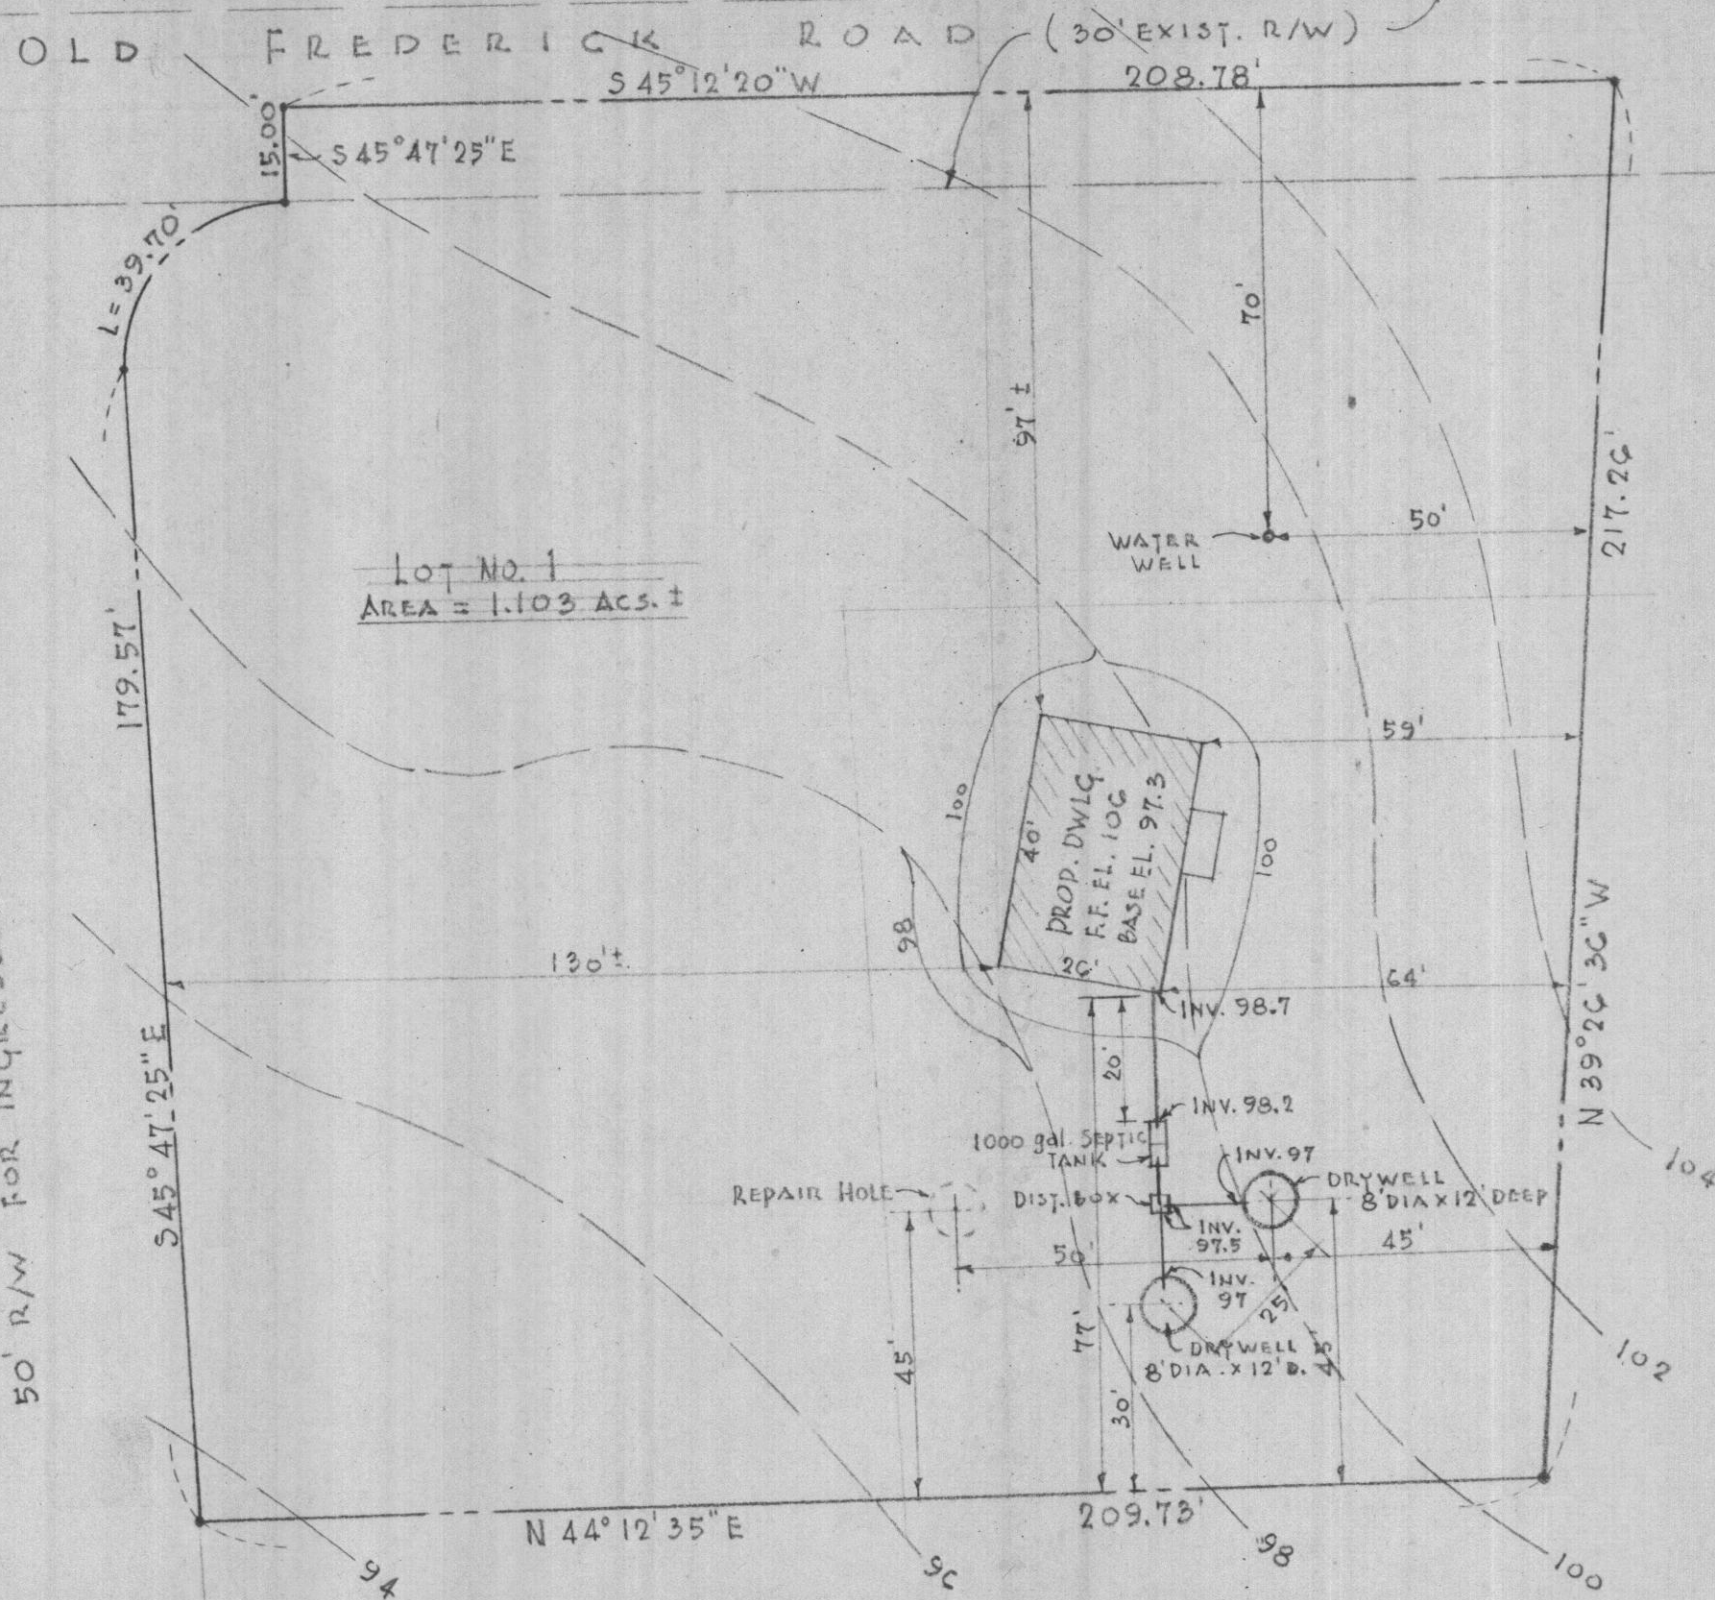

3/12/73 Septic Plans are OK R. Hodges

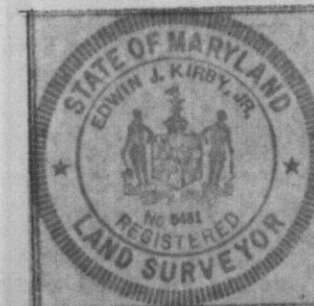

RESIDENCE for
MR. & MRS. STEPHEN E. RUSS
2ND ELEC. DIST., HOWARD CO., MD.

LIDER 596, PAGE 407

2/26/73 9/m