

ISSUE DATE: \_\_\_\_\_

APPROVAL DATE: \_\_\_\_\_

# PERMIT INDEXED

P 518560-F

A re-indexed

## ON-SITE SEWAGE DISPOSAL SYSTEM HOWARD COUNTY HEALTH DEPARTMENT BUREAU OF ENVIRONMENTAL HEALTH

05-379210

IS PERMITTED TO INSTALL ☐ ALTER ☒

ADDRESS: \_\_\_\_\_ PHONE NUMBER: \_\_\_\_\_

SUBDIVISION: Linden Chapel Hills LOT NUMBER: 24

ADDRESS: 13612 Voland Court PROPERTY OWNER: \_\_\_\_\_

SEPTIC TANK CAPACITY (GALLONS): \_\_\_\_\_

PUMP CHAMBER CAPACITY (GALLONS): \_\_\_\_\_

NUMBER OF BEDROOMS: \_\_\_\_\_

SQUARE FEET PER BEDROOM: \_\_\_\_\_

LINEAR FEET OF TRENCH REQUIRED: \_\_\_\_\_

|           |                                                                                                                                                                                                                                   |
|-----------|-----------------------------------------------------------------------------------------------------------------------------------------------------------------------------------------------------------------------------------|
| TRENCHES: | Trench to be _____ feet wide. Inlet _____ feet below original grade. Bottom maximum depth _____ feet below original grade. Effective area begins at _____ feet below original grade. _____ feet of stone below distribution pipe. |
| LOCATION: |                                                                                                                                                                                                                                   |
| PURPOSE:  |                                                                                                                                                                                                                                   |

PLANS APPROVED: \_\_\_\_\_ DATE: \_\_\_\_\_

NOTE: PERMIT VOID AFTER 2 YEARS

NOTE: CONTRACTOR RESPONSIBLE FOR SCHEDULING A PRE-CONSTRUCTION INSPECTION FOR ALL INSTALLATIONS

NOTE: WATERTIGHT SEPTIC TANKS REQUIRED

NOTE: ALL PARTS OF SEPTIC SYSTEM SHALL BE 100 FEET FROM ANY WATER WELL

NOTE: MANHOLE RISERS REQUIRED ON ALL SEPTIC TANKS AND PUMP CHAMBERS

**NEITHER THE HOWARD COUNTY COUNCIL NOR THE HEALTH DEPARTMENT IS  
RESPONSIBLE FOR THE SUCCESSFUL OPERATION OF ANY SYSTEM  
PERMITTEE RESPONSIBLE FOR OBTAINING FINAL APPROVAL ON THIS PERMIT  
CALL 410-313-2640 FOR INSPECTION OF SEPTIC SYSTEM**

P518560-F

Handwritten: 2/28/77 Partial 4/17/77 5/19/77

# PERMIT

SEWAGE DISPOSAL SYSTEM

MARYLAND STATE DEPARTMENT OF HEALTH

HOWARD COUNTY

P. 2024

A. 2274

ELLICOTT CITY

DISTRICT 205

DATE 6/22/77

INDEXED

\_\_\_\_\_ IS PERMITTED TO INSTALL 2 ALTER \_\_\_\_\_

ADDRESS \_\_\_\_\_ PHONE \_\_\_\_\_

A SEWAGE DISPOSAL SYSTEM LOCATED AT \_\_\_\_\_

SUBDIVISION Windsor Chapel Hills 196/2 POLO Court LOT 24, Sec. 5, Blk. 2

PROPERTY OWNER Frank Ellinger John E. Weber, Jr

ADDRESS Windsor Chapel Co., Route 100, Adelphi, MD.

## SPECIFICATIONS & NOTES

DRAIN FIELD \_\_\_\_\_ DEPTH \_\_\_\_\_ FEET, BOTTOM AREA \_\_\_\_\_ SQ. FT.

SEEPAGE PIT \_\_\_\_\_ ADJACENT SIDEWALL AREA \_\_\_\_\_ SQ. FT.

SEPTIC TANK CAPACITY 1100 GALLONS

FOR GARBAGE GRINDER, INCREASE DISPOSAL AREA AND TANK CAPACITY 50%.

OTHER: Beginning the trench at a point 12' ft. in from the 335' lot line and 200 ft. from the 22' lot line. The trench will be 4' ft. wide, 12' ft. deep, and contain 1 ft. of stone. The trench will extend 100 ft. in length and will be spaced 10 ft. apart, center to center. There will be no less than 10 ft. of sidewalk area and between houses along one side of the trench.  
NO STRUCTURES PLACED.

NOTE: ALL PITS FROM HOUSE TO DISPOSAL AREA MUST BE CISTERN. PITS MUST BE 6' IN DIAMETER. MUST BE 12' IN DEPTH. MUST BE 12' IN DIAMETER. MUST BE 12' IN DEPTH. MUST BE 12' IN DIAMETER.

PLANS APPROVED BY JOHN E. WEBER, JR. DATE 5/1/77


FILL SEPTIC TANK AND DISTRIBUTION BOX WITH WATER BEFORE CALLING FOR AN INSPECTION. COVER HOLES UNTIL INSPECTED AND APPROVED.

NEITHER THE HOWARD COUNTY COMMISSIONERS NOR THE HEALTH DEPARTMENT IS RESPONSIBLE FOR THE SUCCESSFUL OPERATION OF ANY SYSTEM.

BLDG. PERMIT SIGNED AND RETURNED 5/23/77  
John E. Weber, Jr  
Family Room

5-203 800141220 - REMOVE GARAGE ROOF-RENOVATE DOWN

Handwritten: 222742

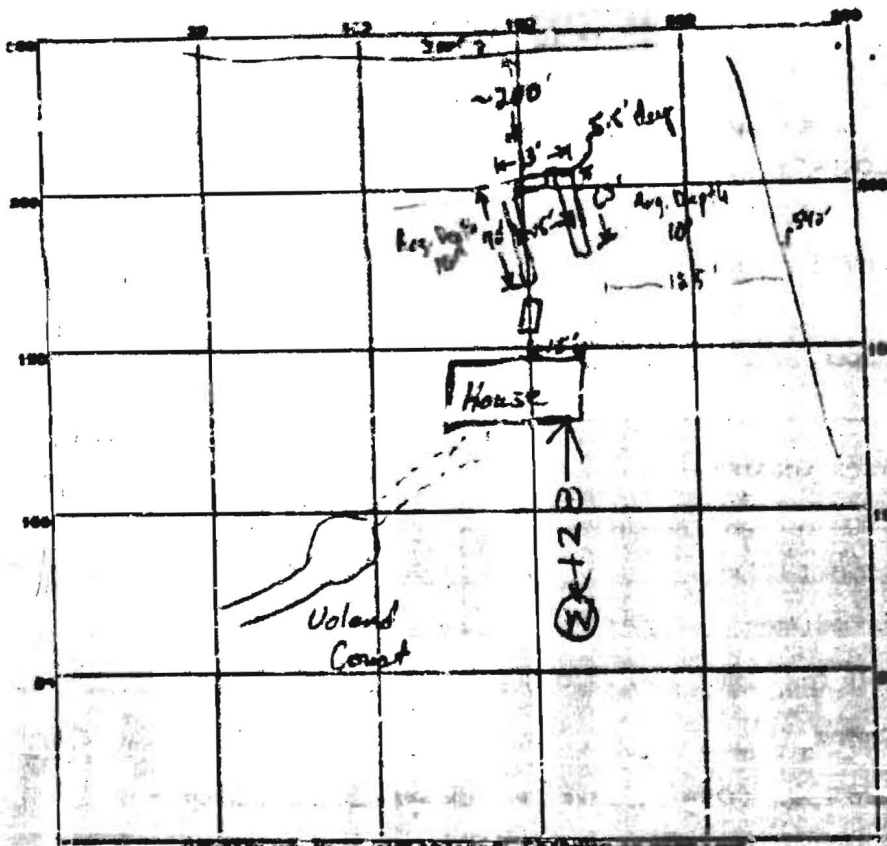

PERMIT CARD No. 71-1000

SEPTIC TANK LEVEL 1250 gal

CLEANOUT

DISPERSED SOIL LEVEL

TRECH FIELD DEPTH 10 FT. TRECH WIDTH 2

ARMED DEPTH 5 ft. TOTAL LENGTH 13

NUMBER OF TRECHES TOTAL BOTTOM AREA


SEEPAGE PITS, INSIDE DIAMETER FT. DEPTH BELOW INLET FT.

ABSORBENT AREA SQ. FT.

7/24/77 Site location OK. Treches OK. To fill up 5' stone & permit card no. 71-1000  
 8/5/77 48 1' 0" = 680 sq ft required 731 sq ft Replace corrugated  
 unapproved plastic pipe with approved type of pipe. Give  
 approved pipe with 2" of stone & call for inspection R. H. H. on  
 15 Aug 77 (1) pipe is of exposed construction  
 (2) stone is OK

DATE SYSTEM APPROVED 19 Aug 77 INSPECTOR L. Mansfield



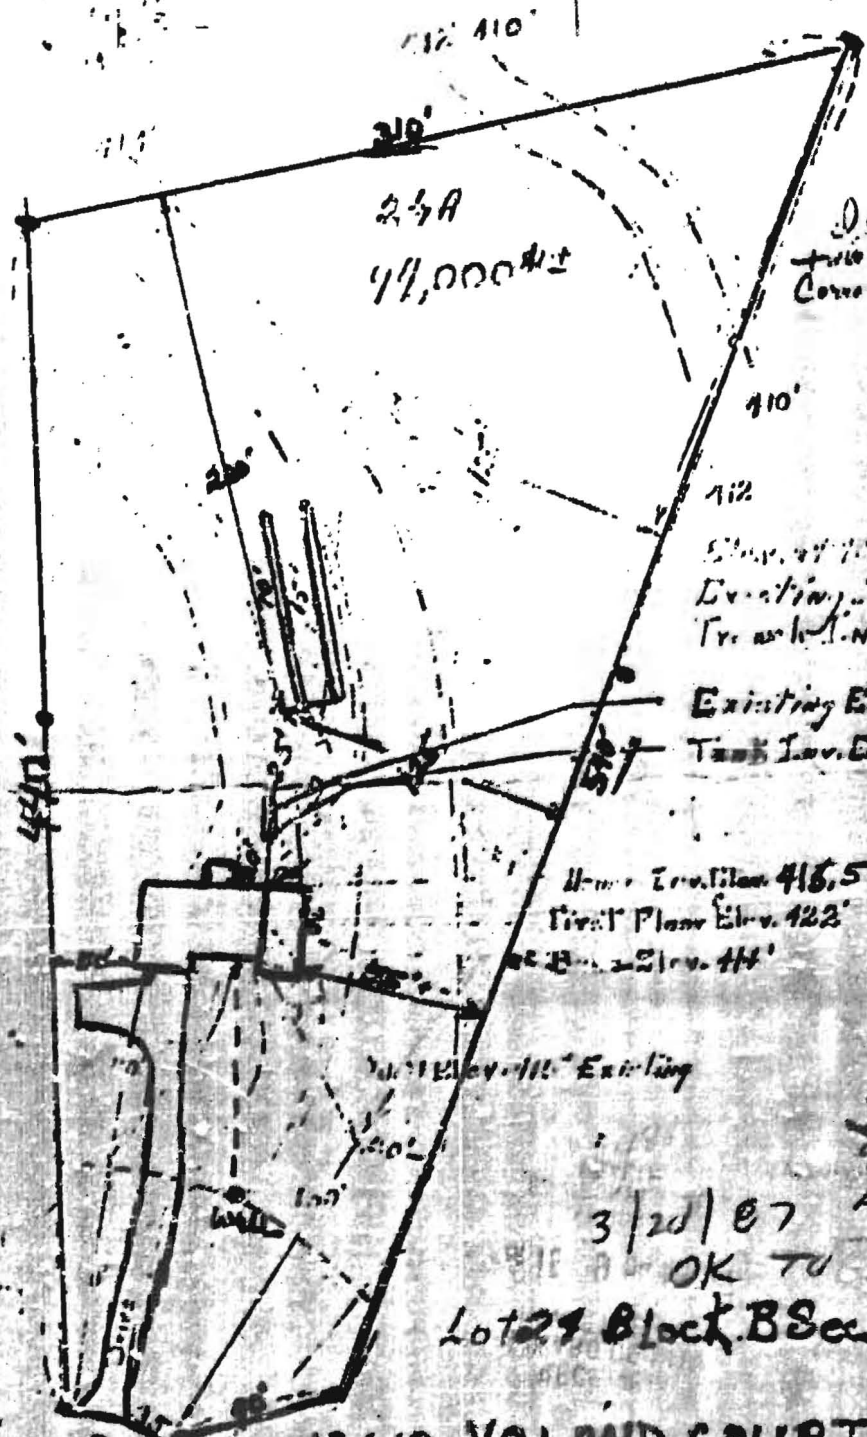

Directly adjacent to  
existing house and  
concrete for this house  
John Webster

Proposed Elev. 418'  
Existing Elev. 418'  
Tank Elev. Elev. 415'  
Existing Elev. 418'  
Tank Elev. Elev. 416'

House Elevation 415.5'  
First Floor Elev. 422'  
2nd Floor Elev. 414'

Scale 1" = 60'  
J.E.W.  
20 June 77

John E. Webster  
9311 Old Bridge Rd.  
Lynchburg, VA 24091  
Phone 991-7511

3/20/07

OK TO SIGN RH

Lot 29 Block B Sec 5

13612 VOLAND COURT  
LINDEN CHAPEL HILLS  
DAYTON, MARYLAND 21036