



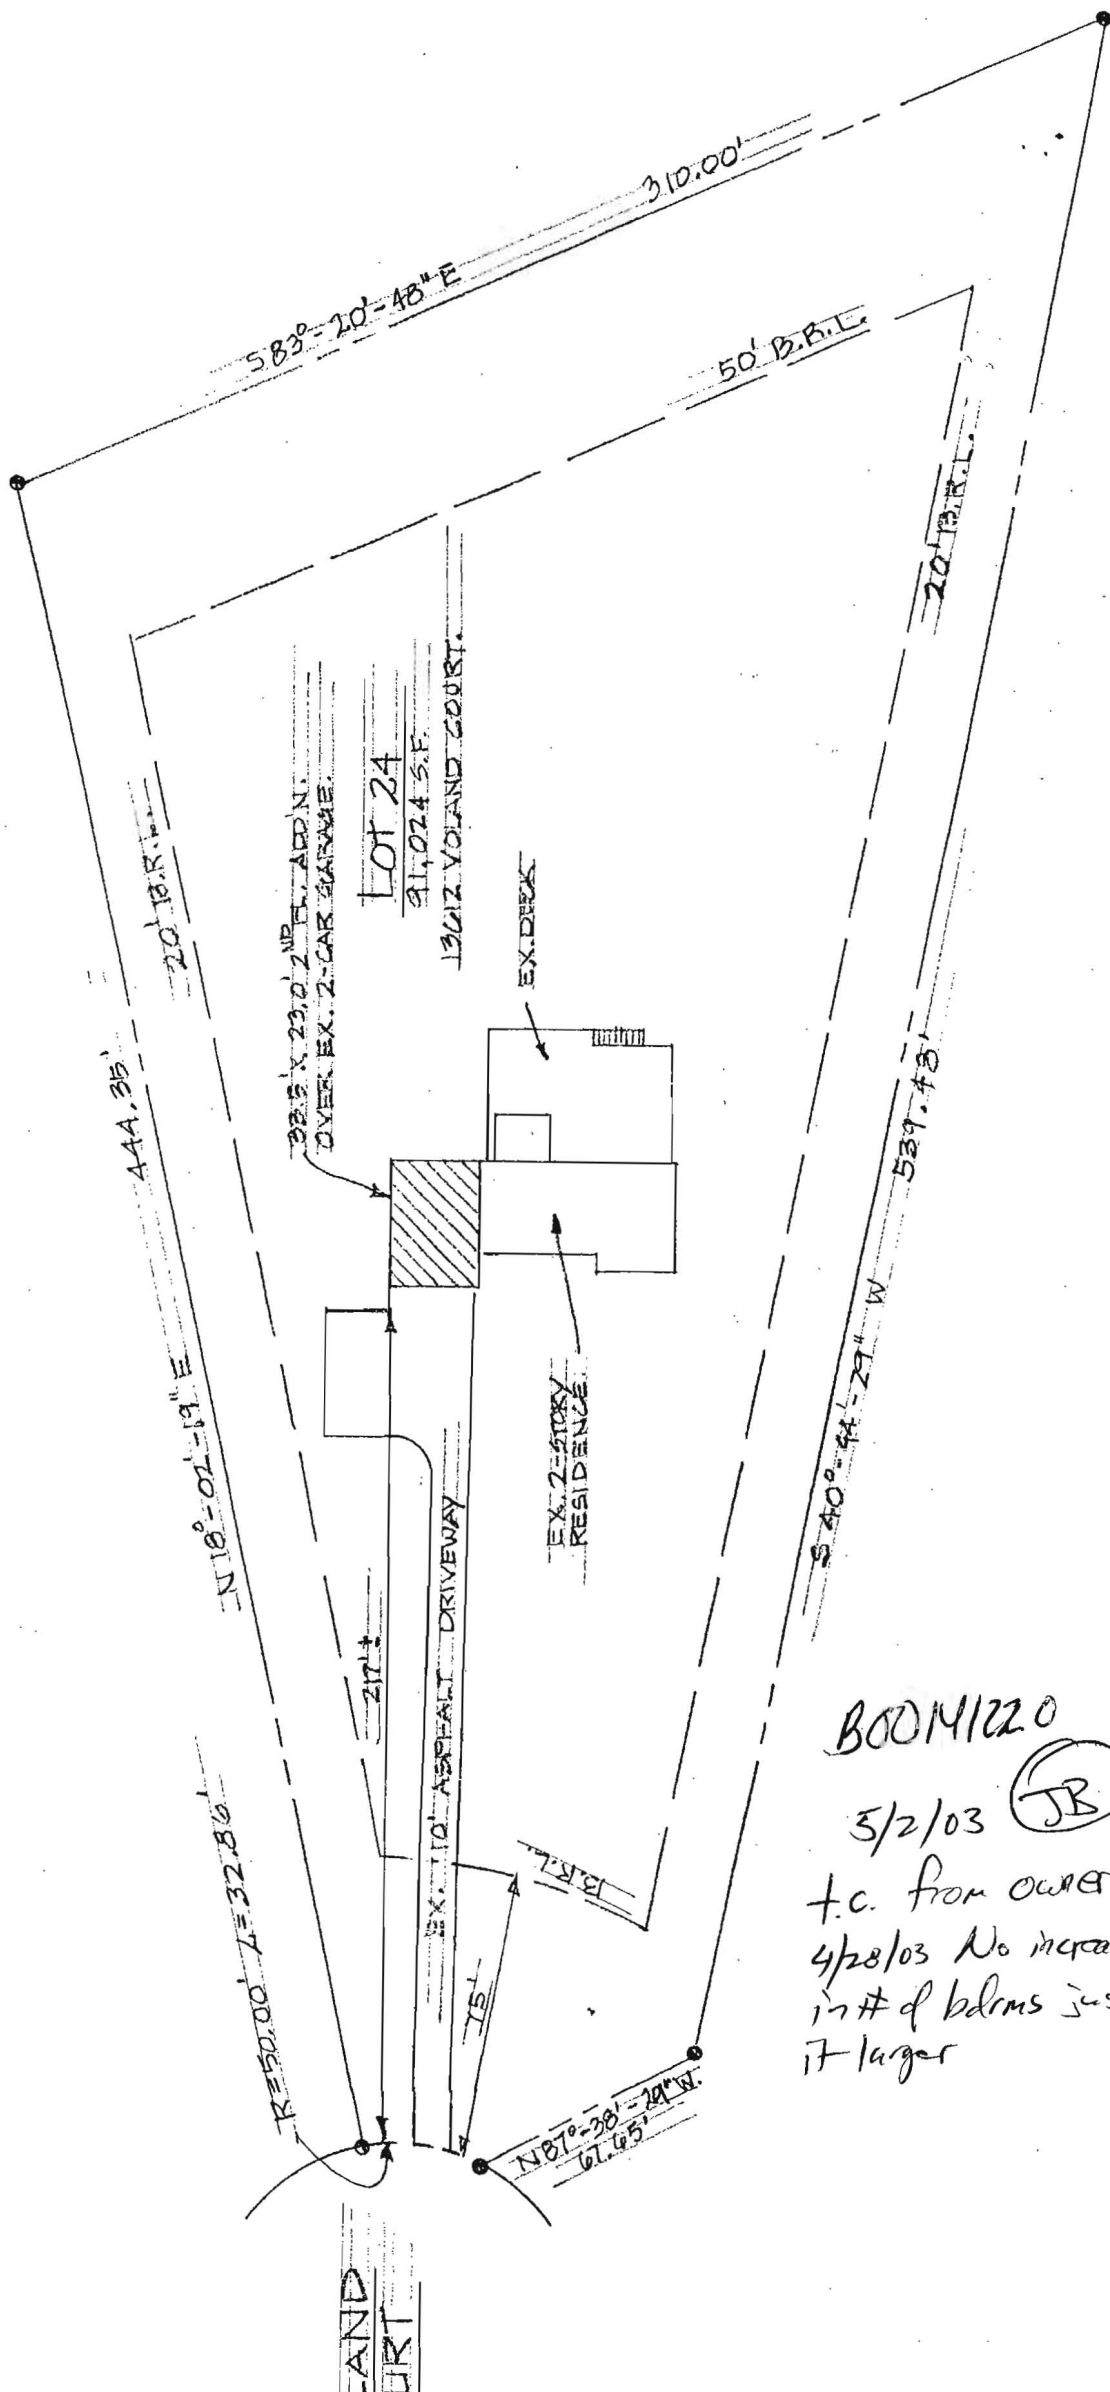

BOON/1220

5/2/03 (JB)

t.c. from owner on
4/28/03 No increase
in # of bdms just making
it larger

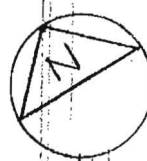

SITE PLAN

1" = 50.0'