

APPLICATION

SEWAGE DISPOSAL TESTING

STATE OF MARYLAND - DEPARTMENT OF HEALTH AND MENTAL HYGIENE

HOWARD COUNTY HEALTH DEPARTMENT
ENVIRONMENTAL HEALTH SERVICES

P. O. BOX 475, ELLICOTT CITY, MARYLAND 21043
TELEPHONE: 443-2000, EXT. 322

S.T. 3-1000
4-1650

DISTRICT 1

DATE 7/1/72

Begin the trenches at a point 12' in from the 534' lot line and 200' from the 310' lot line. The trenches will be dug 2' wide, 10' deep and contain 5' of water. No trench will exceed 100' in length and the trenches will be spaced 15' apart, center-to-center. There will have less than 170' of side wall for. measured along 1 side of the trench.

TO: THE COUNTY HEALTH OFFICER
ELLICOTT CITY, MARYLAND

2 inspections

R. M. 2/1/72

I, HEREBY, APPLY FOR THE NECESSARY TEST IN ORDER TO CONSTRUCT (OR RECONSTRUCT) A SEWAGE DISPOSAL SYSTEM.

PROPERTY OWNER Frank J. Williams & W. at al

Donald J. Johnson, Broker Co., 2100 1st St., Baltimore, MD. PHONE (410) 324-4811

PROPERTY LOCATION

SUBDIVISION Linden Chapel Hills

LOT NO. 21, Block 5

Blk. B

ROAD AND DESCRIPTION off Linden Court

SIZE OF LOT 24,000 sq. ft.

TYPE BLDG. Single

NUMBER OF UNITS
(Single Family, Mobile, etc.)

☐ NOT SINGLE RESIDENCE DWELLING

THE SYSTEM INSTALLED UNDER THIS APPLICATION IS ACCEPTABLE ONLY UNTIL PUBLIC FACILITIES BECOME AVAILABLE.

SIGNATURE OF APPLICANT for Robert Johnson

APPROVED BY R. Morefield

FOR

Trenches

(NAME OF SYSTEM)

DATE

7 June 72

REJECTED BY

FOR

(NAME OF SYSTEM)

DATE


HOLD PENDING FURTHER TESTS

DATE

REASONS FOR REJECTION OR HOLDING

THIS IS NOT A PERMIT

0
5 clay/loam
13 loam

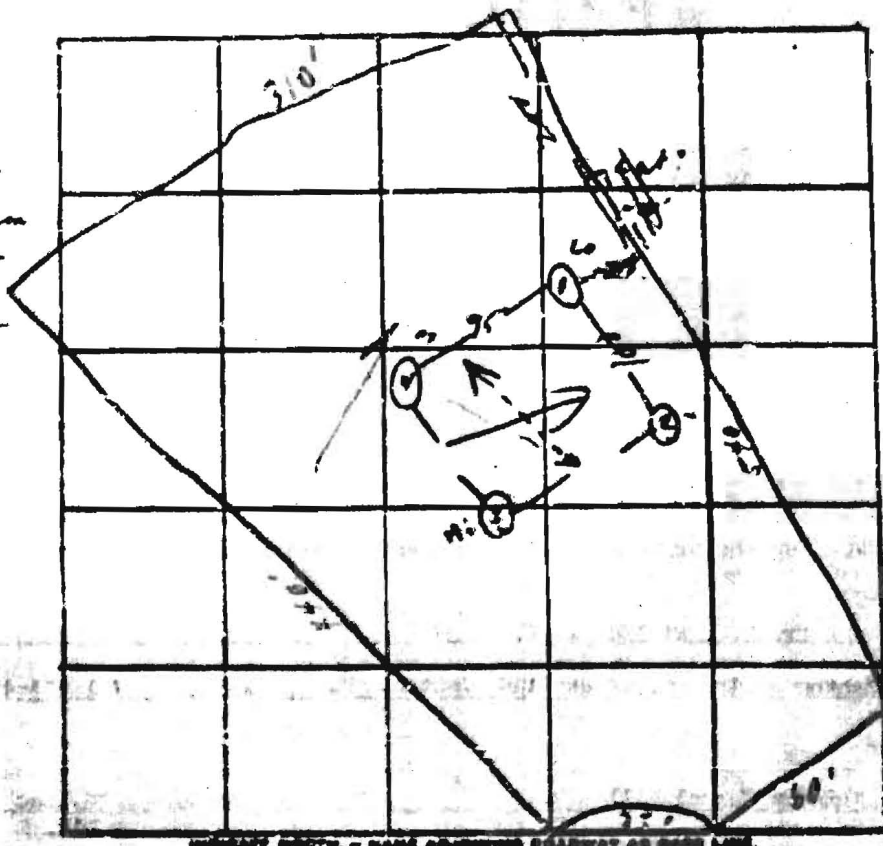

Lot 24 B

DATE	TEST NO.	DEPTH	CONDUCT		TEST - 1" DROP		TIME
			START	STOP	START	STOP	
3/4/76	1	5	10:45	10:49	10:49	10:55	6
	2	13	10:45	10:52	10:52	11:05	13
	2	6 1/2	10:50	10:55	10:55	11:00	5
	2A	13	10:52	10:57	10:57	11:03	6
	3	5	11:05	11:10	11:10	11:12	2
	3A	12 1/2	11:05	11:11	11:11	11:19	8
	4	12	Valid		2nd		
						6	40

Valid
Work
Time
max. dist
11/11

REMARKS

TYPE OF SOIL

TESTED BY

Rm, CBS

ALSO PRESENT

Frost