

5/7/03 2:30

PUB. SEWER STATUS VERIFIED BY SRK NAISSUE DATE: 4/9/2003P 518620 - AAPPROVAL DATE: 5/9/03A REPAIR**PERMIT****INDEXED**

**ON-SITE SEWAGE DISPOSAL SYSTEM  
HOWARD COUNTY HEALTH DEPARTMENT  
BUREAU OF ENVIRONMENTAL HEALTH**

**03-298930**Hatfield's SepticIS PERMITTED TO INSTALL ☐ ALTER ☒ADDRESS: 13785 Burntwoods Road PHONE NUMBER: 301-854-6172SUBDIVISION: Burntwood LOT NUMBER: 5ADDRESS: 3301 Roscommon Drive PROPERTY OWNER: Stephanie SoekenSEPTIC TANK CAPACITY (GALLONS): Ex 1000PUMP CHAMBER CAPACITY (GALLONS):           NUMBER OF BEDROOMS: 3SQUARE FEET PER BEDROOM: 180LINEAR FEET OF TRENCH REQUIRED:           

TRENCHES:	Trench to be <u>5</u> feet wide. Inlet <u>5</u> feet below original grade. Bottom maximum depth <u>17</u> feet below original grade. Effective area begins at <u>9</u> feet below original grade. <u>9</u> feet of stone below distribution pipe.
LOCATION:	Drywell hole to be 15 x 15 x 13 Deep. All stone, no block or cast tank
PURPOSE:	Septic system has failed. Call for inspection when ground is opened so sanitarian can recommend repair.

PLANS APPROVED: [Signature]DATE: 4/25/03

NOTE: PERMIT VOID AFTER 2 YEARS

NOTE: CONTRACTOR RESPONSIBLE FOR SCHEDULING A PRE-CONSTRUCTION INSPECTION FOR ALL INSTALLATIONS

NOTE: WATERTIGHT SEPTIC TANKS REQUIRED

NOTE: ALL PARTS OF SEPTIC SYSTEM SHALL BE 100 FEET FROM ANY WATER WELL

NOTE: MANHOLE RISERS REQUIRED ON ALL SEPTIC TANKS AND PUMP CHAMBERS


**NEITHER THE HOWARD COUNTY COUNCIL NOR THE HEALTH DEPARTMENT IS  
RESPONSIBLE FOR THE SUCCESSFUL OPERATION OF ANY SYSTEM  
PERMITTEE RESPONSIBLE FOR OBTAINING FINAL APPROVAL ON THIS PERMIT  
CALL 410-313-2640 FOR INSPECTION OF SEPTIC SYSTEM**

**BUILDING PERMIT SIGNED  
AND RETURNED**

10/31/07 B07004464- Deck-24x24

P 518620-A

NOT TO SCALE

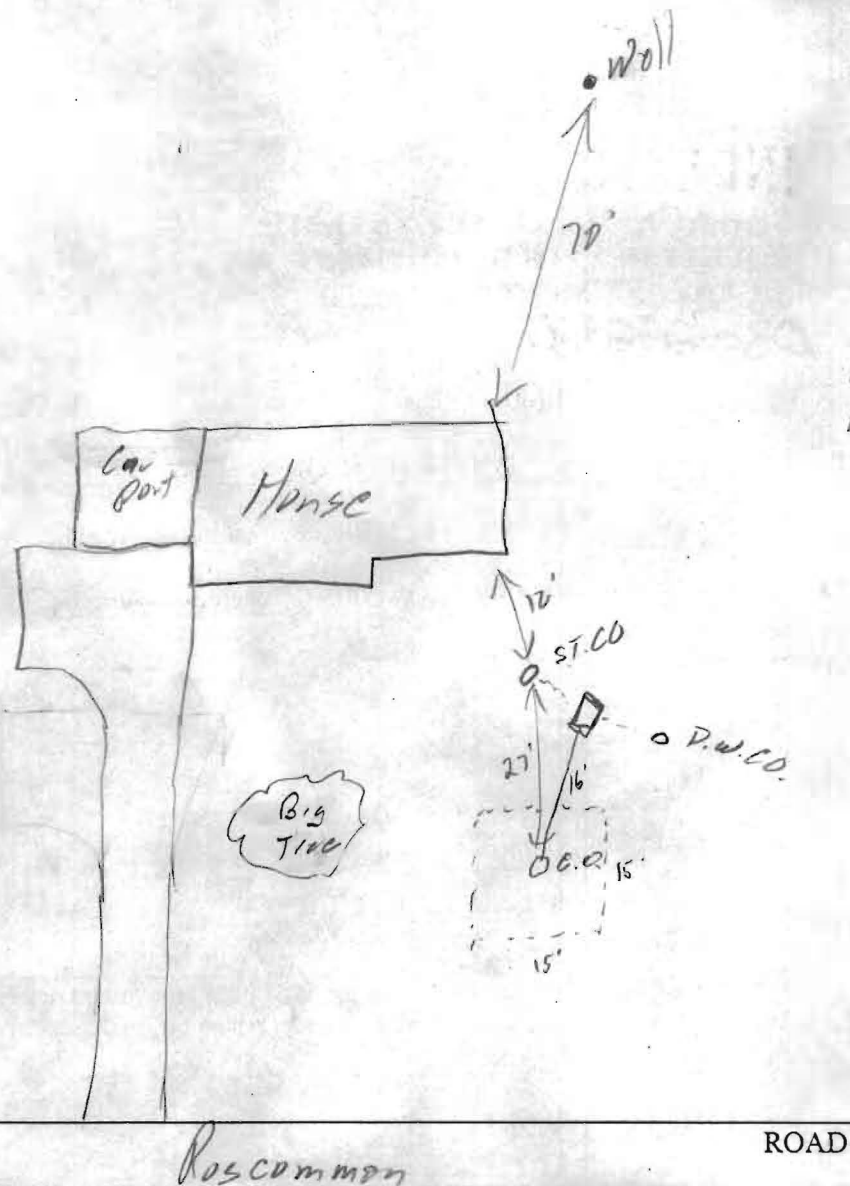

TRENCH/DRAINFIELD DATA		
WIDTH	INLET	BOTTOM
15' x 15'	4'	13'
NUMBER OF TRENCHES _____		
TOTAL LENGTH _____		
ABSORPTION AREA _____		
DISTRIBUTION BOX LEVEL _____		
DISTRIBUTION BOX BAFFLE _____		
DISTRIBUTION BOX PORT _____		

SEPTIC TANK DATA	
SEPTIC TANK 1 LEVEL _____	
CAPACITY	_____ GAL
SEAM LOC	_____
TANK LID DEPTH	_____
BAFFLES	_____
BAFFLE FILTER	_____
MANHOLE LOC	_____
6" PORT LOC	_____
WATERTIGHT TEST	_____
SEPTIC TANK 2 LEVEL _____	
CAPACITY	_____ GAL
SEAM LOC	_____
TANK LID DEPTH	_____
BAFFLES	_____
BAFFLE FILTER	_____
MANHOLE LOC	_____
6" PORT LOC	_____
WATERTIGHT TEST	_____

PRE-CONSTRUCTION 4/17/03 See Repair Proc Sheet

INSTALLATION 5/7/03 D.B. install between ST & D.W. Digging hole for new D.W. (SQ) 5/8/03 OK to cover all work (SQ)

Used 91 ton of stone

FINAL INSPECTOR [Signature] DATE OF APPROVAL 5/8/03