

# PERMIT

SEWAGE DISPOSAL SYSTEM

MARYLAND STATE DEPARTMENT OF HEALTH

HOWARD COUNTY

ELLICOTT CITY

DISTRICT 3

DATE 12/5/62

INDEXED



Robert Rubin Co. IS PERMITTED TO INSTALL 1 ALTER

ADDRESS 25 E. Rockville Rd. PHONE 281-3015

A SEWAGE DISPOSAL SYSTEM LOCATED AT \_\_\_\_\_

SUBDIVISION Burnt Wood ROAD Rockwood Dr. LOT 5, Blk. 2,

PROPERTY OWNER Burnt Wood Development Co., Inc. Pgs. 2, Pg. 1

ADDRESS \_\_\_\_\_

SPECIFICATIONS 3 bedrooms

DRAIN FIELD \_\_\_\_\_ DEPTH \_\_\_\_\_ FEET, BOTTOM AREA \_\_\_\_\_ SQ. FT.

SEWAGE PITS \_\_\_\_\_ ABSORBENT SIDE-WALL AREA \_\_\_\_\_ SQ. FT.

SEPTIC TANK CAPACITY \_\_\_\_\_ GALLONS

FOR GARBAGE GRINDER, INCREASE DISPOSAL AREA 25% & TANK CAPACITY 50%.

OTHER dry well - 100 sq. ft. absorbent side-wall area per bedroom.

Locate dry well 35 ft. from front lot line and 20 ft. from right side line

as lot is seen when facing it from Street "B" Rockwood Dr. Max. depth 12'

below original grade.

PERMIT VALID AFTER SIXTY YEARS.


PLANS APPROVED BY Hughes, Fletcher DATE 9/25/66

FILL SEPTIC TANK AND DISTRIBUTION BOX WITH WATER BEFORE CALLING FOR AN INSPECTION. COVER NO WORK UNTIL INSPECTED AND APPROVED.

NEITHER THE HOWARD COUNTY COMMISSIONERS NOR THE HEALTH DEPARTMENT IS RESPONSIBLE FOR THE SUCCESSFUL OPERATION OF ANY SYSTEM.

**NOTIFY THE HEALTH DEPARTMENT 48 HOURS  
BEFORE EXCAVATIONS ARE TO BE BACK FILLED.**

*L. 0896*

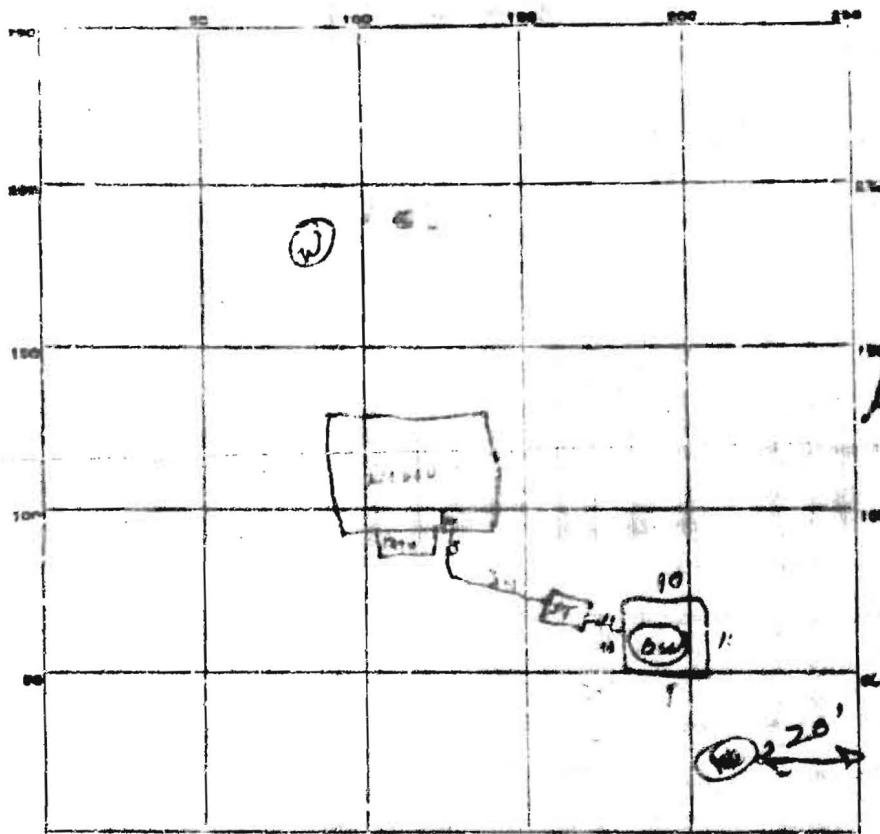

INDICATE NORTH - NAME ADJOINING ROADWAY AS BEAR LINE.

*Racoon Run*

PERMIT CARD                      *OK*

SEPTIC TANK, LEVEL                      *OK*

CLEANOUTS                      *OK*

DISTRIBUTION BOX, LEVEL                     

TILE FIELD, DEPTH                      FT. TRENCH WIDTH                      FT.

GRAVEL DEPTH                      IN. TOTAL LENGTH                      FT.

NUMBER OF TRENCHES                     

TOTAL BOTTOM AREA                     

SEEPAGE PITS, INCHES                      *Permit* 41

DEPTH BELOW PILET 8 1/2 FT.

ABSORBENT AREA 348 + sq

REMARKS                     

*A# 08796*

*9/15/64 DW. in area tested (142) 4 in at 10 ft, 3 in at 5 ft.*

*(344) 6 in at 10 ft, 5 in at 5 ft - 142 26 ft per foot out 155 ft per foot*

*Don*

DATE

*7/1/69*

INSPECTOR

*du Morgan*