

APPLICATION

SEWAGE DISPOSAL TESTING

MARYLAND STATE DEPARTMENT OF HEALTH

HOWARD COUNTY

ELLCOTT CITY

DISTRICT

DATE 10/1/66

Well - 400 soft sediment
area below the inlet with a
maximum depth of 13 below o.g.
Place the well 50 ft to 80 ft from
the line which runs along the vent &
and 135 ft to the 15 ft vent &
I, HEREBY, APPLY FOR THE NECESSARY TESTS IN ORDER TO CONSTRUCT A SEWAGE
DISPOSAL SYSTEM.

PROPERTY OWNER

ADDRESS Dayton, Maryland

PROPERTY LOCATION

SUBDIVISION

ROAD AND DESCRIPTION Ten Oaks Rd - 1/2 mile from Dayton toward Glenelig
go to Mr. Hill's home - he'll show you where

OCCUPANT

PERSON TO CONSTRUCT SYSTEM

ADDRESS

SIZE OF LOT

APPROX.

5.5 acres

TYPE BLDG.

IF NOT SINGLE RESIDENCE DESCRIBE

NUMBER OF RESIDENCES
(Single Family D)

SIGNATURE OF APPLICANT

APPROVED BY

FOR

DATE

REJECTED BY

FOR


DATE

HOLD PENDING FURTHER TESTS

DATE

REASONS FOR REJECTION OR HOLDING

THIS IS NOT A DEDMIT

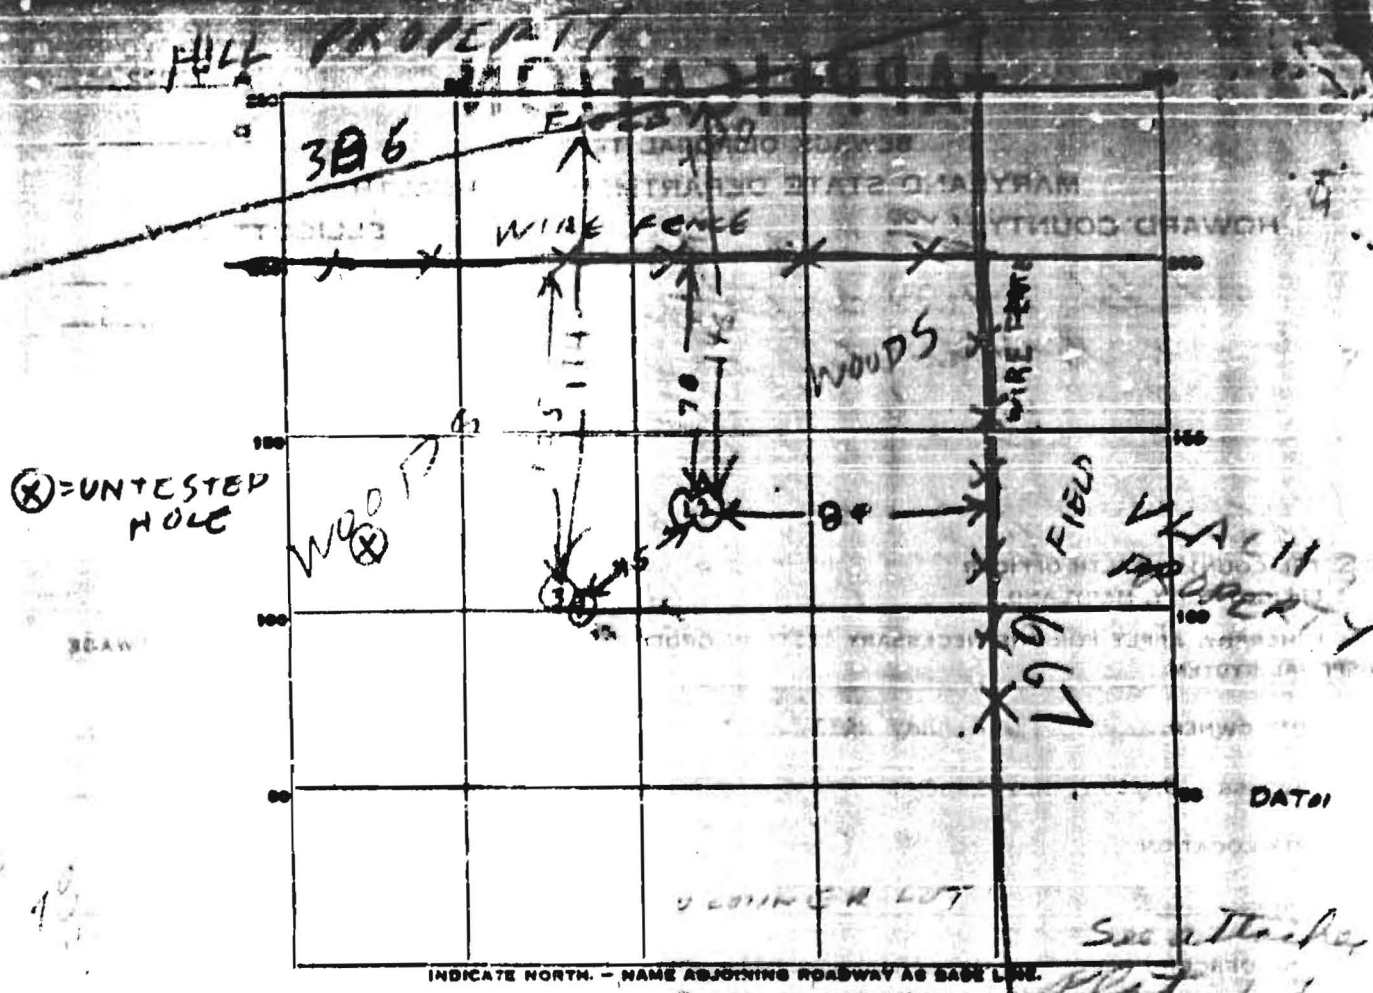

DATE	TEST NO.	DEPTH	PRE-WET		TEST - 1" DROP		TIME
			START	STOP	START	STOP	
10/11/66	1	5	1002	1003	1003	1004	1
10/11/66	2	9	1008	1011	1011	1017	6
10/11/66	3	5 1/2	1022	1023	1023	1024	1
10/11/66	4	9	1031	1038	1038	1055	17

SOIL AUGER FINDING 20 June 67 - Property stake of 8 Hole location

TESTED BY B. Hodges See attached report

Probable 1st hole all. That must be