

4/24/72
8/24/72

INDEXED

Find
CRJ.

PERMIT

SEWAGE DISPOSAL SYSTEM

MARYLAND STATE DEPARTMENT OF HEALTH

HOWARD COUNTY

ELLICOTT CITY

DISTRICT 5

DATE 1/24/72

P 14449

A 14343

Sonder Builders, Inc.

IS PERMITTED TO INSTALL X ALTER

ADDRESS 10707 Sconestville Road, Laurel, Md.

PHONE 732-2292

A SEWAGE DISPOSAL SYSTEM LOCATED AT

SUBDIVISION

ROAD Ten Oaks Rd. - 1/4

LOT

mile from Dayton toward Glenely - back in woods

PROPERTY OWNER Walter D. Squires

ADDRESS

SPECIFICATIONS - 3 bedrooms

DRAIN FIELD DEPTH FEET, BOTTOM AREA SQ. FT.

SEEPAGE PITS ABSORBENT SIDE-WALL AREA SQ. FT.

SEPTIC TANK CAPACITY 1,000 GALLONS

FOR GARBAGE GRINDER, INCREASE DISPOSAL AREA 22% & TANK CAPACITY 50%.

OTHER Dry well 300 sq. ft. absorption area, below the inlet. Inlet to be

54 ft. below original grade and maximum depth of dry well to be 104 ft. Locate

dry well 143 ft. from right property line and 134 ft. from back right corner line.

NOTE: INSTALL STAND PIPE ON SEPTIC TANKS AND DRY WELL.

PERMIT VOID AFTER THREE YEARS.

NOTE: ALL PIPE FROM HOUSE TO SEPTIC TANK MUST BE CAST IRON.


PLANS APPROVED BY C. Stricker

DATE 10/6/71

FILL SEPTIC TANK AND DISTRIBUTION BOX WITH WATER BEFORE CALLING FOR AN INSPECTION. COVER NO WORK UNTIL INSPECTED AND APPROVED

NEITHER THE HOWARD COUNTY COMMISSIONERS NOR THE HEALTH DEPARTMENT IS RESPONSIBLE FOR THE SUCCESSFUL OPERATION OF ANY SYSTEM

1637

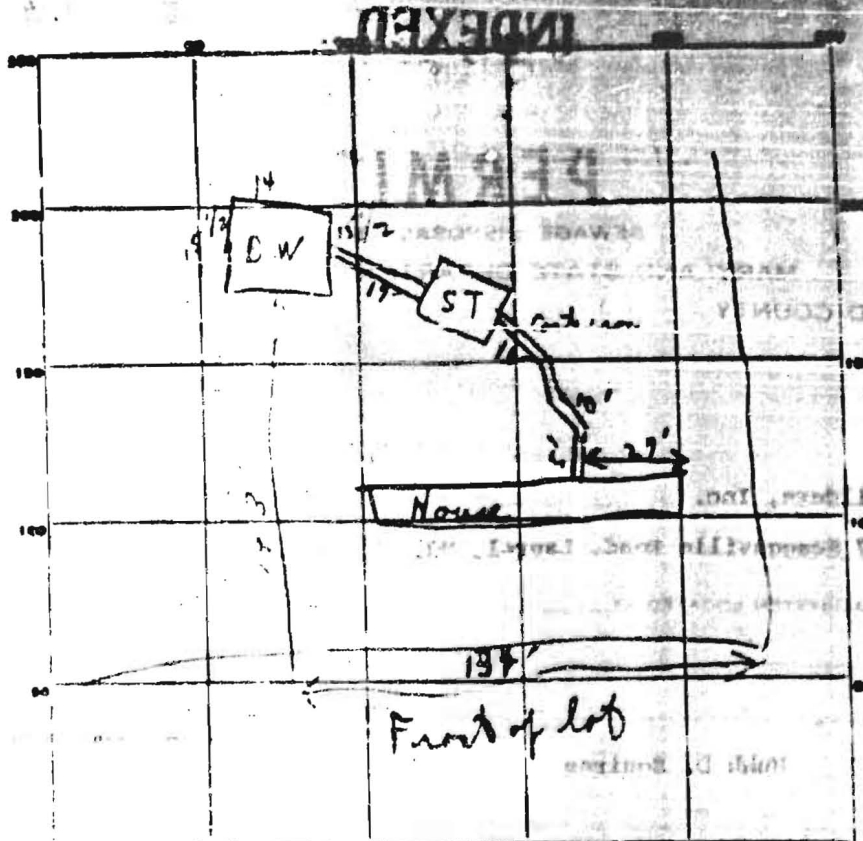

PERMIT CARD Superior - no sign card at 8/24/72 inspection CBK

SEPTIC TANK, LEVEL 25 CLEANOUTS 25

DISTRIBUTION BOX, LEVEL

TILE FIELD, DEPTH FT. TRENCH WIDTH FT.

GRAVEL DEPTH IN. TOTAL LENGTH FT.

NUMBER OF TRENCHES TOTAL BOTTOM AREA 5' 9"

SEEPAGE PITS, INSIDE DIAMETER 5' 9" FT. DEPTH BELOW INLET 5' 9" FT. 5' 9"

ABSORBENT AREA 335 SQ. FT. 2' 30"

REMARKS Initial 8/26/72 removed out to 10' gravel. Septic Tank 25' c.
8/24/72 Need to open area where pipe enters sept.
tank for inspection. Before fence CBK 8/24/72 called
Engen Warden and he stated this cost sign pipe
connected from septic tank to house. CBK.

DATE SYSTEM APPROVED 8/24/72 INSPECTOR C. H. Trecker