

1-21-03 11 Am repair per 4/28/03 - 3pm

PUB. SEWER STATUS VERIFIED BY mlb

ISSUE DATE: _____

APPROVAL DATE: 4/28/03

PERMIT

INDEXED

05-414792

**ON-SITE SEWAGE DISPOSAL SYSTEM
HOWARD COUNTY HEALTH DEPARTMENT
BUREAU OF ENVIRONMENTAL HEALTH**

P 518639-A

A REPAIR

Jack Fyock

Fogles Septic Clean, Inc

IS PERMITTED TO INSTALL ☐ ALTER ☒

ADDRESS: 580 Obrecht Road, Sykesville

PHONE NUMBER: 410-795-5670

SUBDIVISION: Brierly

LOT NUMBER: 18

ADDRESS: 13800 Russell Zepp Drive

PROPERTY OWNER: Joseph Ribero

SEPTIC TANK CAPACITY (GALLONS): ADD 500

PUMP CHAMBER CAPACITY (GALLONS): N/A

NUMBER OF BEDROOMS: 5

SQUARE FEET PER BEDROOM: 180

LINEAR FEET OF TRENCH REQUIRED: 150 - 2-75

TRENCHES:	Trench to be 3 feet wide. Inlet 4 feet below original grade. Bottom maximum depth 7 feet below original grade. Effective area begins at 4 feet below original grade. 3 feet of stone below distribution pipe.
LOCATION:	<u>Install 500 gallon tank behind existing 1100. Place d-box behind new 500 gallon tank. Maintain 9' edge to edge trench separation.</u>
PURPOSE:	<u>Existing septic system has failed. Call for inspection when ground is opened so sanitarian can recommend repair. To support addition to become a 5 bedroom residence</u>

PLANS APPROVED: JB Kacie Noonan

DATE: 4/28/03

NOTE: PERMIT VOID AFTER 2 YEARS

NOTE: CONTRACTOR RESPONSIBLE FOR SCHEDULING A PRE-CONSTRUCTION INSPECTION FOR ALL INSTALLATIONS

NOTE: WATERTIGHT SEPTIC TANKS REQUIRED

NOTE: ALL PARTS OF SEPTIC SYSTEM SHALL BE 100 FEET FROM ANY WATER WELL

NOTE: MANHOLE RISERS REQUIRED ON ALL SEPTIC TANKS AND PUMP CHAMBERS

**NEITHER THE HOWARD COUNTY COUNCIL NOR THE HEALTH DEPARTMENT IS
RESPONSIBLE FOR THE SUCCESSFUL OPERATION OF ANY SYSTEM
PERMITTEE RESPONSIBLE FOR OBTAINING FINAL APPROVAL ON THIS PERMIT
CALL 410-313-2640 FOR INSPECTION OF SEPTIC SYSTEM**


P 518639-A

NOT TO SCALE

TRENCH/DRAINFIELD DATA		
WIDTH	INLET	BOTTOM
<u>2</u>	<u>4 1/2'</u>	<u>7 1/2'</u>
NUMBER OF TRENCHES		<u>2</u>
TOTAL LENGTH		<u>150'</u>
ABSORPTION AREA		
DISTRIBUTION BOX LEVEL		<u>yes</u>
DISTRIBUTION BOX BAFFLE		
DISTRIBUTION BOX PORT		

SEPTIC TANK DATA	
SEPTIC TANK 1 LEVEL	<u>yes</u>
CAPACITY	<u>500</u> GAL
SEAM LOC	<u>TOP</u>
TANK LID DEPTH	<u>2'</u>
BAFFLES	<u>yes</u>
BAFFLE FILTER	<u>No</u>
MANHOLE LOC	<u>Center</u>
6" PORT LOC	
WATERTIGHT TEST	<u>No</u>
SEPTIC TANK 2 LEVEL	<u>N/A</u>
CAPACITY	
SEAM LOC	
TANK LID DEPTH	
BAFFLES	
BAFFLE FILTER	
MANHOLE LOC	
6" PORT LOC	
WATERTIGHT TEST	<u>✓</u>

water tested

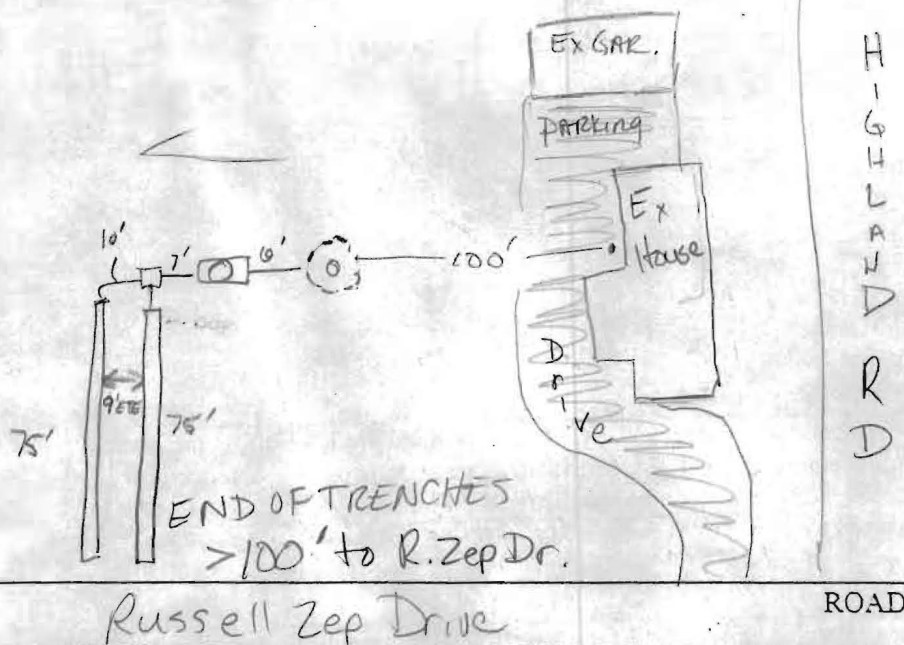

PRE-CONSTRUCTION 4/28/03 System installed per plan (KN)

INSTALLATION 1/21/02 - JB SRK JOHN BORIS EVALUATED SITE, SEE PERC SHEET

FINAL INSPECTOR Kacie Noonan DATE OF APPROVAL 4-28-03