

PUB. SEWER STATUS VERIFIED BY \_\_\_\_\_

ISSUE DATE: \_\_\_\_\_

APPROVAL DATE: \_\_\_\_\_

**PERMIT  
INDEXED**

P 518978-B

A Re-index

**ON-SITE SEWAGE DISPOSAL SYSTEM  
HOWARD COUNTY HEALTH DEPARTMENT  
BUREAU OF ENVIRONMENTAL HEALTH**

06-399495

IS PERMITTED TO INSTALL ☐ ALTER ☒

ADDRESS: \_\_\_\_\_ PHONE NUMBER: \_\_\_\_\_

SUBDIVISION: \_\_\_\_\_ LOT NUMBER: \_\_\_\_\_

ADDRESS: 9454 Vollmerhausen Road PROPERTY OWNER: Richard Douse

SEPTIC TANK CAPACITY (GALLONS): \_\_\_\_\_

PUMP CHAMBER CAPACITY (GALLONS): \_\_\_\_\_

NUMBER OF BEDROOMS: \_\_\_\_\_

SQUARE FEET PER BEDROOM: \_\_\_\_\_

LINEAR FEET OF TRENCH REQUIRED: \_\_\_\_\_

TRENCHES:	Trench to be _____ feet wide. Inlet _____ feet below original grade. Bottom maximum depth _____ feet below original grade. Effective area begins at _____ feet below original grade. _____ feet of stone below distribution pipe.
LOCATION:	
PURPOSE:	

PLANS APPROVED: \_\_\_\_\_ DATE: \_\_\_\_\_

NOTE: PERMIT VOID AFTER 2 YEARS

NOTE: CONTRACTOR RESPONSIBLE FOR SCHEDULING A PRE-CONSTRUCTION INSPECTION FOR ALL INSTALLATIONS

NOTE: WATERTIGHT SEPTIC TANKS REQUIRED

NOTE: ALL PARTS OF SEPTIC SYSTEM SHALL BE 100 FEET FROM ANY WATER WELL

NOTE: MANHOLE RISERS REQUIRED ON ALL SEPTIC TANKS AND PUMP CHAMBERS

**NEITHER THE HOWARD COUNTY COUNCIL NOR THE HEALTH DEPARTMENT IS  
RESPONSIBLE FOR THE SUCCESSFUL OPERATION OF ANY SYSTEM**

**BUILDING PERMIT SIGNED INSURE FOR OBTAINING FINAL APPROVAL ON THIS PERMIT  
AND RETURNED CALL 410-313-2640 FOR INSPECTION OF SEPTIC SYSTEM**

62503 800142561 - SITTING ROOM ADDITION  
42264 8001471634 - SCREENED PORCH

P518978-B

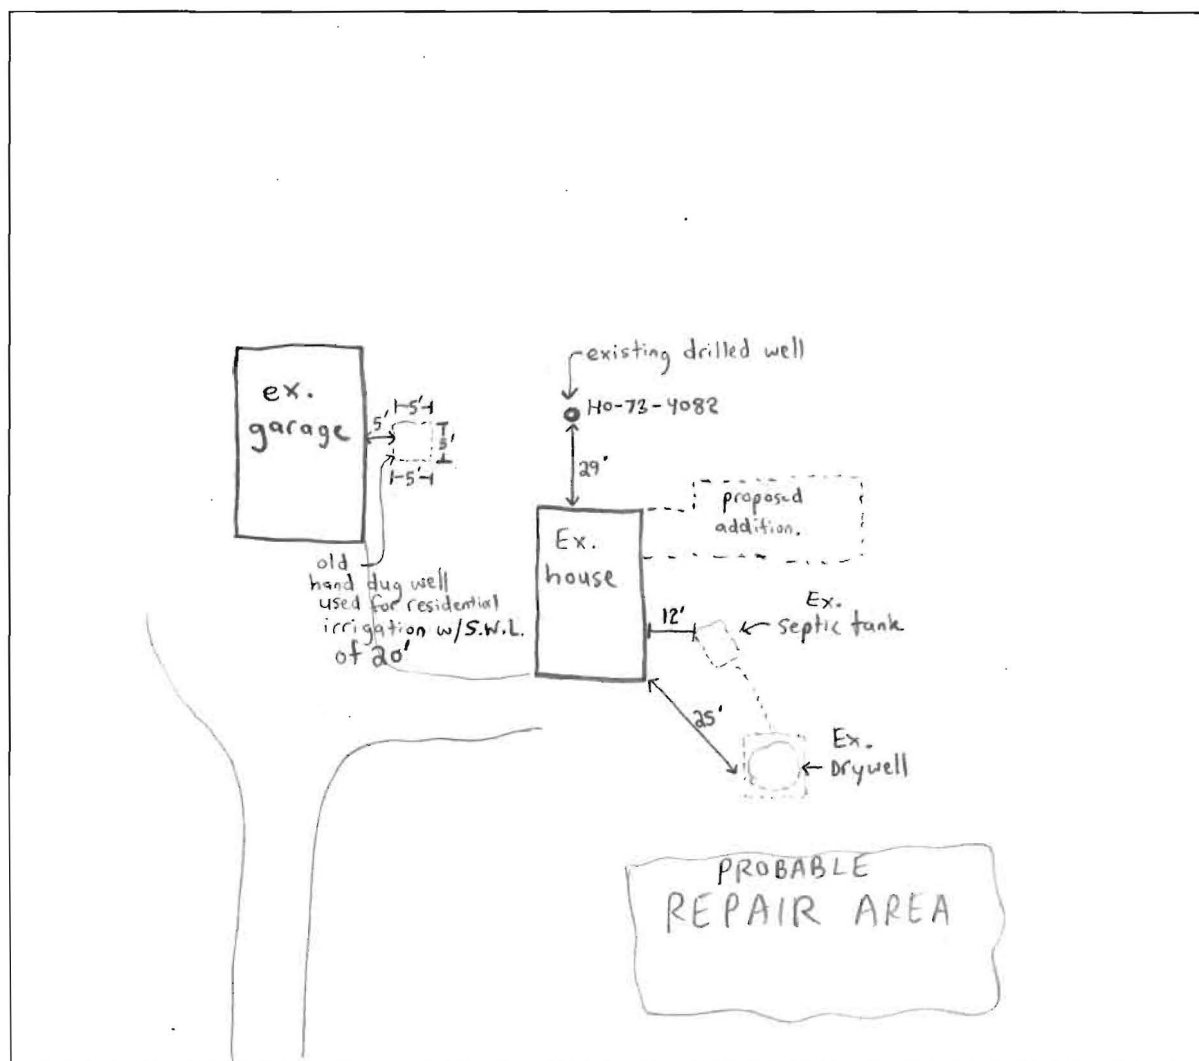
DO

NOT DISCARD

SITE INSPECTION SHEETOWNER: Richard Douse PHONE #: \_\_\_\_\_ADDRESS: 9454 Vollmerhausen Rd CONTRACTOR: \_\_\_\_\_

WELL TAG #: \_\_\_\_\_

SUBDIVISION: \_\_\_\_\_ LOT: \_\_\_\_\_ COUNTY #: \_\_\_\_\_

PROPOSAL: Evaluation of existing septic system for proposed building permit to enlarge living space (No bedrooms)LOCATION DIAGRAM new

COMMENTS: Property is not in the metropolitan district for water or sewer, ex. system is functional. Opened drywell & septic tank, both appear to be in excellent condition despite system age. Drywell has only a few feet of effluent inside. Although suitable repair area exists,

DATE: 6/25/03 INSPECTOR: Steven R. Krieg

↳ property will get hooked up to public water and sewer if ever sold.