


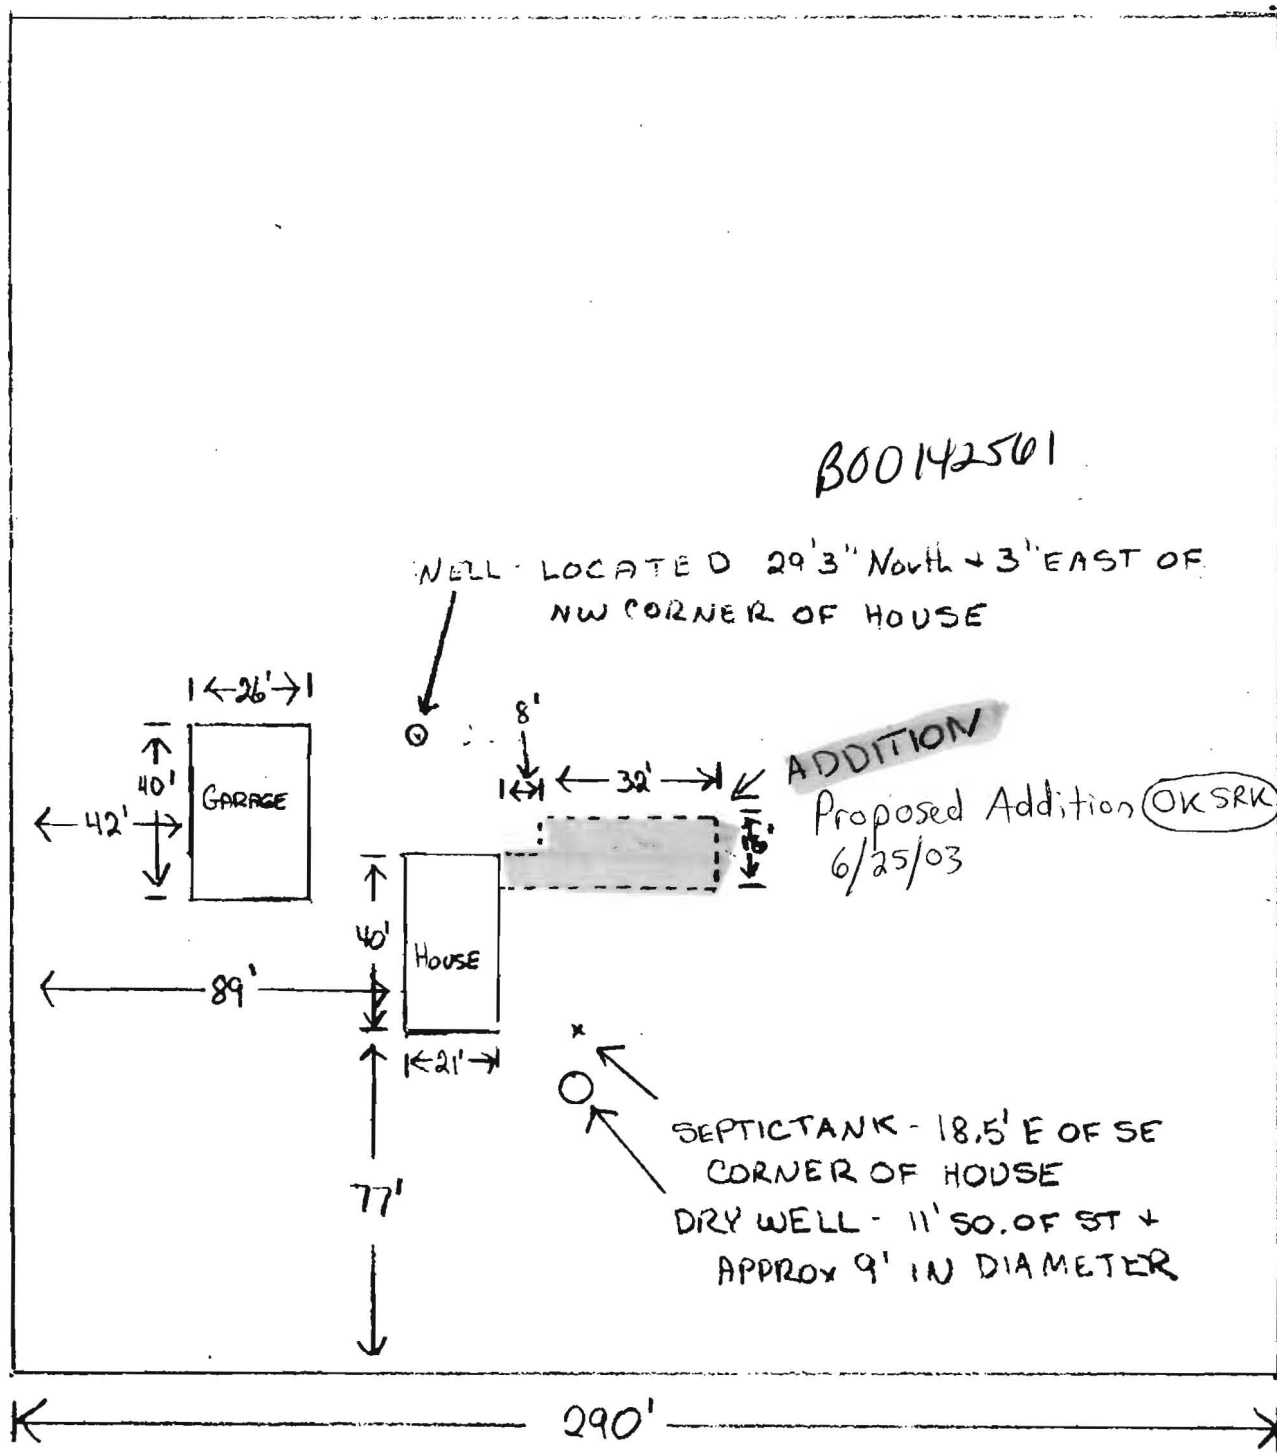

314'  
VOLLMERHAUSEN RD


VOLLMERHAUSEN DR

LOT

9454 VOLLMERHAUSEN DR  
PARCEL 167  
OUT PARCEL OF HUNTINGTON

1"=50' SCALE

Approved by FA on  
4/22/04 for porch  
BP 00/47634

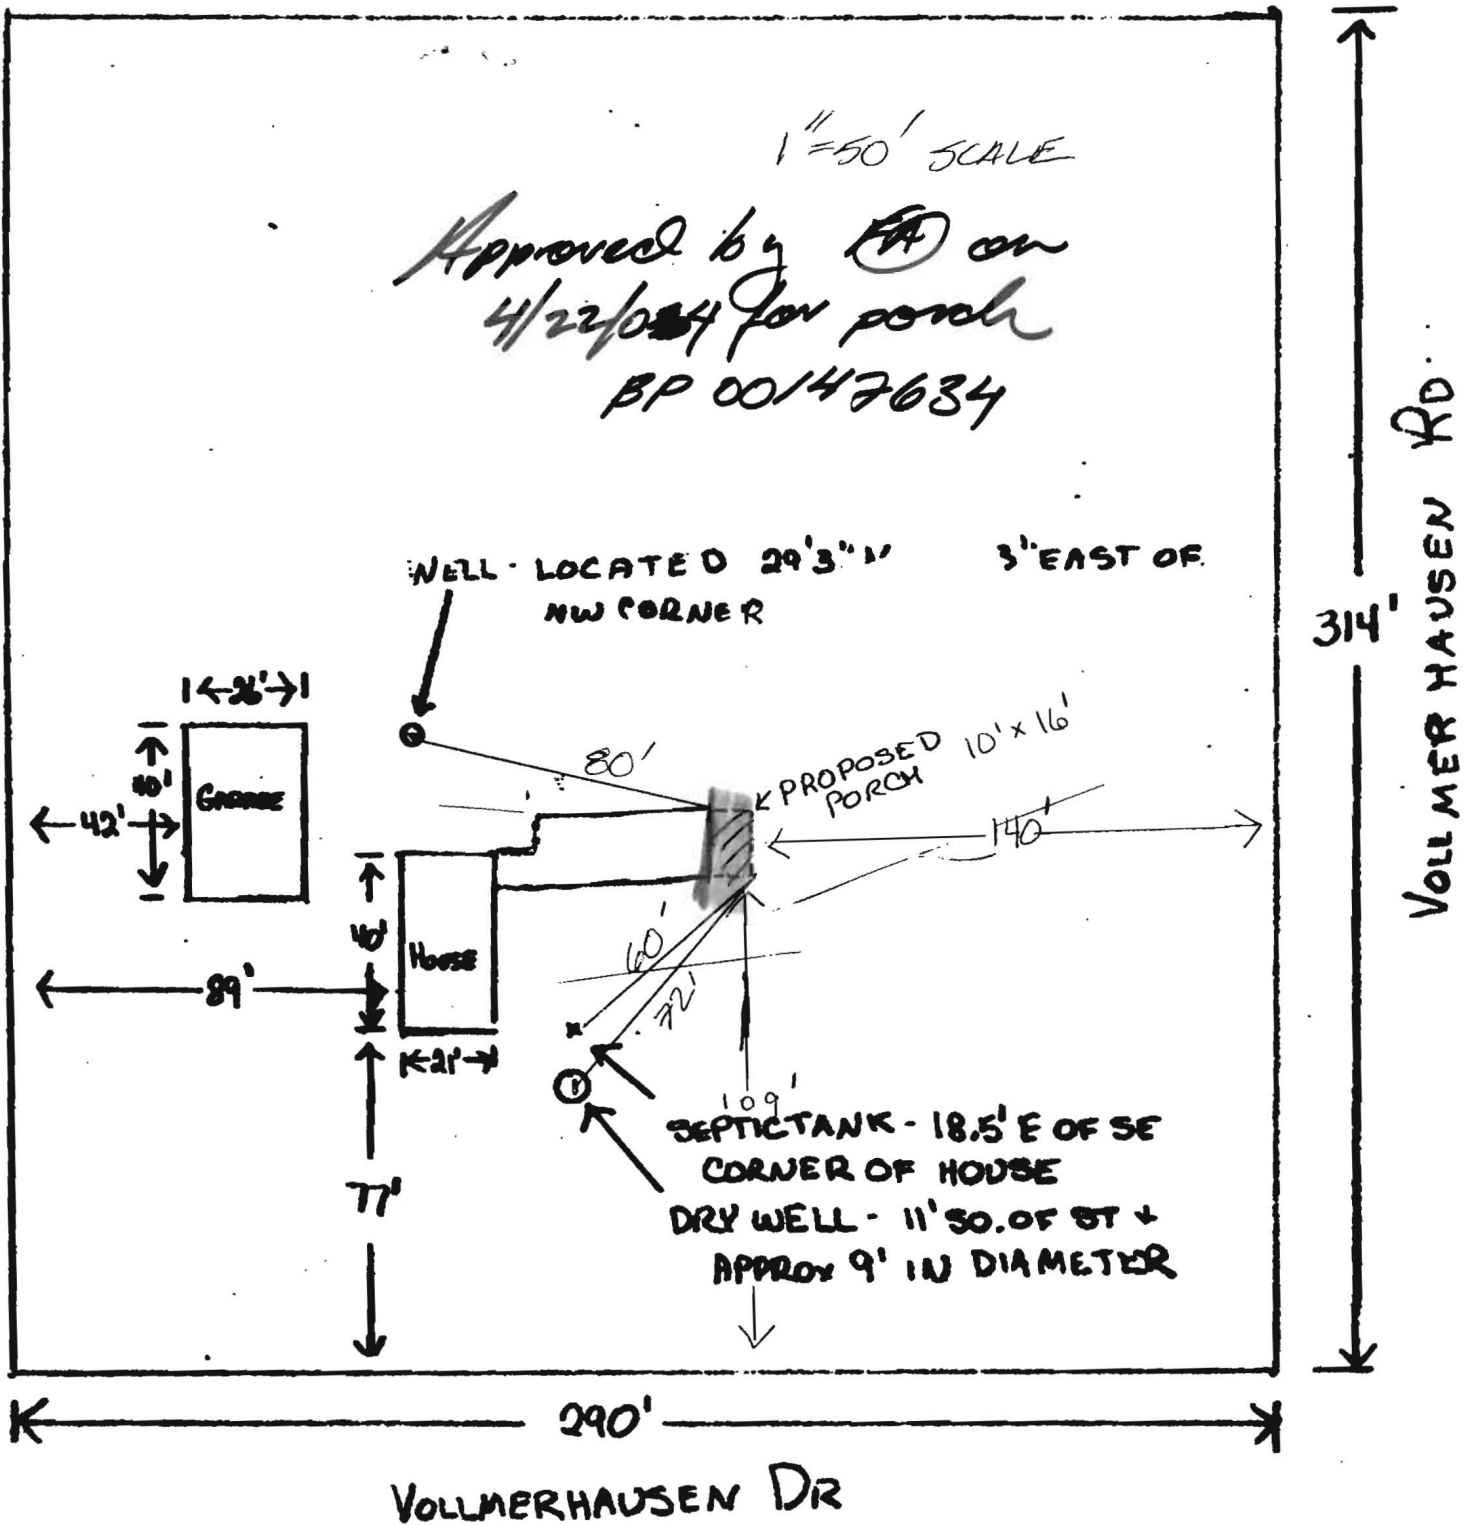

0 10 20 30 40 50  
SCALE

9454 VOLLMERHAUSEN DR  
PARCEL 167  
OUT PARCEL OF HUNTINGTON