

RECORDED

APPLICATION

A 13760

P

SEWAGE DISPOSAL TESTING

MARYLAND STATE DEPARTMENT OF HEALTH

HOWARD COUNTY

750 Gallon Tank

ELICOTT CITY

Dry Well - 300 sq ft sidewalk
also below the inlet

DISTRICT 6

DATE 8/18/65

Place the dry well 12 ft to 32 ft from
the outlet end of the tank and 20 ft to
40 ft from the rear corner of the house
which is farthest from the well

TO THE COUNTY HEALTH OFFICER
ELICOTT CITY, MARYLAND

I, HEREBY, APPLY FOR THE NECESSARY TESTS IN ORDER TO CONSTRUCT OR RECONSTRUCT A SEWAGE
DISPOSAL SYSTEM.

PROPERTY OWNER Richard A. Deane

ADDRESS E. Q. Box 302, Vellmarhaus Rd., Savage, Md.

PROPERTY LOCATION:

SUBDIVISION

ROAD AND DESCRIPTION Vellmarhaus Rd. - cross bridge on about 1 mile & only
house on right hand side - from Laurel end

OCCUPANT

PERSON TO CONSTRUCT SYSTEM

ADDRESS

SIZE OF LOT 2 ACRES TYPE 1-2

IF NOT SINGLE RESIDENCE DESCRIBE

SIGNATURE OF APPLICANT William Taylor


APPROVED BY [Signature] FOR Dry Well DATE 11/18/65

REJECTED BY FOR DATE

HOLD PENDING FURTHER TESTS DATE

REASONS FOR REJECTION OR HOLDING

THIS IS NOT A PERMIT

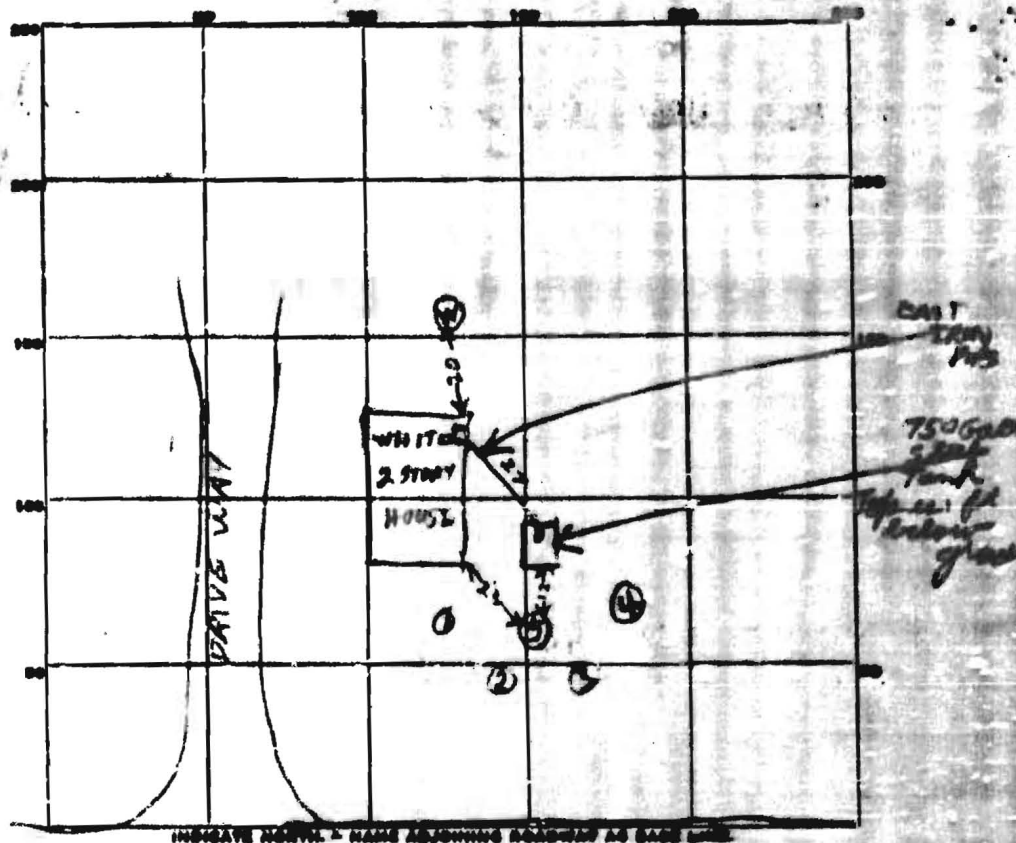

VOLLMEYERHAUSEN

DATE	TEST NO.	DEPTH	PRE-WEY START	STOP	POST-WEY START	STOP	TIME
8/19/65	1	4	954	959	959	1010	11
8/19/65	2	3	952	1028	1028	1055	11
" "	3	3 1/2	957	1055			11
" "	4	3 1/2	958			1034	18
" "	5	7	1011	1014	1017	1017	3

11
18
40
20
4109
27

SOIL AUGER FINDING

TESTED BY

Raymond Hodge

REMARKS