

8/20/65
After 2
if possible

8/24/65 afternoon

PERMIT

SEWAGE DISPOSAL SYSTEM

MARYLAND STATE DEPARTMENT OF HEALTH

HOWARD COUNTY

INDEXED

P 10781

A 10860

ELLCOTT CITY

DISTRICT 6

DATE 8/28/65

Plastic Plumbing & Heating IS PERMITTED TO INSTALL ALTER 2

ADDRESS 2228 Edin Ave., Baltimore, Md. PHONE 78 2-1580

A SEWAGE DISPOSAL SYSTEM LOCATED AT

SUBDIVISION ROAD 9454 Vellmarkman Rd. LOT

PROPERTY OWNER Richard A. House

ADDRESS

SPECIFICATIONS - 3 bedrooms - Repair
DIVIDED APPROXIMATELY
SMT TIME
SEE ALSO A10405

DRAIN FIELD DEPTH FEET, BOTTOM AREA SQ. FT.

SEEPAGE PITS ABSORBENT SIDE-WALL AREA SQ. FT.

SEPTIC TANK CAPACITY 750 GALLONS

FOR GARBAGE GRINDER, INCREASE DISPOSAL AREA 25% & TANK CAPACITY 50%.

OTHER Dry well - 300 sq. ft. sidewall area below the inlet.


Place the dry well 12 ft. to 32 ft. from the outlet end of the tank and 20 ft.

to 40 ft. from the rear corner of the house which is Southwest from the well.

PLANS APPROVED BY Raymond Hedges DATE 8/19/65

FILL SEPTIC TANK AND DISTRIBUTION BOX WITH WATER BEFORE CALLING FOR AN INSPECTION. COVER NO WORK UNTIL INSPECTED AND APPROVED.

NEITHER THE HOWARD COUNTY COMMISSIONERS NOR THE HEALTH DEPARTMENT IS RESPONSIBLE FOR THE SUCCESSFUL OPERATION OF ANY SYSTEM.

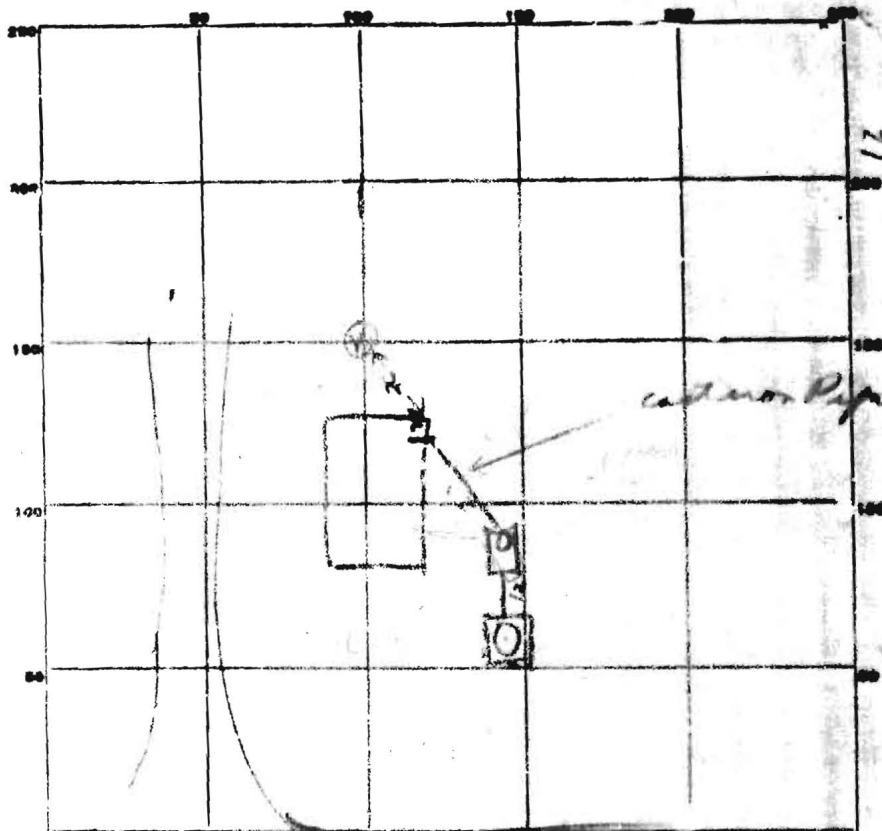

INDICATE NORTH - NAME ADJOINING ROADWAY AS BASE LINE.

VOLLMEYER RD

PERMIT CARD _____

SEPTIC TANK, LEVEL OK steel 7.0
15' below grade
 DISTRIBUTION BOX, LEVEL _____

CLEANOUTS _____

TILE FIELD, DEPTH _____ FT. TRENCH WIDTH _____ FT.

GRAVEL DEPTH _____ IN. TOTAL LENGTH _____ FT.

NUMBER OF TRENCHES _____ TOTAL BOTTOM AREA _____

SEEPAGE PITS, INSIDE DIAMETER 19 FT. DEPTH BELOW INLET 9.5 FT.

APPROXIMATE AREA 295 SQ. FT. country stone
not cherting stone

REMARKS ok to proceed with 1. Dry well 45 ft
15' below grade. Diameter of dry well = 45 ft RH

DATE SYSTEM APPROVED 24 AUG 65

INSPECTOR Raymond Hood

45
 9.5
 295
 45
 285
 145