

# PERMIT

SEWAGE DISPOSAL SYSTEM

MARYLAND STATE DEPARTMENT OF HEALTH

HOWARD COUNTY

ELLICOTT CITY

DISTRICT 5th

DATE 8/13/73

**INDEXED**

Jack Fyock

IS PERMITTED TO INSTALL ☒ ALTER ☐

ADDRESS Ten Oaks Road, Glenelg, Md.

PHONE 286-2939

A SEWAGE DISPOSAL SYSTEM LOCATED AT \_\_\_\_\_

SUBDIVISION \_\_\_\_\_

<sup>14590</sup>  
ROAD Triadelphia mill Rd.

LOT 19

PROPERTY OWNER Edward Lee Wetherell

ADDRESS 10217 Bradley Lane, Ellicott City, Md.

Phone: 531-6156

SPECIFICATIONS 5 bedrooms

DRAIN FIELD \_\_\_\_\_ DEPTH \_\_\_\_\_ FEET, BOTTOM AREA \_\_\_\_\_ SQ. FT.

SEEPAGE PITS \_\_\_\_\_ ABSORBENT SIDE-WALL AREA \_\_\_\_\_ SQ. FT.

SEPTIC TANK CAPACITY 1250 GALLONS

FOR GARBAGE GRINDER, INCREASE DISPOSAL AREA 22% & TANK CAPACITY 50%.

OTHER DRY WELL - 520 sq. ft. absorbent sidewall area to begin below the first  
4 ft. of non-porous soil. Maximum depth permitted for dry well is 11 ft.  
below original grade. Locate dry well 275 ft. from front lot line and 95 ft.  
from right side line as seen from Triadelphia Road.

NOTE: ALL PIPE FROM HOUSE TO DRY WELL MUST BE CAST IRON.

PERMIT VOID AFTER THREE YEARS.

NOTE: INSTALL STAND ~~PIPE~~ PIPE ON SEPTIC TANK AND DRY WELL.


PLANS APPROVED BY Robert V. Torre

DATE 9/8/72

FILL SEPTIC TANK AND DISTRIBUTION BOX WITH WATER BEFORE CALLING FOR AN INSPECTION. COVER NO WORK UNTIL INSPECTED AND APPROVED.

NEITHER THE HOWARD COUNTY COMMISSIONERS NOR THE HEALTH DEPARTMENT IS RESPONSIBLE FOR THE SUCCESSFUL OPERATION OF ANY SYSTEM.

A 16982

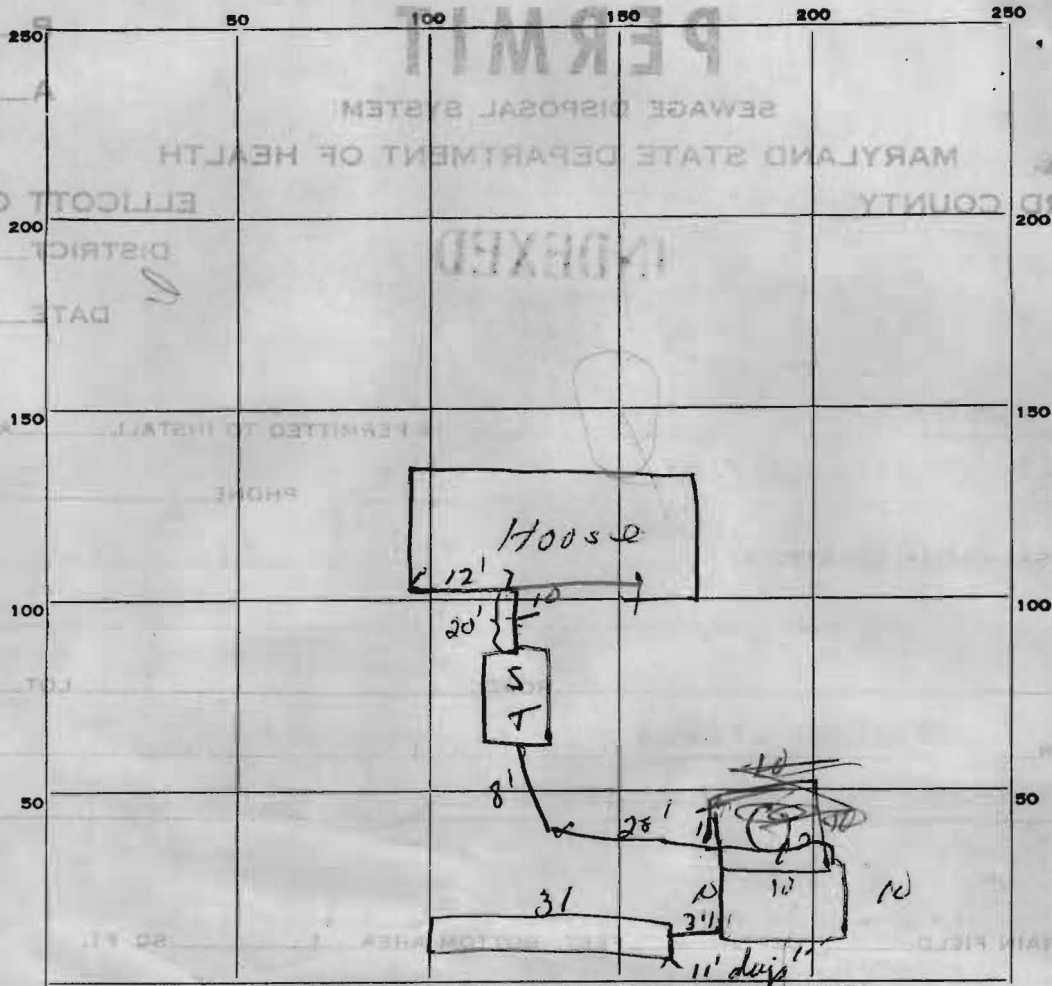

PERMIT CARD OK

SEPTIC TANK, LEVEL OK CLEANOUTS OK

DISTRIBUTION BOX, LEVEL —

TILE FIELD, DEPTH 11 FT. TRENCH WIDTH 2 FT.

GRAVEL DEPTH 8 ft IN. TOTAL LENGTH 31 FT.

NUMBER OF TRENCHES 1 Sidewall TOTAL BOTTOM AREA 248 (one side)

SEEPAGE PITS, INSIDE DIAMETER Permitted 40 FT. DEPTH BELOW INLET 7 FT.

ABSORBENT AREA 280 SQ. FT.

REMARKS 8/27/73 - OK to put gravel in trench  
10' line from tank back to house not in - D.M.

DATE SYSTEM APPROVED 8/27/73 INSPECTOR R. Tane