

APPLICATION

A 16982

P _____

SEWAGE DISPOSAL TESTING

MARYLAND STATE DEPARTMENT OF HEALTH

HOWARD COUNTY

ELLICOTT CITY

DISTRICT FifthDATE 5/1/72

Septic Tank - 1250 gal.
Dry Well - 520 sq. ft. of abradent sidewalk area to begin below the first 4 ft. of non-porous soil. Maximum depth permitted for dry well is 11 ft. below original grade. Locate dry well 275 ft. from front lot line and 95 ft. from right side line as seen from Trisdelphia Rd.

TO: THE COUNTY HEALTH OFFICER
ELLICOTT CITY, MARYLAND

I, HEREBY, APPLY FOR THE NECESSARY TESTS IN ORDER TO CONSTRUCT (OR RECONSTRUCT) A SEWAGE DISPOSAL SYSTEM.

PROPERTY OWNER Edward Lee Wetherell and Eleanor Cecelia WetherellADDRESS 10217 Bradley Lane, Ellicott City, Md. 21043 PHONE 531-6156

PROPERTY LOCATION:

SUBDIVISION Coleman and Lerch, Jr. LOT NO. 19 (nineteen)ROAD AND DESCRIPTION Trisdelphia Mill RoadOCCUPANT Unimproved PHONE NonePERSON TO CONSTRUCT SYSTEM To be determinedADDRESS _____ PHONE Five 5SIZE OF LOT Five (5) acres TYPE BLDG. Four (4)

NUMBER OF BEDROOMS _____

IF NOT SINGLE RESIDENCE DESCRIBE _____

SIGNATURE OF APPLICANT Edward L. WetherellAPPROVED BY Robert V. Tamm FOR Dry Well DATE 7/8/72

(KIND OF SYSTEM)


REJECTED BY _____ FOR _____ DATE _____

(KIND OF SYSTEM)

HOLD PENDING FURTHER TESTS _____ DATE _____

REASONS FOR REJECTION OR HOLDING _____

THIS IS NOT A PERMIT

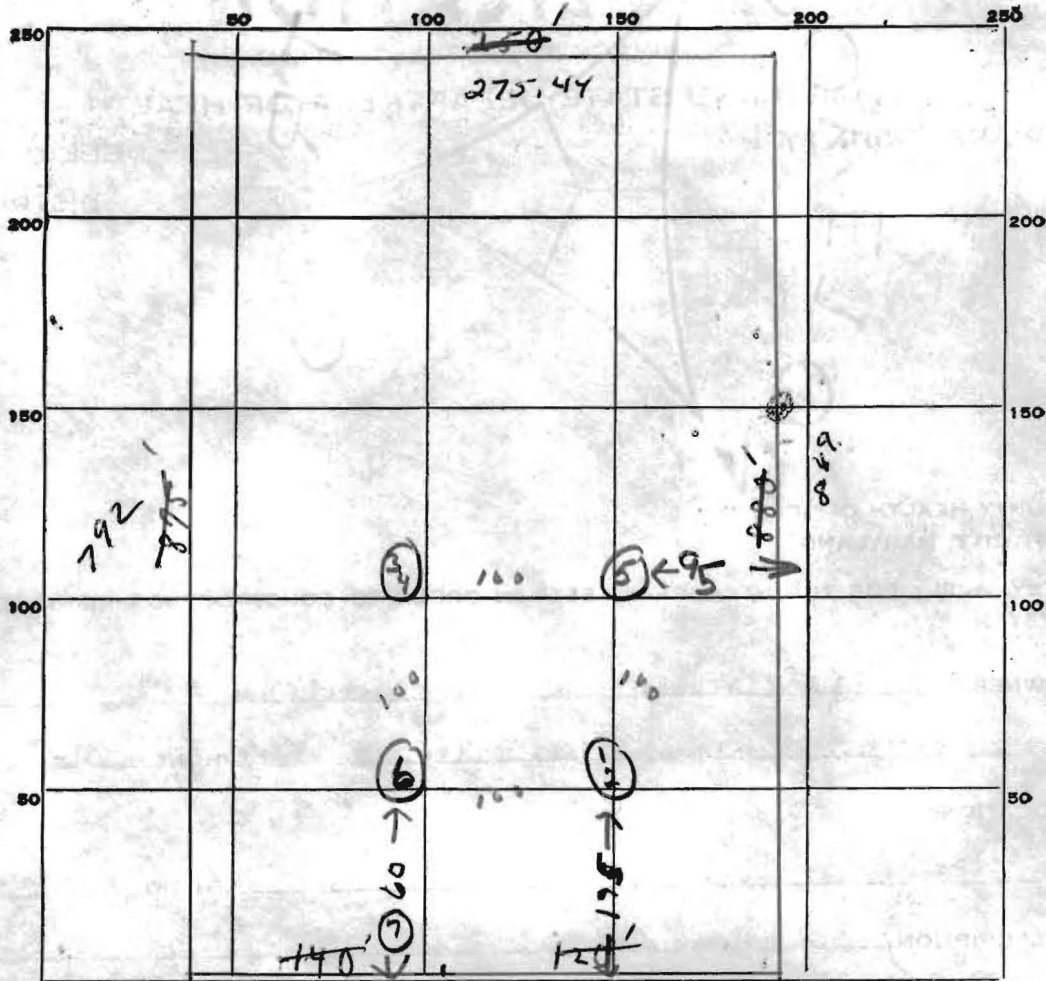

INDICATE NORTH. - NAME ADJOINING ROADWAY AS BASE LINE.

195.77 194.23
 Philadelphia Co. No. 19

DATE	TEST NO.	DEPTH	PRE-WET		TEST - 1" DROP		TIME
			START	STOP	START	STOP	
Noted No Tests	1	11 ft.	11 38	11 52	11 52	12 20	28 min
	2	5 ft.	11 38	11 41	11 41	11 45	4 min
	3	11 ft.	11 43	11 45	11 45	11 49	4 min
	4	4 ft.	11 43	11 46	11 46	11 52	8 min
	5	11 ft.	Excellent sand -			Best	Hole
	6	11 ft.	Good Soil				
	7	11 ft.	11 54	12 04	12 04	12 26	22 min
		Holes 1+7 on lowest part of lot. Reason for slow perc. Good Soil.					

SOIL AUGER FINDING

Installed system in Hole 5

TESTED BY

R. Turner

REMARKS