



RECEIVED
HOWARD COUNTY
HEALTH DEPT.

MAY 14 11 13 AM '87

DIVISION OF
ENVIRONMENTAL
HEALTH

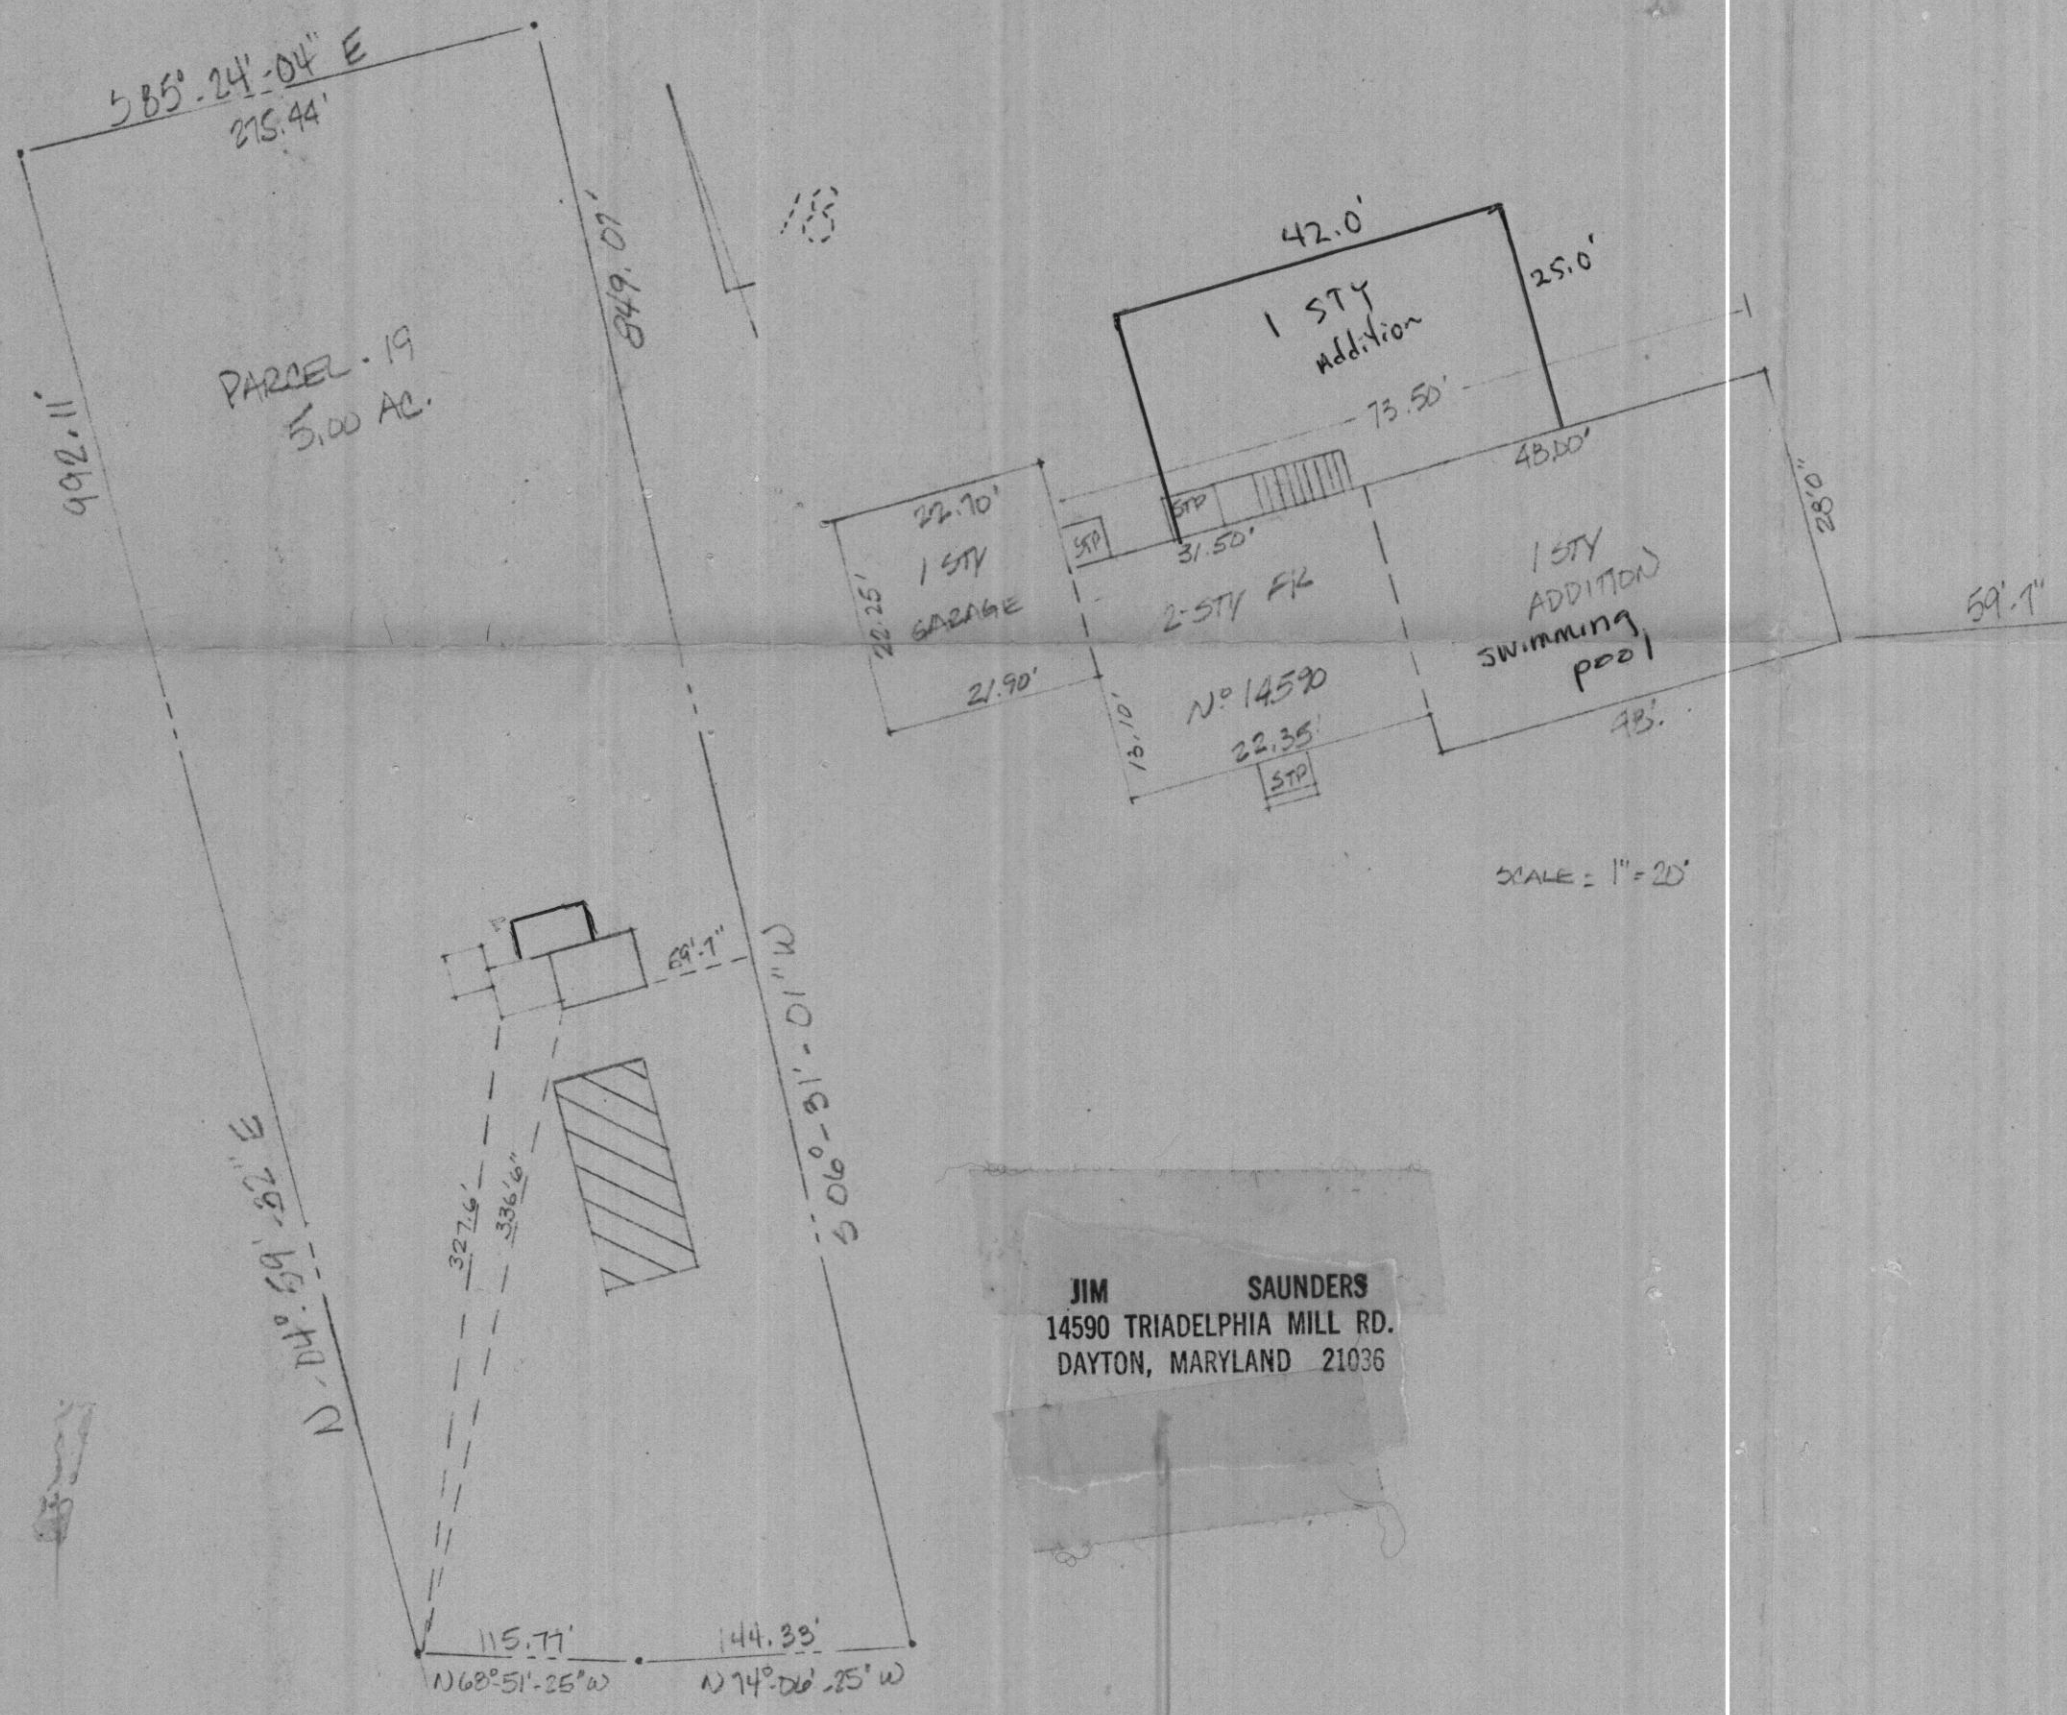

PLAT
SCALE - 1" = 100'

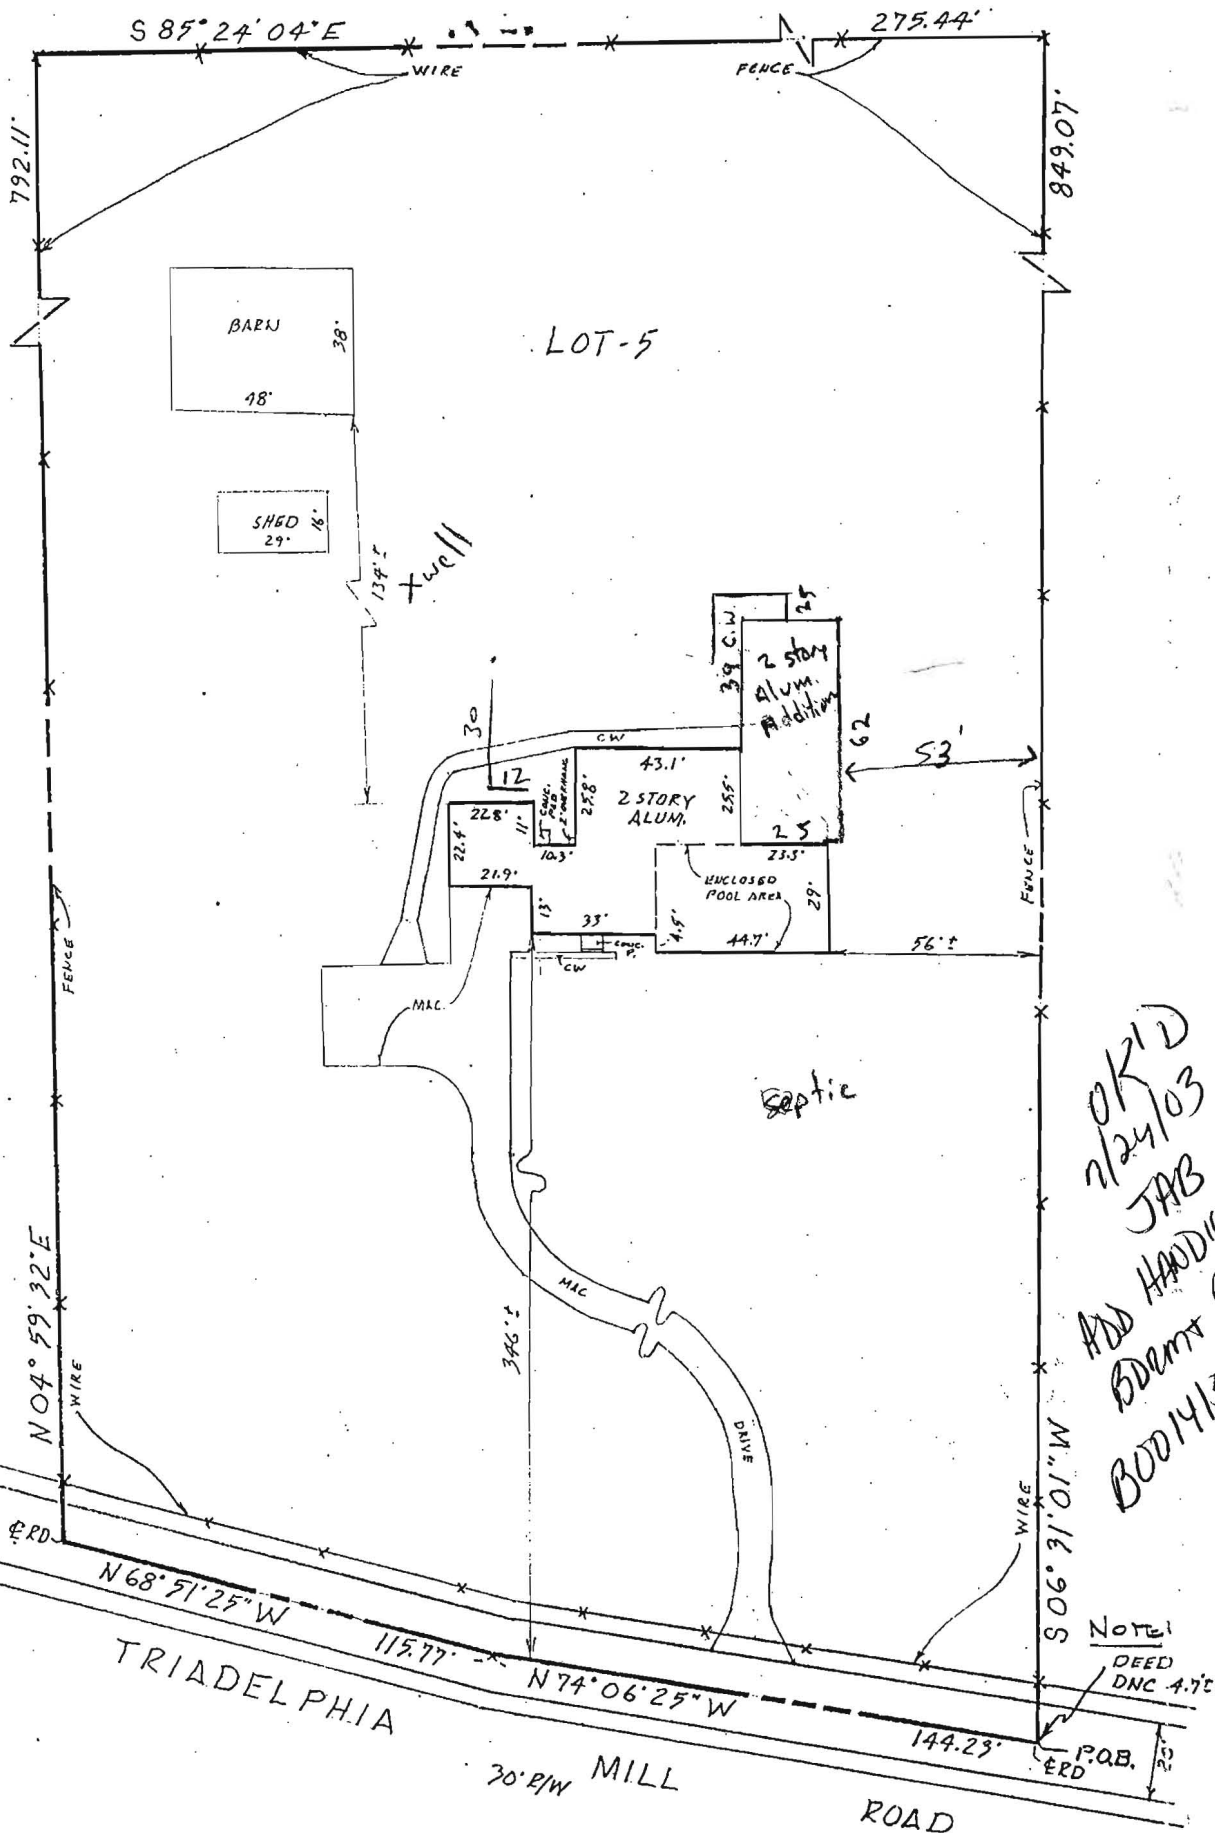

THE LOT SHOWN HEREON IS IN FLOOD ZONE C PER F.E.M.A. FLOOD INSURANCE RATE MAP PANEL # 240044 0020B

THIS IS TO CERTIFY That The Improvements Indicated Hereon Are Located As Shown. This Is Not A Property Line Survey And Should Not Be Used As Such.




WITZ & ASSOCIATES
SURVEYORS
 7222 Kennebunk Road
 Baltimore, Maryland 21244
 Phone: (410) 597-9995

LOCATION CERTIFICATION		
14590 TRIADDELPHIA MILL RD.		
TITLE DEED 1489/368		
HOWARD COUNTY, MARYLAND		
DATE: 4-18-93	SCALE: 1"=50'	FILE: 93-221

275.44

OWNER - EDWARD WETHERILL
10891 - HILLTOP LANE
COLUMBIA MD 21044

OWNER - TATKIE BLEVY

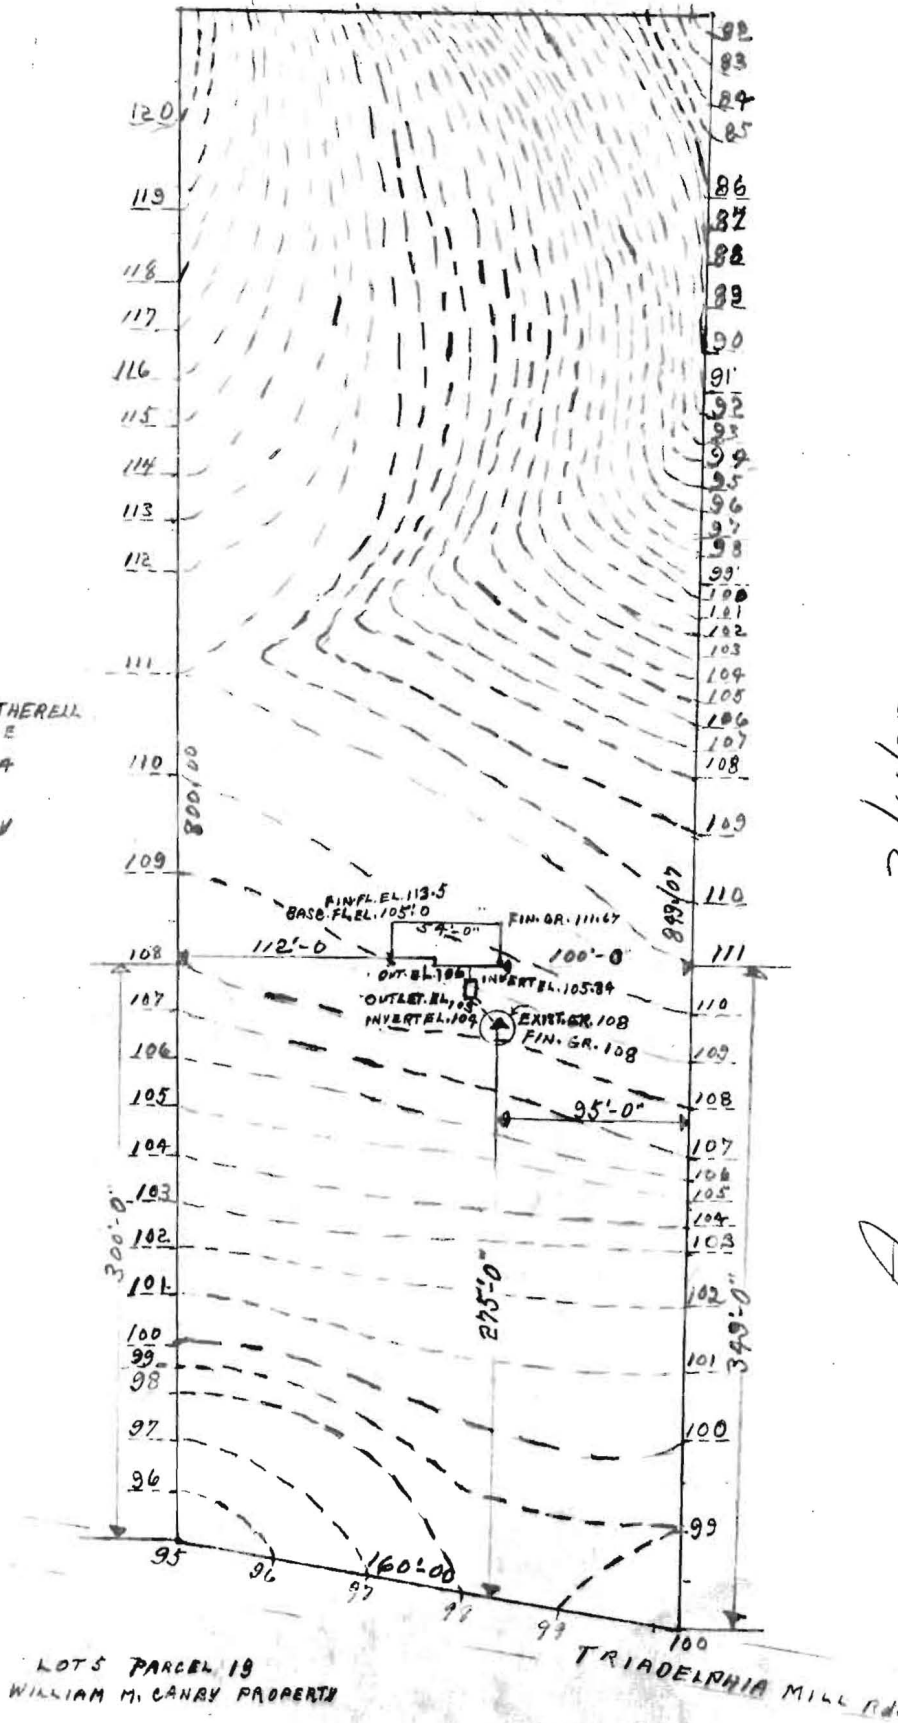


Approved 3/4/13

R.T.
[Signature]

LOT 5 PARCEL 19
WILLIAM M. CANBY PROPERTY

SCALE 1" = 100'-0"

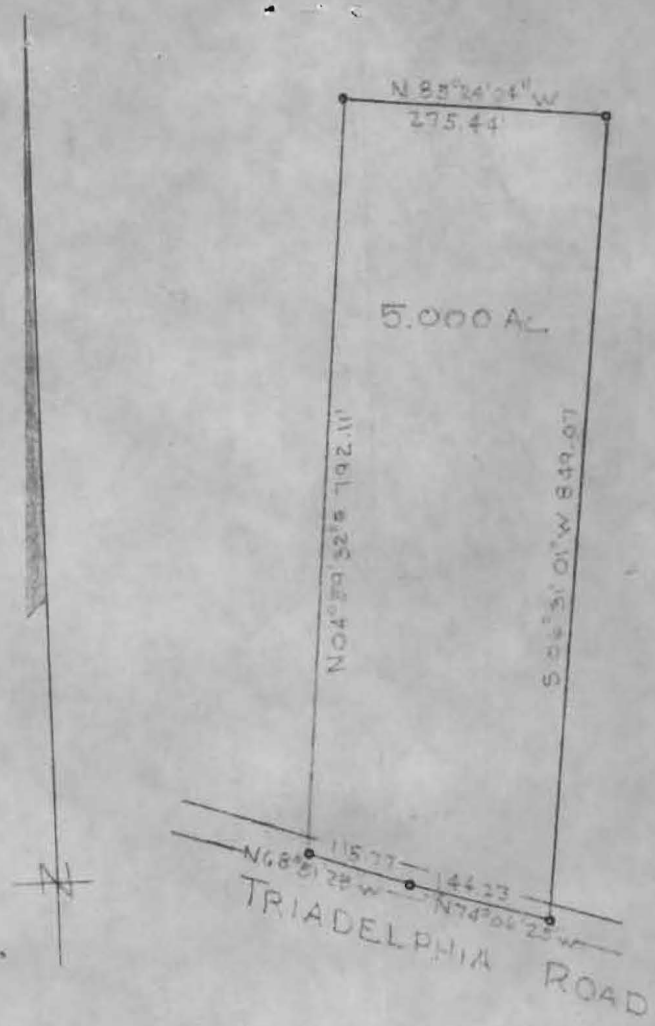

PLAT OF SURVEY
 FOR
 RUSSELL COLEMAN
 FIFTH ELECTION DISTRICT OF HOWARD COUNTY
 DAYTON, MARYLAND
 SCALE: 1 IN. = 200 FT. MAY 8, 1972

Claude M. Skinner, Jr.
 Claude M. Skinner, Jr.
 Reg. Professional Engineer &
 Land Surveyor No. 2237



A-3370-19

Wetherell