

Cell 443-690-3929 Carol

DEPARTMENT OF INSPECTIONS, LICENSES AND PERMITS 3430 COURT HOUSE DRIVE ELICOTT CITY, MD 21043 PERMITS (410) 313-2455 INSPECTIONS (410) 313-1810 AUTOMATED INFORMATION (410) 313-3800		HOWARD COUNTY PERMIT APPLICATION		PERMIT NUMBER B00144191	
Building Address <u>12301 SCAGGSVILLE RD.</u> <u>FULTON Md. 20759</u>			Property Owner's Name <u>TERBY Woodall</u>		
Suite/Apt. #: <u>—</u> SDP/WP/Petition #: <u>—</u>			Address <u>12301 Scaggsville Rd.</u>		
Census Tract <u>605102</u> Subdivision <u>—</u>			City <u>FULTON</u> State <u>MD</u> Zip Code <u>20759</u>		
Section <u>—</u> Area <u>—</u> Lot <u>—</u>			Home Phone <u>301 954-0770</u> Work Phone <u>—</u>		
Tax Map <u>40</u> Parcel <u>213</u> Grid <u>18</u>			Applicant's Name & Mailing Address, (if other than stated hereon):		
Zoning <u>RRD</u> Map Coordinates <u>18E2</u> Lot size <u>—</u>			Phone <u>—</u> Fax <u>—</u>		
Existing Use <u>SF HOME</u>			Contractor Company <u>OUTDOOR IMPRESSIONS</u>		
Proposed Use <u>same w/ deck</u>			Contact Person <u>CARL ADOLPHSON</u>		
Estimated Construction Cost \$ <u>7,000.00</u>			Address <u>7521 COMETORY LA. 2</u>		
Description of Work <u>Irregular Stone P.T. DOCK EXTENDING FROM BACK OF HOUSE APPROX 30'x4' w/ 9' HIGH STANDARD PICKET RAILING</u>			City <u>ELK RIDGE</u> State <u>MD</u> Zip Code <u>21095</u>		
Occupant or Tenant <u>OWN</u>			License No. <u>43176</u>		
Contact Name <u>—</u>			Phone <u>410 730 9104</u> Fax <u>—</u>		
Address <u>—</u>			Engineer or Architect Company <u>N/A</u>		
City <u>—</u> State <u>—</u> Zip Code <u>—</u>			Contact Person <u>—</u>		
Phone <u>—</u> Fax <u>—</u>			Address <u>—</u>		
City <u>—</u> State <u>—</u> Zip Code <u>—</u>			City <u>—</u> State <u>—</u> Zip Code <u>—</u>		
Phone <u>—</u> Fax <u>—</u>			Phone <u>—</u> Fax <u>—</u>		

BUILDING DESCRIPTION - <u>COMMERCIAL</u>		BUILDING DESCRIPTION - <u>RESIDENTIAL</u>	
Building Characteristics	Utilities	Building Characteristics	Utilities
Height: <u>—</u>	Water Supply: <u>—</u> Public <u>—</u> Private <u>—</u>	SF Dwelling <input checked="" type="checkbox"/> SF Townhouse <input type="checkbox"/> Depth <u>—</u> Width <u>—</u>	Water Supply: <u>—</u> Public <u>—</u> Private <u>—</u>
No. of stories: <u>—</u>	Sewage Disposal: <u>—</u> Public <u>—</u> Private <u>—</u>	1st floor: <u>—</u>	Sewage Disposal: <u>—</u> Public <u>—</u> Private <u>—</u>
Gross area, sq. ft. per floor: <u>—</u>	Electric Yes <input type="checkbox"/> No <input type="checkbox"/> Gas Yes <input type="checkbox"/> No <input type="checkbox"/>	2nd floor: <u>—</u>	Electric Yes <input checked="" type="checkbox"/> No <input type="checkbox"/> Gas Yes <input type="checkbox"/> No <input checked="" type="checkbox"/>
Use group: <u>—</u>	Heating System: <u>—</u> Electric <input type="checkbox"/> Oil <input type="checkbox"/> Natural Gas <input type="checkbox"/> Propane Gas <input type="checkbox"/>	Basement: <u>—</u>	Heating System: <u>—</u> Electric <input checked="" type="checkbox"/> Oil <input type="checkbox"/> Natural Gas <input type="checkbox"/> Propane Gas <input type="checkbox"/>
Construction type: <u>—</u> Reinforced Concrete <u>—</u> Structural Steel <u>—</u> Masonry <u>—</u> Wood Frame <u>—</u> State Certified Modular <u>—</u>	Sprinkler system: <u>N/A</u> <input type="checkbox"/> Full <u>—</u> Partial <u>—</u> Other Suppression <u>—</u> # of Heads <u>—</u>	Finished Basement <input checked="" type="checkbox"/> Unfinished Basement <input type="checkbox"/> Crawl space <input type="checkbox"/> Slab on Grade <input type="checkbox"/> No. of Bedrooms <u>—</u>	Sprinkler system: <u>N/A</u> <input checked="" type="checkbox"/> NFPA #13D <u>—</u> NFPA #13R <u>—</u> Other <u>—</u>
		Multi-family dwellings: No. of efficiency units: <u>—</u> No. of 1 BR units: <u>—</u> No. of 2 BR units: <u>—</u> No. of 3 BR units: <u>—</u>	
		Other Structure: <u>—</u> Dimensions: <u>—</u> Footings: <u>—</u> Roof: <u>—</u>	
		State Certified Modular <u>—</u> Manufactured Home <u>—</u>	

THE UNDERSIGNED HEREBY CERTIFIES AND AGREES AS FOLLOWS: (1) THAT HE/SHE IS AUTHORIZED TO MAKE THIS APPLICATION; (2) THAT THE INFORMATION IS CORRECT; (3) THAT HE/SHE WILL COMPLY WITH ALL REGULATIONS OF HOWARD COUNTY WHICH ARE APPLICABLE THERETO; (4) THAT HE/SHE WILL PERFORM NO WORK ON THE ABOVE REFERENCED PROPERTY NOT SPECIFICALLY DESCRIBED IN THIS APPLICATION; (5) THAT HE/SHE GRANTS COUNTY OFFICIALS THE RIGHT TO ENTER ONTO THIS PROPERTY FOR THE PURPOSE OF INSPECTING THE WORK PERMITTED AND POSTING NOTICES.

Applicant's Signature CARL ADOLPHSON Print Name CARL ADOLPHSON
Date 7-21-03


Title/Company — Checks payable to: DIRECTOR OF FINANCE OF HOWARD COUNTY
** PLEASE WRITE NEATLY AND LEGIBLY. **

FOR OFFICE USE ONLY		
AGENCY	DATE	SIGNATURE APPROVAL
Land Development, DPZ	<u>7/24/03</u>	<u>—</u>
State Highways	<u>7/24/03</u>	<u>—</u>
Building Official	<u>7/24/03</u>	<u>—</u>
Dev. Engineering, DPZ	<u>7/24/03</u>	<u>—</u>
Health	<u>7/24/03</u>	<u>—</u>
Fire Protection	<u>7/24/03</u>	<u>—</u>
Is Sediment Control approval required prior to issuance? YES <input type="checkbox"/> NO <input type="checkbox"/>		
CONTINGENCY CONSTRUCTION START: <input type="checkbox"/>		
ONE STOP SHOP: <input type="checkbox"/>		
Distribution of Copies: White: Building Official Green: LDD, DPZ Yellow: DED, DPZ Pink: Health Gold: SHA		
TAP Form PERMIT.FRM		

DPZ SETBACK INFORMATION	
Front	<u>—</u>
Side	<u>—</u>
Side St.	<u>—</u>
All minimum setbacks met	YES <input type="checkbox"/> NO <input type="checkbox"/>
Is Entrance Permit required?	YES <input type="checkbox"/> NO <input type="checkbox"/>
Historic District	YES <input type="checkbox"/> NO <input type="checkbox"/>
Lot Coverage for New Town Zone	<u>—</u>
SDP/Red-line approval date	<u>—</u>

PROPERTY ID# <u>59593</u>	
Filing fee	\$ <u>—</u>
Permit fee	\$ <u>50</u>
Excise tax	\$ <u>—</u>
Add'l per. fee	\$ <u>—</u>
TOTAL FEES	\$ <u>50</u>
Sub-total paid	\$ <u>—</u>
Balance due	\$ <u>—</u>
Check	<u>CPH</u>
Validation	<u>ADOLPHSON</u>
Accepted by	<u>—</u>

PVC CLEANOUT

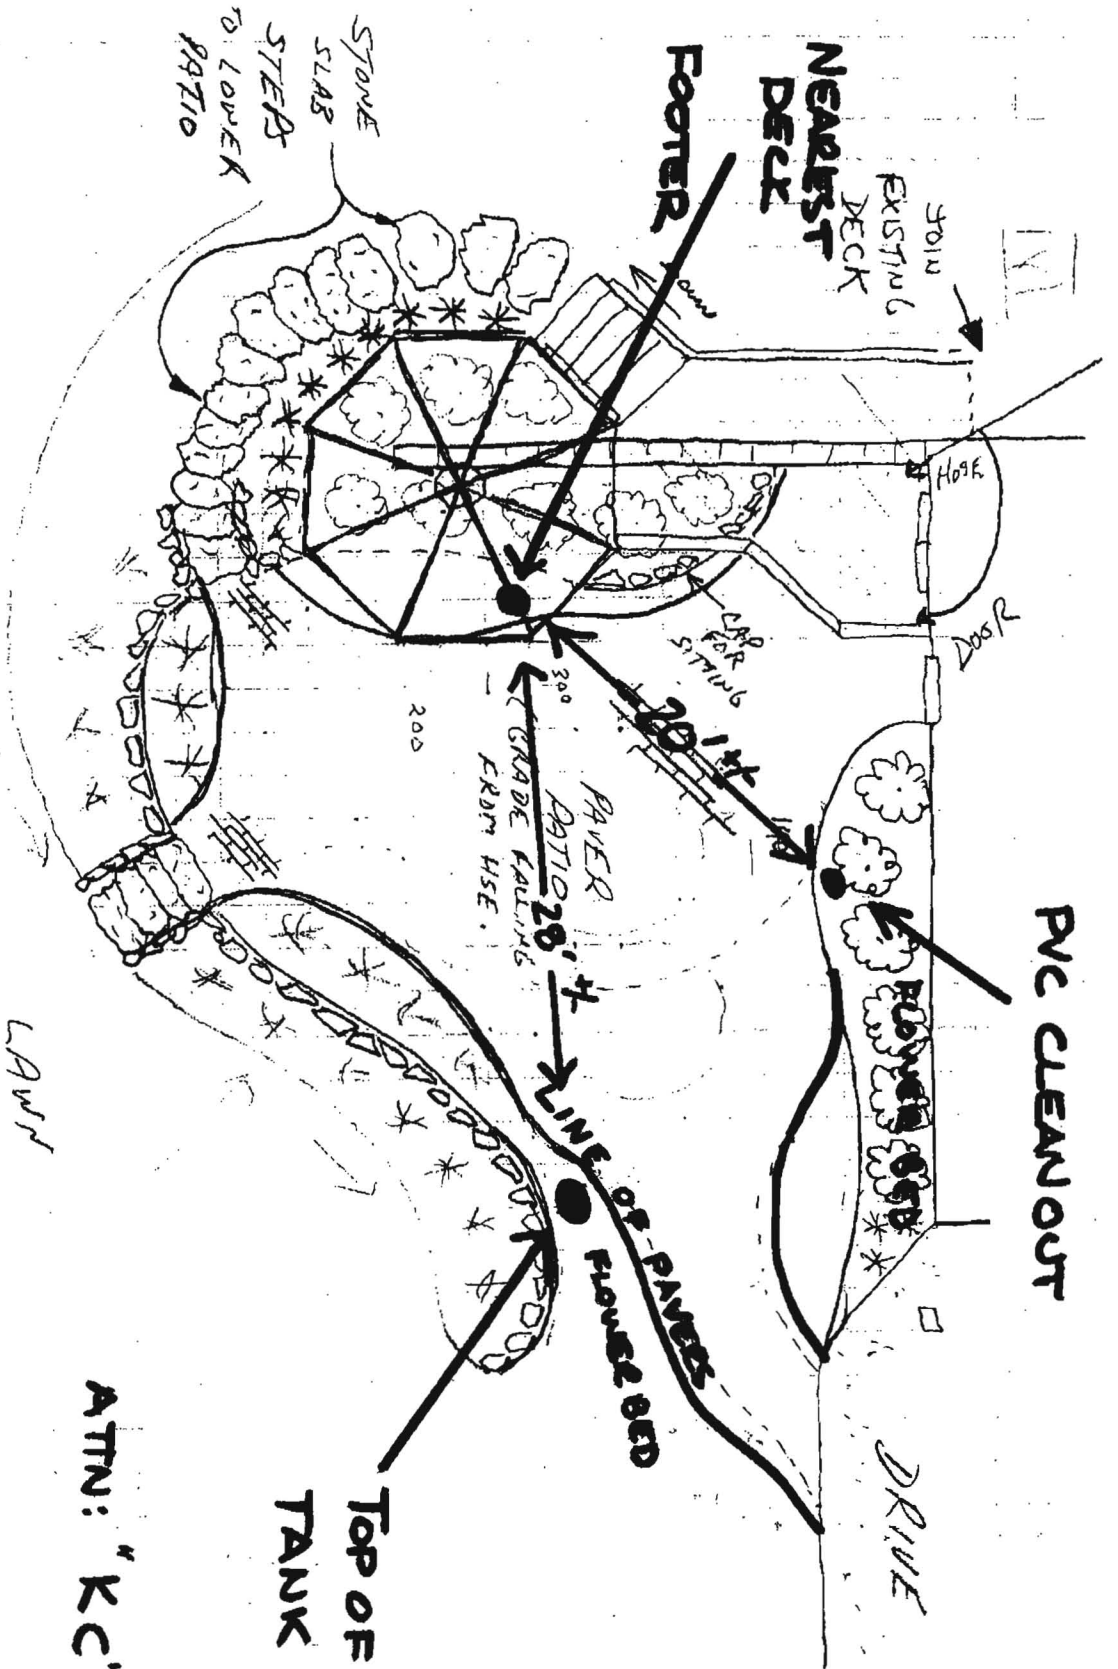

ATTN: "KC"

WOODALL RES
12301 SEAGRAMME
FULTON

ON 9/26/03
@ 7:30 am
Fri Morning CRAIG
drywell pumped out
effluent did not
run back
BP00144191
Signed (KN)

To: K. C.

Fax: (410) 313-2648

From: Terry Woodall

Date: September 26, 2003

Re: Photo and landscape drawing

Pages: 3

CC:

☐ Urgent

☐ For Review

☐ Please Comment

☐ Please Reply

☐ Please Recycle

K.C. – Attached, is a copy of the landscaping drawing. Please note that the deck footer that is nearest the septic system is 28' (+/-) from the top of the tank (we looked into), and approximately 20' from the PVC clean out. Please also note that the opening to the septic tank and the PVC clean-out will both be located in flower beds that are adjacent to the brick patio.

Also attached, is a copy of the photo we discussed. It is a little dark however, you can see the top of the tank as well as the clean-out.

If you scale the 4" PVC pipe, you will find that the distance between the top of the tank and the pipe is 2.33 times the pipe diameter – or 9" to 10" above the pipe.

Also, the top of the clean-out is 4.1 times the pipe diameter – or about 16 1/2" above the pipe.

I hope this provides enough information.

Sincerely,

Terry Woodall

Subject property is shown in Zone C
 on the National Flood Insurance Program
 Flood Insurance Rate Map of BUTWARD
 County, Maryland. Panel # 37 OF 43
 Community Panel # 240042-0007A
 Effective Date: DECEMBER 4, 1986

This is to certify that I have surveyed the property known as
PART OF LOT 4
12301 SCAGSVILLE ROAD
sheet of recorded 1948/632 among the
Land Records of Howard County, Maryland for the
purpose of locating the improvements thereon.

THIS PLAT SHOWS ONLY THAT THE IMPROVEMENTS ARE
CONTAINED WITHIN THE OUTLINES OF THE LOT AND IS
NOT TO BE ESTABLISH PROPERTY LINES.



J. Carl Hudgins PLS #98

LOCATION SURVEY
12301 SCAGGSVILLE ROAD
HIGHLAND
5TH ELECTION DISTRICT
HOWARD COUNTY, MARYLAND

NTT Associates, Inc.

16205 Old Frederick Road
M. Jry. Maryland 21771
Ph. (410) 442-2031
Fax No. (410) 442-1315

Scale: 1" = 60'

Date: MARCH 23 1995

Field By: JLM

Drawn By: JN

Don't know if this is correct.