

PUB. SEWER STATUS VERIFIED BY _____

ISSUE DATE: _____

APPROVAL DATE: _____

PERMIT
INDEXED

P 518989-D

A Index

ON-SITE SEWAGE DISPOSAL SYSTEM
HOWARD COUNTY HEALTH DEPARTMENT
BUREAU OF ENVIRONMENTAL HEALTH

05-365619

IS PERMITTED TO INSTALL ☐ ALTER ☒

ADDRESS: _____ PHONE NUMBER: _____

SUBDIVISION: _____ LOT NUMBER: _____

ADDRESS: 4838 Ten Oaks Road PROPERTY OWNER: Kim

SEPTIC TANK CAPACITY (GALLONS): _____

PUMP CHAMBER CAPACITY (GALLONS): _____

NUMBER OF BEDROOMS: _____

SQUARE FEET PER BEDROOM: _____

LINEAR FEET OF TRENCH REQUIRED: _____

TRENCHES:	Trench to be _____ feet wide. Inlet _____ feet below original grade. Bottom maximum depth _____ feet below original grade. Effective area begins at _____ feet below original grade. _____ feet of stone below distribution pipe.
LOCATION:	
PURPOSE:	Index file

PLANS APPROVED: _____ DATE: _____

NOTE: PERMIT VOID AFTER 2 YEARS

NOTE: CONTRACTOR RESPONSIBLE FOR SCHEDULING A PRE-CONSTRUCTION INSPECTION FOR ALL INSTALLATIONS

NOTE: WATERTIGHT SEPTIC TANKS REQUIRED

NOTE: ALL PARTS OF SEPTIC SYSTEM SHALL BE 100 FEET FROM ANY WATER WELL

NOTE: MANHOLE RISERS REQUIRED ON ALL SEPTIC TANKS AND PUMP CHAMBERS

**NEITHER THE HOWARD COUNTY COUNCIL NOR THE HEALTH DEPARTMENT IS
RESPONSIBLE FOR THE SUCCESSFUL OPERATION OF ANY SYSTEM
PERMITTEE RESPONSIBLE FOR OBTAINING FINAL APPROVAL ON THIS PERMIT
CALL 410-313-2640 FOR INSPECTION OF SEPTIC SYSTEM**

0518989-D

PERMIT

SEWAGE DISPOSAL SYSTEM

HOWARD COUNTY

ELICOTT CITY

INDEXED

DISTRICT 1

DATE 8/28/73

Jack Spack IS PERMITTED TO INSTALL 2 ALTER

ADDRESS Van Oke Road, Ellicott City, Md. PHONE 897-2880

A SEWAGE DISPOSAL SYSTEM LOCATED AT

SUBDIVISION (Eastern Detention) ROAD Van Oke Rd. & Greenbridge Road LOT 2

PROPERTY OWNER James C. Seaborn, Jr.

ADDRESS

SPECIFICATIONS - 3 bedrooms

DRAIN FIELD DEPTH FEET, BOTTOM AREA SQ. FT.

SEEPAGE PITS ABSORBENT SIDE-WALL AREA SQ. FT.

SEPTIC TANK CAPACITY 1,000 GALLONS

FOR GARBAGE GRINDER, INCREASE DISPOSAL AREA 25% & TANK CAPACITY 50%.

OTHER Dry well - 100 sq. ft. 20" diameter, 130 ft. from front

lot line at Van Oke Rd. and 75 ft. from right property line as shown when facing property

from Van Oke Rd. New inlet 4" to 6" below original grade. Top of well 12 ft. below original grade.

NOTE: ALL PIPE FROM HOUSE TO DRY WELL MUST BE CAST IRON.

PERMIT VOID AFTER THREE YEARS.


NOTE: INSTALL STAND PIPES ON SEPTIC TANK AND DRY WELL.

PLANS APPROVED BY E. Snyder DATE 12/29/73

FILL SEPTIC TANK AND DISTRIBUTION BOX WITH WATER BEFORE CALLING FOR AN INSPECTION. COVER NO WORK UNTIL INSPECTED AND APPROVED.

NEITHER THE HOWARD COUNTY COMMISSIONERS NOR THE HEALTH DEPARTMENT IS RESPONSIBLE FOR THE SUCCESSFUL OPERATION OF ANY SYSTEM.

11721

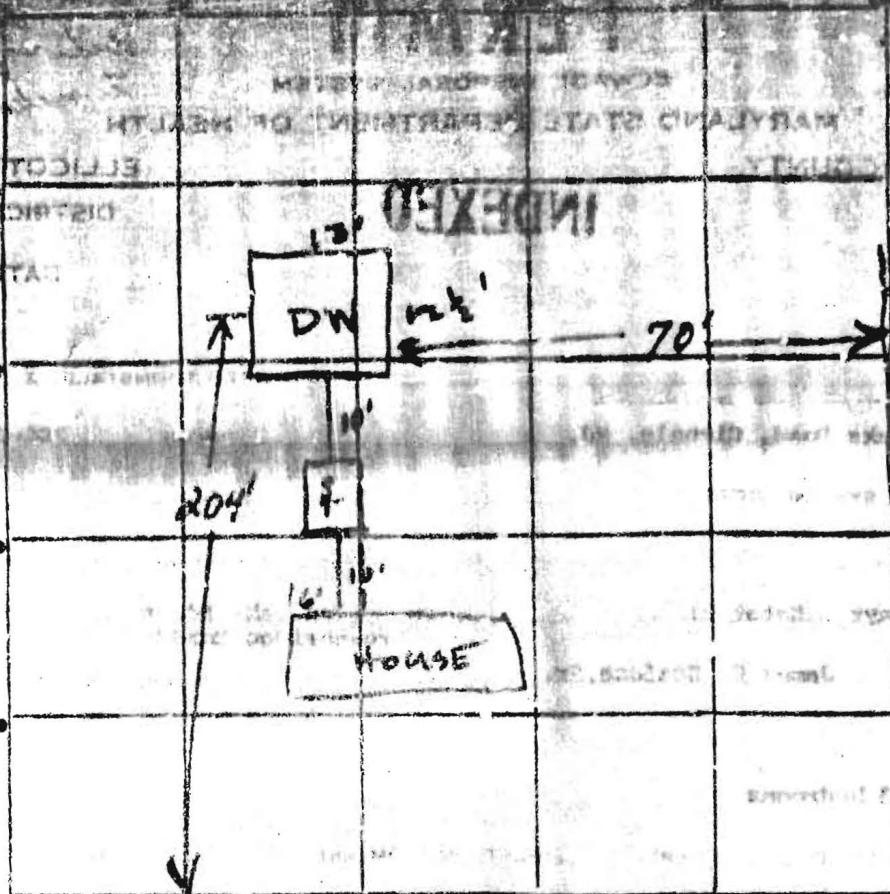

INDICATE NORTH - NAME ADJOINING ROADWAY AS BASE LINE.

10 OAKS RD

PERMIT CARD

SEPTIC TANK, LEVEL

1000 gal

CLEANOUTS

DW; Manhole on ST; OK

DISTRIBUTION BOX, LEVEL

TILE FIELD, DEPTH

FT. TRENCH WIDTH

FT.

GRAVEL DEPTH

IN. TOTAL LENGTH

FT.

NUMBER OF TRENCHES

TOTAL BOTTOM AREA

SEE PAGE PITS, INSIDE DIAMETER

12' x 13' FT.

DEPTH BELOW INLET

7' FT.

ABSORBENT AREA

382

SQ. FT.

REMARKS

8/29/73 Location not correct

Need lid of DW cemented (crack)

9/31/73

Tar shingle paper put over D. Hall to cover

crack OK C.R.S. See plot to see new

wire hole to maintain 10,000' sewage line.

CBS

DATE SYSTEM APPROVED

INSPECTOR

C. A. Tucker

MR 4/29/98 10:00

SITE INSPECTION SHEET

OWNER: James G. Seafone Sr.

DATE REQUESTED: _____

PHONE #: _____

CONTRACTOR: _____


ADDRESS: 4838 Ten Oak Rd, Dayton
2 houses south of service
station

WELL TAG #: _____

COUNTY #: _____

PROPOSAL: _____

possible well to be abandoned

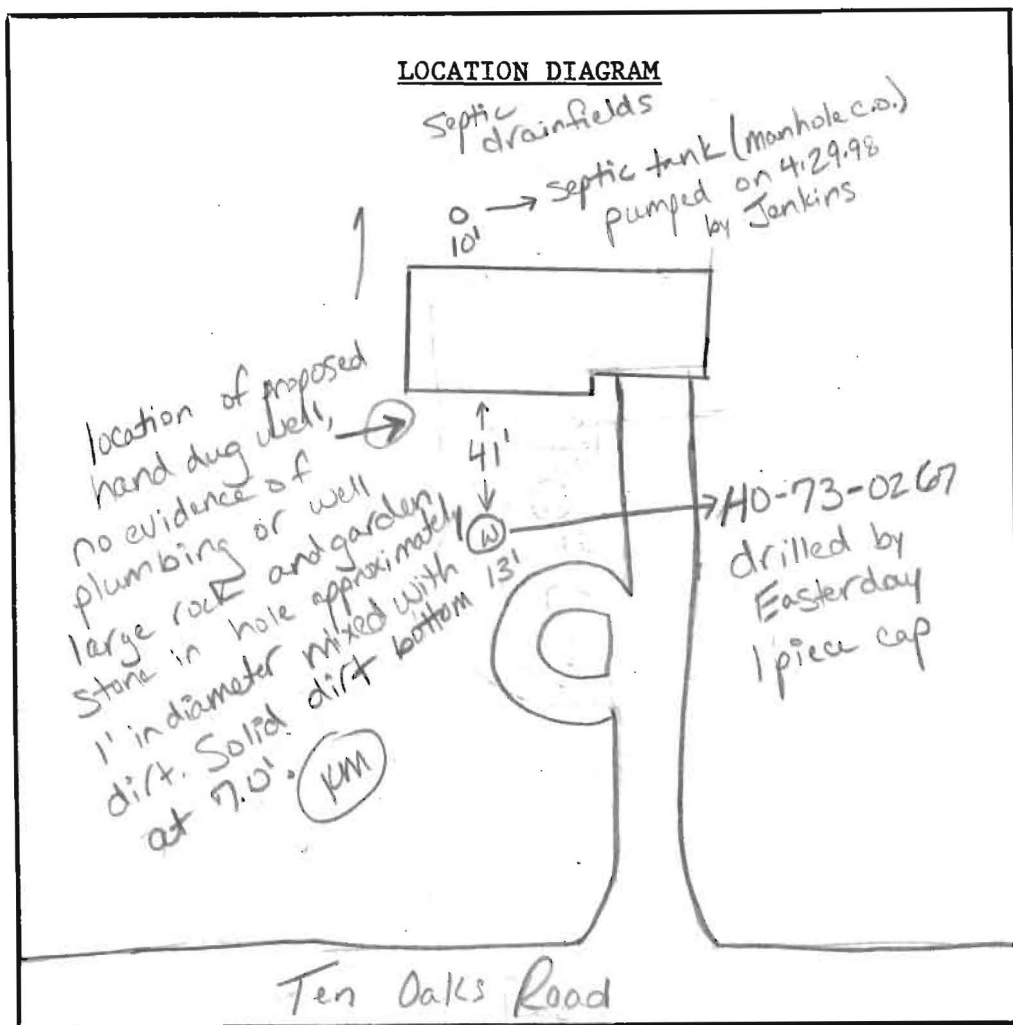

COMMENTS: 4.29.98 no evidence of hand dug well in proposed location
or anywhere else on property as described by the owner. Owner
wishes to have letter stating no hand dug well was found. Hole
covered and returned to original state by Jenkins Brothers.

DATE: 4.29.98

INSPECTOR: Kim Musto