

APPLICATION

SEWAGE DISPOSAL TESTING

MARYLAND STATE DEPARTMENT OF HEALTH

HOWARD COUNTY

ELLICOTT CITY

DISTRICT

DATE

12/1/72

TO: THE COUNTY HEALTH OFFICER
ELLICOTT CITY, MARYLAND

I, HEREBY, APPLY FOR THE NECESSARY TESTS IN ORDER TO CONSTRUCT OR RECONSTRUCT A SEWAGE DISPOSAL SYSTEM.

PROPERTY OWNER JAMES C. & IRENE F. SCAFORNE SR.

ADDRESS 6601 - RED TOP RD - CHILLUM MANOR MD 20763 PHONE 559-0250

PROPERTY LOCATION:

SUBDIVISION Dayton Estates LOT NO. (2)

ROAD AND DESCRIPTION TEN CARS RD & GREENBRIDGE RD
HOWARD CO.

OCCUPANT None Const PHONE ---

PERSON TO CONSTRUCT SYSTEM J. S. Fyock

ADDRESS Glenn L. Md PHONE 286-2939

SIZE OF LOT 5,3398 AC TYPE BLDG. (3)
NUMBER OF ROOMS

IF NOT SINGLE RESIDENCE DESCRIBE

SIGNATURE OF APPLICANT James C. Scafone Sr.


APPROVED BY _____ FOR _____ DATE _____
REMARKS OF SYSTEM

REJECTED BY _____ FOR _____ DATE _____
REMARKS OF SYSTEM

HOLD PENDING FURTHER TESTS _____ DATE _____

REASONS FOR REJECTION OR HOLDING _____

THIS IS NOT A PERMIT

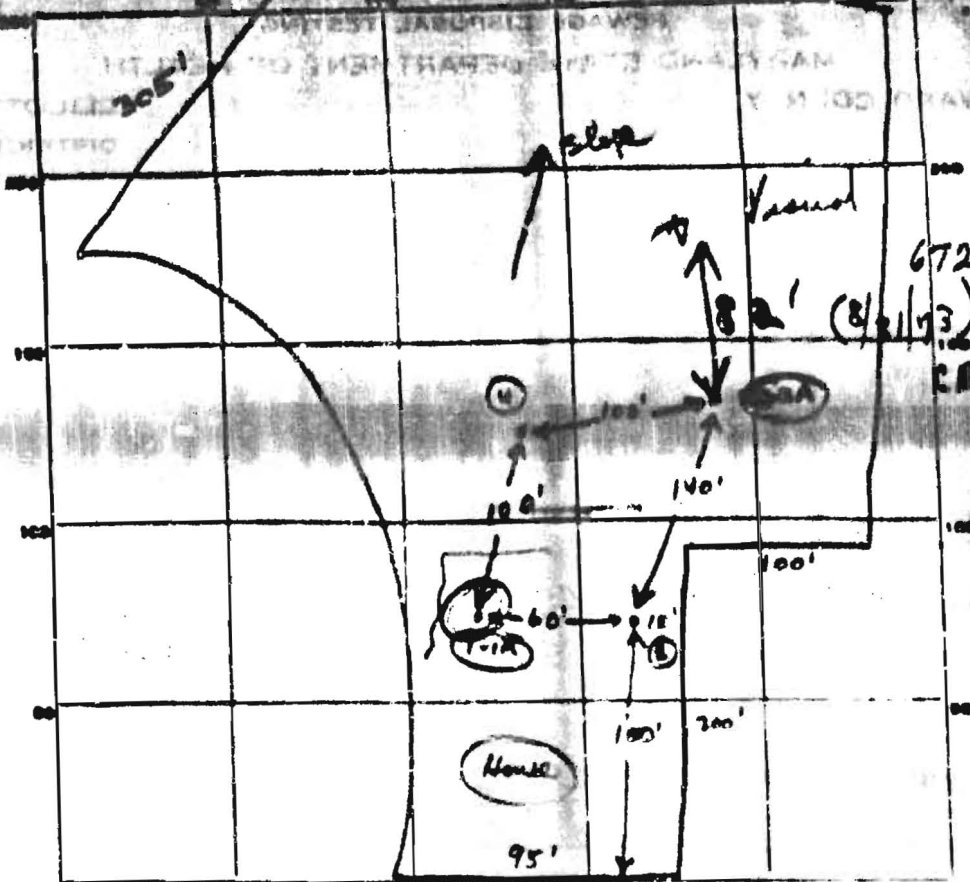

INDICATE NORTH - NAME ADJOINING ROADWAY AS BASE LINE

Ten Oaks Rd

DATE	TEST NO.	DEPTH	PRE-WET		TEST - 1" DROP		TIME
			START	STOP	START	STOP	
1/14/72	1	5'	930	934	934	936	2
	1A	12'	930	938	938	947	9
	2	top 4 1/2' clay Bottom 2 1/2' Good Soil					Dry
	3	5'	950	951	951	952	1
	3A	12'	950	951	951	953	2
	4	top 5' clay Bottom 6' Good Soil					Dry

Air Time
3 1/2
min

SOIL AUGER FINDING

TESTED BY

REMARKS

Dry well at (1-1A)
Max Inlet 5'
Max Depth 12'