

# HOWARD COUNTY PERMIT APPLICATION

PERMIT NUMBER

B00142831

Building Address 4113 TEN OAKS RD  
DAYTON MD 21031

Suite/Apt. #: \_\_\_\_\_ SDP/WP/Petition #: \_\_\_\_\_

Census Tract \_\_\_\_\_ Subdivision 1A

Section \_\_\_\_\_ Area \_\_\_\_\_ Lot \_\_\_\_\_

Tax Map 26 Parcel 143 Grid \_\_\_\_\_

Zoning R Map Coordinates 9111 Lot size 0.6A

Existing Use SINGLE FAMILY

Proposed Use SAME

Estimated Construction Cost \$35,000

Description of Work ADDITION WOOD EXST.

POUR CONCRETE FOR FAMILY ROOM

POUR CONSTRUCTION

Occupant or Tenant JUDITH G. ROD

Contact Name S&K ROOFING

Address 1005 RISING RIVER RD

City MT AIRY State MD Zip Code 21771

Phone 410 795 4400 Fax 410 795 8796

Property Owner's Name JUDITH E. G. ROD

Address 4113 TEN OAKS RD

City DAYTON State MD Zip Code 21031

Home Phone 410 531 2257 Work Phone \_\_\_\_\_

Applicant's Name & Mailing Address, (if other than stated hereon):

S&K ROOFING 1005 RISING RIVER RD

MT AIRY MD 21771

Phone 410 795 4400 Fax 410 795 8796

Contractor Company S&K ROOFING

Contact Person JOE MILLER

Address 1005 RISING RIVER RD

City MT AIRY State MD Zip Code 21771

License No. 21080

Phone 410 795 4400 Fax 410 795 8796

Engineer or Architect Company S&K

Contact Person JOE MILLER

Address 1005 RISING RIVER RD

City MT AIRY State MD Zip Code 21771

Phone 410 795 4400 Fax 410 795 8796

## BUILDING DESCRIPTION - COMMERCIAL

### Building Characteristics

Height: 12

No. of stories: 1

Gross area, sq. ft. per floor: 320

Use group: \_\_\_\_\_

Construction type:

☐ Reinforced Concrete

☐ Structural Steel

☐ Masonry

☒ Wood Frame

☐ State Certified Modular

### Utilities

Water Supply:

☐ Public

☒ Private

Sewage Disposal:

☐ Public

☒ Private

Electric Yes ☒ No ☐

Gas Yes ☐ No ☒

Heating System:

Electric ☒ Oil ☐

Natural Gas ☐

Propane Gas ☐

Sprinkler system: N/A ☒

☐ Full

☐ Partial

☐ Other Suppression

☐ # of Heads

## BUILDING DESCRIPTION - RESIDENTIAL

### Building Characteristics

SF Dwelling ☒ SF Townhouse ☐

Depth Width

1st floor: 16 2.0

2nd floor: \_\_\_\_\_

Basement: 200

Finished Basement ☐ Unfinished Basement ☐

Crawl space ☐ Slab on Grade ☐

No. of Bedrooms \_\_\_\_\_

Multi-family dwellings:

No. of efficiency units: \_\_\_\_\_

No. of 1 BR units: \_\_\_\_\_

No. of 2 BR units: \_\_\_\_\_

No. of 3 BR units: \_\_\_\_\_

Other Structure: \_\_\_\_\_

Dimensions: \_\_\_\_\_

Footings: \_\_\_\_\_

Roof: \_\_\_\_\_

☐ State Certified Modular

☐ Manufactured Home

### Utilities

Water Supply:

☐ Public

☒ Private

Sewage Disposal:

☐ Public

☒ Private

Electric Yes ☒ No ☐

Gas Yes ☐ No ☐

Heating System:

Electric ☐ Oil ☐

Natural Gas ☐

Propane Gas ☐

Sprinkler system: N/A ☐

☐ NFPA #13D

☐ NFPA #13R

☐ Other:

THE UNDERSIGNED HEREBY CERTIFIES AND AGREES AS FOLLOWS: (1) THAT HE/SHE IS AUTHORIZED TO MAKE THIS APPLICATION; (2) THAT THE INFORMATION IS CORRECT; (3) THAT HE/SHE WILL COMPLY WITH ALL REGULATIONS OF HOWARD COUNTY WHICH ARE APPLICABLE THEREIN; (4) THAT HE/SHE WILL PERFORM NO WORK ON THE ABOVE REFERENCED PROPERTY NOT SPECIFICALLY DESCRIBED IN THIS APPLICATION; (5) THAT HE/SHE GRANTS COUNTY OFFICIALS THE RIGHT TO ENTER ONTO THIS PROPERTY FOR THE PURPOSE OF INSPECTING THE WORK PERMITTED AND POSTING NOTICES.

Applicant's Signature JOE MILLER

S&K ROOFING

Title/Company

Print Name JOE MILLER

7/13/03

Date

Checks payable to: DIRECTOR OF FINANCE OF HOWARD COUNTY

\*\* PLEASE WRITE NEATLY AND LEGIBLY. \*\*

- FOR OFFICE USE ONLY -

AGENCY DATE SIGNATURE APPROVAL

Land Development, DPZ

State Highways

Building Official 7/13/03

Dev. Engineering, DPZ

Health 7/13/03 Steven R. Huey

Fire Protection

Is Sediment Control approval required prior to issuance?

YES ☐ NO ☐

CONTINGENCY CONSTRUCTION START: ☐

ONE STOP SHOP: ☐

DPZ SETBACK INFORMATION

Front: \_\_\_\_\_

Rear: \_\_\_\_\_

Side: \_\_\_\_\_

Side St.: \_\_\_\_\_

All minimum setbacks met?

YES ☐ NO ☐

Is Entrance Permit required?

YES ☐ NO ☐

Historic District?

YES ☐ NO ☐

Lot Coverage for NewTown Zone \_\_\_\_\_

SDP/Red-line approval date \_\_\_\_\_

PROPERTY ID# 51744

Filing fee \$ 25

Permit fee \$ 58

Excise tax \$ 25

Add'l per. fee 6

TOTAL FEES \$ 345

Sub-total paid \$ \_\_\_\_\_

Balance due \$ \_\_\_\_\_

Check # 5935

Validation # 23038


Accepted by [Signature]

TEN OAKS ROAD

MARYLAND ROUTE 32



Well Tag #

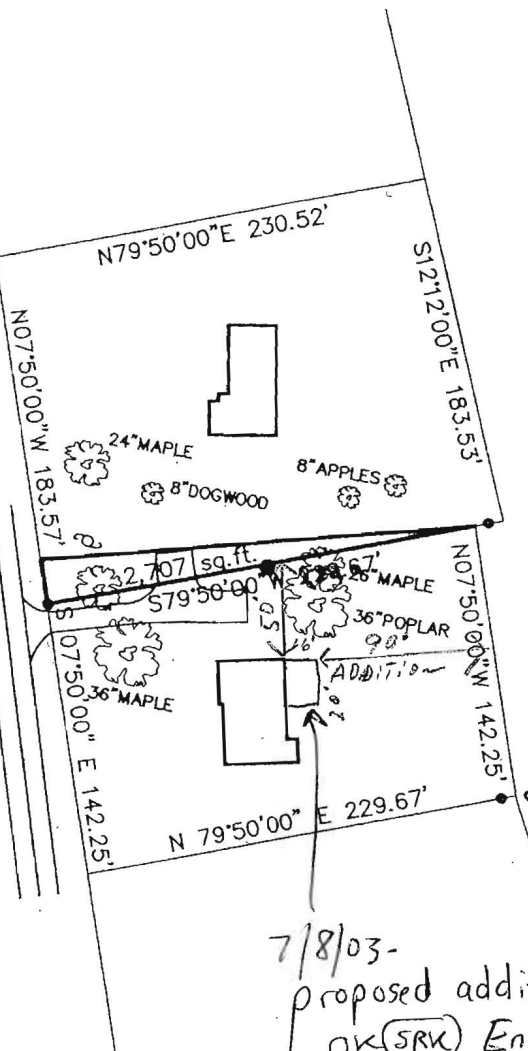

7/8/03-  
proposed addition  
OK (SRK) Enclosing existing  
porch.

Girod Residence  
4113 Ten Oaks Rd.  
Dayton, MD 21036

**MILDENBERG  
BOENDER, & ASSOC., INC.**

Engineers Planners Surveyors  
5072 Dorsey Hall Drive, Suite 202, Ellicott City, Maryland 21042  
(410) 997-0296 Balt. (301) 621-5521 Wash. (410) 997-0298 Fax.

DRAWN BY:  
KR

PROJECT NO.:  
98071

SCALE:  
1"=100'

DATE:  
SEPT 1998