

PUB. SEWER STATUS VERIFIED BY \_\_\_\_\_

ISSUE DATE: \_\_\_\_\_

APPROVAL DATE: \_\_\_\_\_

**PERMIT**

**INDEXED**

P 519061-D

A Re-index

**ON-SITE SEWAGE DISPOSAL SYSTEM  
HOWARD COUNTY HEALTH DEPARTMENT  
BUREAU OF ENVIRONMENTAL HEALTH**

**03-289362**

IS PERMITTED TO INSTALL ☐ ALTER ☒

ADDRESS: \_\_\_\_\_ PHONE NUMBER: \_\_\_\_\_

SUBDIVISION: Berndell Farms LOT NUMBER: 5

ADDRESS: 840 River Road PROPERTY OWNER: Frank Loscar

SEPTIC TANK CAPACITY (GALLONS): \_\_\_\_\_

PUMP CHAMBER CAPACITY (GALLONS): \_\_\_\_\_

NUMBER OF BEDROOMS: \_\_\_\_\_

SQUARE FEET PER BEDROOM: \_\_\_\_\_

LINEAR FEET OF TRENCH REQUIRED: \_\_\_\_\_

TRENCHES:	Trench to be _____ feet wide. Inlet _____ feet below original grade. Bottom maximum depth _____ feet below original grade. Effective area begins at _____ feet below original grade. _____ feet of stone below distribution pipe.
LOCATION:	
PURPOSE:	

PLANS APPROVED: \_\_\_\_\_ DATE: \_\_\_\_\_

NOTE: PERMIT VOID AFTER 2 YEARS

NOTE: CONTRACTOR RESPONSIBLE FOR SCHEDULING A PRE-CONSTRUCTION INSPECTION FOR ALL INSTALLATIONS

NOTE: WATERTIGHT SEPTIC TANKS REQUIRED

NOTE: ALL PARTS OF SEPTIC SYSTEM SHALL BE 100 FEET FROM ANY WATER WELL

NOTE: MANHOLE RISERS REQUIRED ON ALL SEPTIC TANKS AND PUMP CHAMBERS

**NEITHER THE HOWARD COUNTY COUNCIL NOR THE HEALTH DEPARTMENT IS  
RESPONSIBLE FOR THE SUCCESSFUL OPERATION OF ANY SYSTEM**

**PERMITTEE RESPONSIBLE FOR OBTAINING FINAL APPROVAL ON THIS PERMIT**

**BUILDING PERMIT SIGNED**

**AND RETURNED**

**CALL 410-313-2640 FOR INSPECTION OF SEPTIC SYSTEM**

7-25-03 B00143201- ROLV BARN

519061-D

10/20/78  
am.  
10/30/78

# PERMIT

P-75098

A-2217

SEWAGE DISPOSAL SYSTEM

MARYLAND STATE DEPARTMENT OF HEALTH

HOWARD COUNTY

ELLCOTT CITY

DISTRICT \_\_\_\_\_

INDEXED

DATE 10/26/78

Mr. Prock, Plumber

IS PERMITTED TO INSTALL ☒ FILTER

ADDRESS \_\_\_\_\_ PHONE 876-2838

SUBDIVISION \_\_\_\_\_ ROAD 600 River Road LOT 5

PROPERTY OWNER John Rogers

ADDRESS \_\_\_\_\_

SPECIFICATIONS 3 Bedrooms

SEPTIC TANK CAPACITY 1000 GALLONS

LEACH FIELD DEPTH FEET, BOTTOM AREA SQ. FT.

DEEP TRENCH DEPTH FEET, BOTTOM AREA SQ. FT.

DISPERSE PITS ACCORDING TO TAIL AREA SQ. FT.

WASTEWATER FT. BELOW SURFACE GRADE, MAXIMUM DEPTH FT. BELOW ORIGINAL GRADE

EFFECTIVE DEPTH AT FT. BELOW ORIGINAL GRADE

LOCATE DISPOSAL AREA FT. FROM LOT LINE AND FT. FROM LOT LINE AS SHOWN

FACING LOT LINE

Trench - to be 30 ft. long with total absorbent area of 455 sq. ft. Inlet to be 4 ft. below grade and maximum depth 9' 6". Begin trench at a point 123 ft. from left lot line, 200 ft. from edge of River Road, or soon when facing lot from River Road, run parallel to River Road towards right lot line.

PLANS APPROVED BY William H. Hays DATE 1/20/79

COVER NO WORK UNTIL INSPECTED AND APPROVED.

NEITHER THE HOWARD COUNTY COUNCIL NOR THE HEALTH DEPARTMENT IS RESPONSIBLE FOR THE SUCCESSFUL OPERATION OF ANY SYSTEM.

NOTE: IF TRENCH IS USED CALL FOR INSPECTION BEFORE PLACING GRAVEL IN TRENCH.

NOTE: NO DRY WELL SHALL EXCEED 18 FOOT IN DIAMETER.

NOTE: ALL PIPE FROM HOUSE TO DISPOSAL AREA MUST BE CAST IRON.

PERMIT VOID AFTER THREE YEARS.

NOTE: INSTALL STAND PIPE ON SEPTIC TANK AND DRY WELL. STAND PIPES MUST BE 6 INCHES IN DIAMETER. CAST IRON, CONCRETE OR TERRAZO.

COTTA ACCEPTED.

INSTALLER IS RESPONSIBLE FOR OBTAINING FINAL APPROVAL ON THIS PERMIT.

HD - 23


BUILD PERMIT SIGNED  
AND RETURNED  
10/26/78  
Prock

1023137



RIVER RD

22137

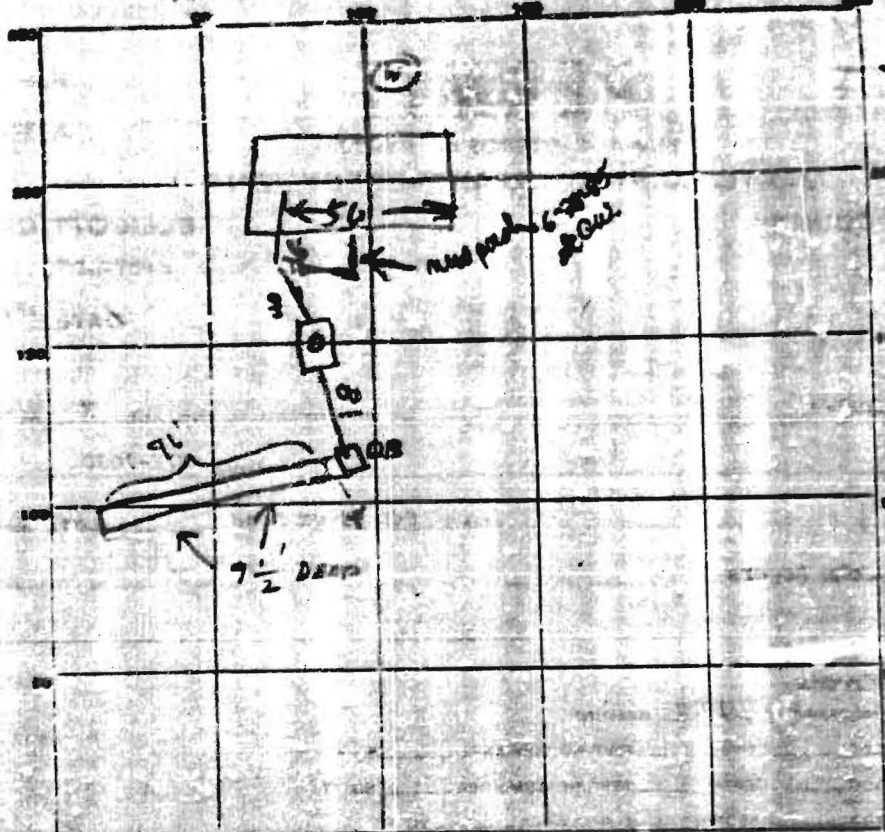

INDICATE NORTH - NAME ADJOINING ROADWAY AS SHOWN LINE

PERMIT CARD 2 NO

SEPTIC TANK, LEVEL ✓

ST/DN  
CLEANOUTS NO  
NEED CEMENT AROUND BOX

DISTRIBUTION BOX, LEVEL OK - NEEDS BUCK NAIL AND NOT TO STAY YES  
DISTRIBUTION BOX

TILE FIELD, DEPTH 7 1/2 FT. TRENCH WIDTH 3 IF NOT NEEDED

TRAVEL DEPTH 76 TOTAL LENGTH 76 FOR ANY ONE DITCH

NUMBER OF TRENCHES 1 TOTAL LENGTH 76  
Y/SIDE 528

SEEPAGE PITS, INSIDE DIAMETER — FT. DEPTH BELOW INLET — FT.

ABSORBENT AREA — SQ. FT.

REMARKS 10/26/78 - OK TO ADD GRAVEL IN TRENCH ✓

DATE SYSTEM APPROVED 10/30/78 INSPECTOR Raymond Hodges