
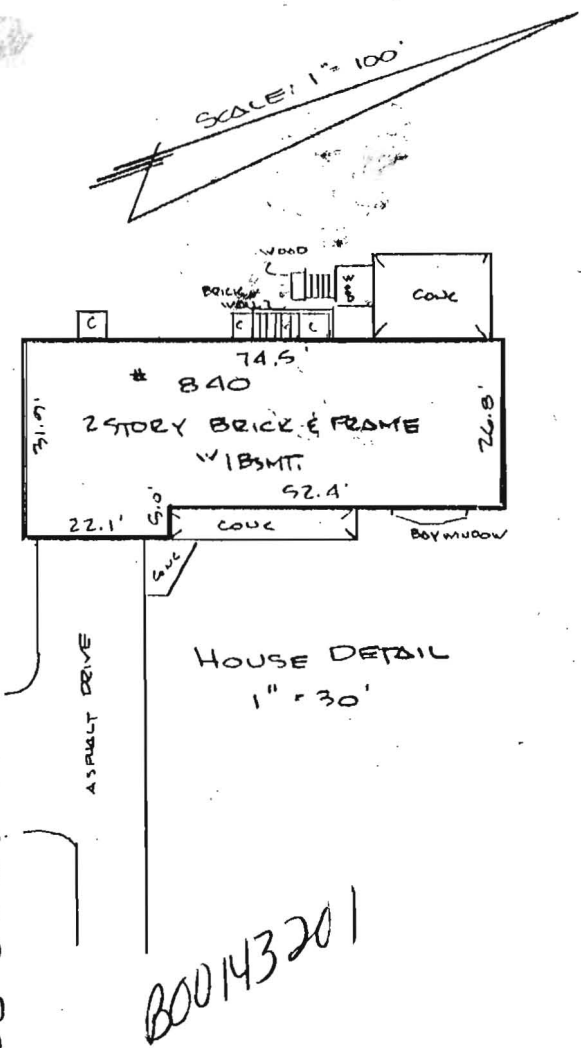


NOTE: The lot shown hereon does not lie within the limits of the 100 year flood plain as shown on FIRM Panel No. 10

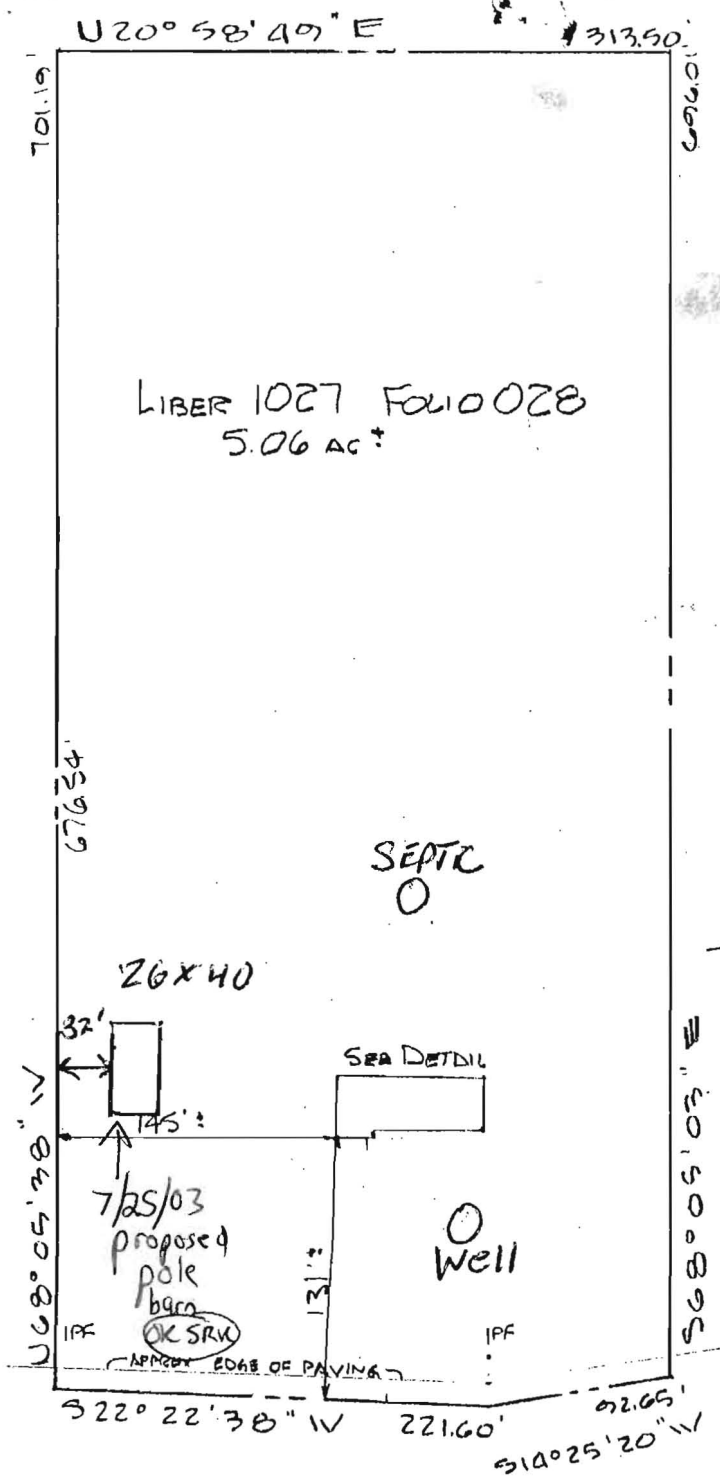

RIVER ROAD

IMPROVEMENT LOCATION SURVEY SURVEYOR'S CERTIFICATE

DEEDA PROPERTY
LIBER 1027 FOLIO 028
HOWARD COUNTY, MD

I hereby certify that the position of all existing improvements on the above described property has been carefully established by a transit-tape survey; and that, unless otherwise shown, there are no encroachments. Unless otherwise shown, corners have not been set with this survey. This survey is not to be used to determine property lines.

Michael J. Bazis
Michael J. Bazis PLS#283

JOB #	88.2502.U	DATE	10-26-88
FIELD	JKS	DRAFT	KAWD
		P.B.	P#
		SCALE:	1" = 100'


R.C. KELLY & ASSOCIATES, INC.
LAND SURVEYORS
10111 COLESVILLE ROAD
SUITE 123
SILVER SPRING, MD 20901
593-8005

The lot shown hereon complies with the minimum ownership and lot area as required by the Maryland State Health Department.

APPROVED: Private Water & Private Sewer

John J. Webb
Howard County Health Officer

• Perc Holes
Field Located

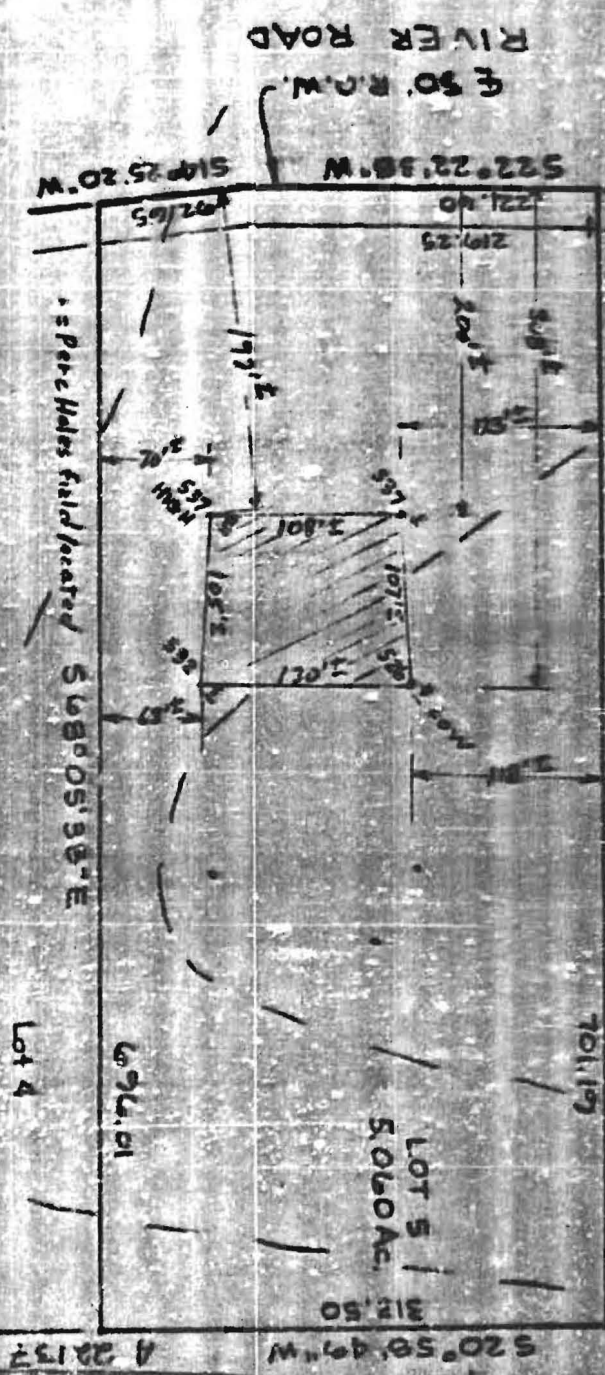

SUB 05° 38' E

701.17

Lot 6

LOT 5
506.04'

312.50

Lot 4

694.01

• Perc Holes field located SUB 05° 38' E

RIVER ROAD
E 50' R.O.W.

S 22° 22' 38\" W

S 14° 25' 20\" W

REFERENCE

MERIDIAN

MAP

3rd E

RICHARD P. BROWNE ASSOCIATES
CONSULTING ENGINEERS, PLANNERS
BAYVIEW, AL

SCALE 1\"/>

PROJECT No. W. O. No.

DRAWN