


22137

Depth in 2 to trench for 6 → 5
 max depth 12'
 vicinity of 5, max depth 8'

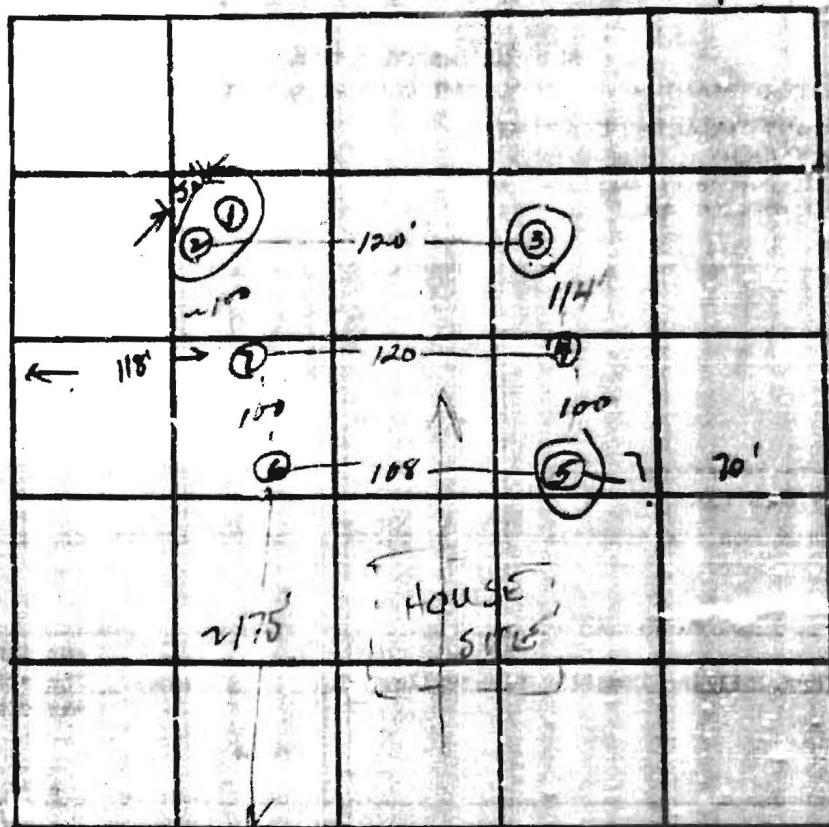

BP# 34128

Rogers
Elmorelot 5
5.00 acres

Bundled at

6 ft 4"

135 ft or

RIVER ROAD → N

DATE	TEST NO.	DEPTH	PRE-TEST START	STOP	TEST - 1" DROP START	STOP	TIME
10/21/75	1	10 1/2	Water				8'
	2	10	Water				
	3	6	1:44	1:46	1:46	1:46	2
	3-A	12	1:44			2:05	No movement
	4	4 1/2	2:08	2:10	2:10	2:14	4
	4-A	12	2:08	2:11	2:11	2:16	5
	5	10	Visual				Rock @ 10' good for 4'
	6	6	2:20	2:23	2:23	2:28	5
	6-A	11 1/2	2:20	2:25	2:25	2:35	10
	7	4 1/2	2:30	2:33	2:33	2:50	12
	7-A	11	2:33	2:35	2:35	2:53	12

REMARKS

3 is same as 2

TYPE OF SOIL

clay → sandy → rock/fine

TESTED BY

WWE

ALSO PRESENT

Leland