

Health

DEPARTMENT OF INSPECTIONS, LICENSES AND PERMITS 3430 COURT HOUSE DRIVE ELICOTT CITY, MD 21043 PERMITS (410) 313-2456 INSPECTIONS (410) 313-1810 AUTOMATED INFORMATION (410) 313-3800	HOWARD COUNTY PERMIT APPLICATION	PERMIT NUMBER B-0143587
--	---	-----------------------------------

Building Address <u>4149 Sharp Rd</u> <u>Glenelg, MD 21737</u>	Property Owner's Name <u>Wendy + Chet Dahlgett</u> Address <u>4149 Sharp Rd</u>
Suite/Apt. #: _____ SDP/WP/Petition #: _____	City <u>Glenelg</u> State <u>MD</u> Zip Code <u>21737</u>
Census Tract <u>6-05101</u> Subdivision <u>The Heritage</u>	Home Phone <u>443-398-5910</u> Work Phone _____
Section <u>1</u> Area _____ Lot <u>2</u>	Applicant's Name & Mailing Address, (if other than stated hereon): _____
Tax Map _____ Parcel _____ Grid _____	Phone _____ Fax _____
Zoning _____ Map Coordinates <u>9F11</u> Lot size <u>1.018 ac</u>	
Existing Use <u>Single family Dwelling</u>	Contractor Company <u>B Square Construction</u>
Proposed Use <u>Covered front porch</u>	Contact Person <u>Barry Boone</u>
Estimated Construction Cost \$ <u>5,500</u>	Address <u>2420 Alee's Dr.</u>
Description of Work <u>Construct covered front porch</u> <u>on existing SFD, 6' x 38' w/ steps to</u> <u>grade, tie-like porch surface, trussed</u> <u>roof w/ asphalt shingles</u>	City <u>New Windsor</u> State <u>MD</u> Zip Code <u>21738</u>
Occupant or Tenant _____	License No. <u>80372</u>
Contact Name _____	Phone <u>443-864-8550</u> Fax <u>410-875-9455</u>
Address _____	Engineer or Architect Company _____
City _____ State _____ Zip Code _____	Contact Person <u>N/A</u>
Phone _____ Fax _____	Address _____
	City _____ State _____ Zip Code _____
	Phone _____ Fax _____

BUILDING DESCRIPTION - <u>COMMERCIAL</u>		BUILDING DESCRIPTION - <u>RESIDENTIAL</u>	
Building Characteristics	Utilities	Building Characteristics	Utilities
Height: _____	Water Supply: _____ Public _____ Private _____	SF Dwelling <input type="checkbox"/> SF Townhouse <input type="checkbox"/> Depth _____ Width _____	Water Supply: _____ Public <input checked="" type="checkbox"/> Private _____
No. of stories: _____	Sewage Disposal: _____ Public _____ Private _____	1st floor: _____	Sewage Disposal: _____ Public <input checked="" type="checkbox"/> Private _____
Gross area, sq. ft. per floor: _____	Electric Yes <input type="checkbox"/> No <input type="checkbox"/> Gas Yes <input type="checkbox"/> No <input type="checkbox"/>	2nd floor: _____	Electric Yes <input type="checkbox"/> No <input type="checkbox"/> Gas Yes <input type="checkbox"/> No <input type="checkbox"/>
Use group: _____	Heating System: _____ Electric <input type="checkbox"/> Oil <input type="checkbox"/> Natural Gas <input type="checkbox"/> Propane Gas <input type="checkbox"/>	Basement: _____	Heating System: _____ Electric <input type="checkbox"/> Oil <input type="checkbox"/> Natural Gas <input type="checkbox"/> Propane Gas <input type="checkbox"/>
Construction type: _____ Reinforced Concrete _____ Structural Steel _____ Masonry _____ Wood Frame _____	Sprinkler system: N/A <input type="checkbox"/> Full _____ Partial _____ Other Suppression _____ # of Heads _____	Finished Basement <input type="checkbox"/> Unfinished Basement <input type="checkbox"/> Crawl space <input type="checkbox"/> Slab on Grade <input type="checkbox"/> No. of Bedrooms _____	Sprinkler system: N/A <input type="checkbox"/> NFA #13D _____ NFA #13R _____ Other: _____
State Certified Modular _____		Multi-family dwellings: No. of efficiency units: _____ No. of 1 BR units: _____ No. of 2 BR units: _____ No. of 3 BR units: _____	
		Other Structure: _____ Dimensions: _____ Footings: _____ Roof: _____	
		State Certified Modular _____ Manufactured Home _____	

THE UNDERSIGNED HEREBY CERTIFIES AND AGREES AS FOLLOWS: (1) THAT HE/SHE IS AUTHORIZED TO MAKE THIS APPLICATION; (2) THAT THE INFORMATION IS CORRECT; (3) THAT HE/SHE WILL COMPLY WITH ALL REGULATIONS OF HOWARD COUNTY WHICH ARE APPLICABLE THERETO; (4) THAT HE/SHE WILL PERFORM NO WORK ON THE ABOVE REFERENCED PROPERTY NOT SPECIFICALLY DESCRIBED IN THIS APPLICATION; (5) THAT HE/SHE GRANTS COUNTY OFFICIALS THE RIGHT TO ENTER ONTO THIS PROPERTY FOR THE PURPOSE OF INSPECTING THE WORK PERMITTED AND POSTING NOTICES.

<u>Barry Boone</u> Applicant's Signature <u>Owner</u> Title/Company	<u>Barry Boone</u> Print Name <u>8/13/03</u> Date
--	--

Checks payable to: **DIRECTOR OF FINANCE OF HOWARD COUNTY**
** PLEASE WRITE NEATLY AND LEGIBLY. **
- FOR OFFICE USE ONLY -


AGENCY	DATE	SIGNATURE APPROVAL	DPZ SETBACK INFORMATION	PROPERTY ID#
✓ Land Development, DPZ			Front: _____	59250
✓ State Highways			Rear: _____	Filing fee \$ <u>25</u>
✓ Building Official	<u>8/13/03</u>	<u>[Signature]</u>	Side: _____	Permit fee \$ <u>41</u>
✓ Dev. Engineering, DPZ			Side St: _____	Excise tax \$ _____
✓ Health	<u>8/13/03</u>	<u>Steven R. Zuey</u>	All minimum setbacks met? YES <input type="checkbox"/> NO <input type="checkbox"/>	Add'l per. fee \$ <u>5</u>
Fire Protection			Is Entrance Permit required? YES <input type="checkbox"/> NO <input type="checkbox"/>	TOTAL FEES \$ <u>71</u>
Is Sediment Control approval required prior to issuance? YES <input type="checkbox"/> NO <input type="checkbox"/>			Historic District? YES <input type="checkbox"/> NO <input type="checkbox"/>	Sub-total paid \$ _____
CONTINGENCY CONSTRUCTION START: <input type="checkbox"/>			Lot Coverage for New Town Zone _____	Balance due \$ _____
ONE STOP SHOP: <input type="checkbox"/>			SDP/Red-line approval date _____	Check # <u>1982</u>
				Validation # <u>32538</u>

Distribution of Copies- White: Building Official Green: LDD, DPZ Yellow: DED, DPZ Pink: Health Gold: SHA


SHARP


601 R/34


刀口

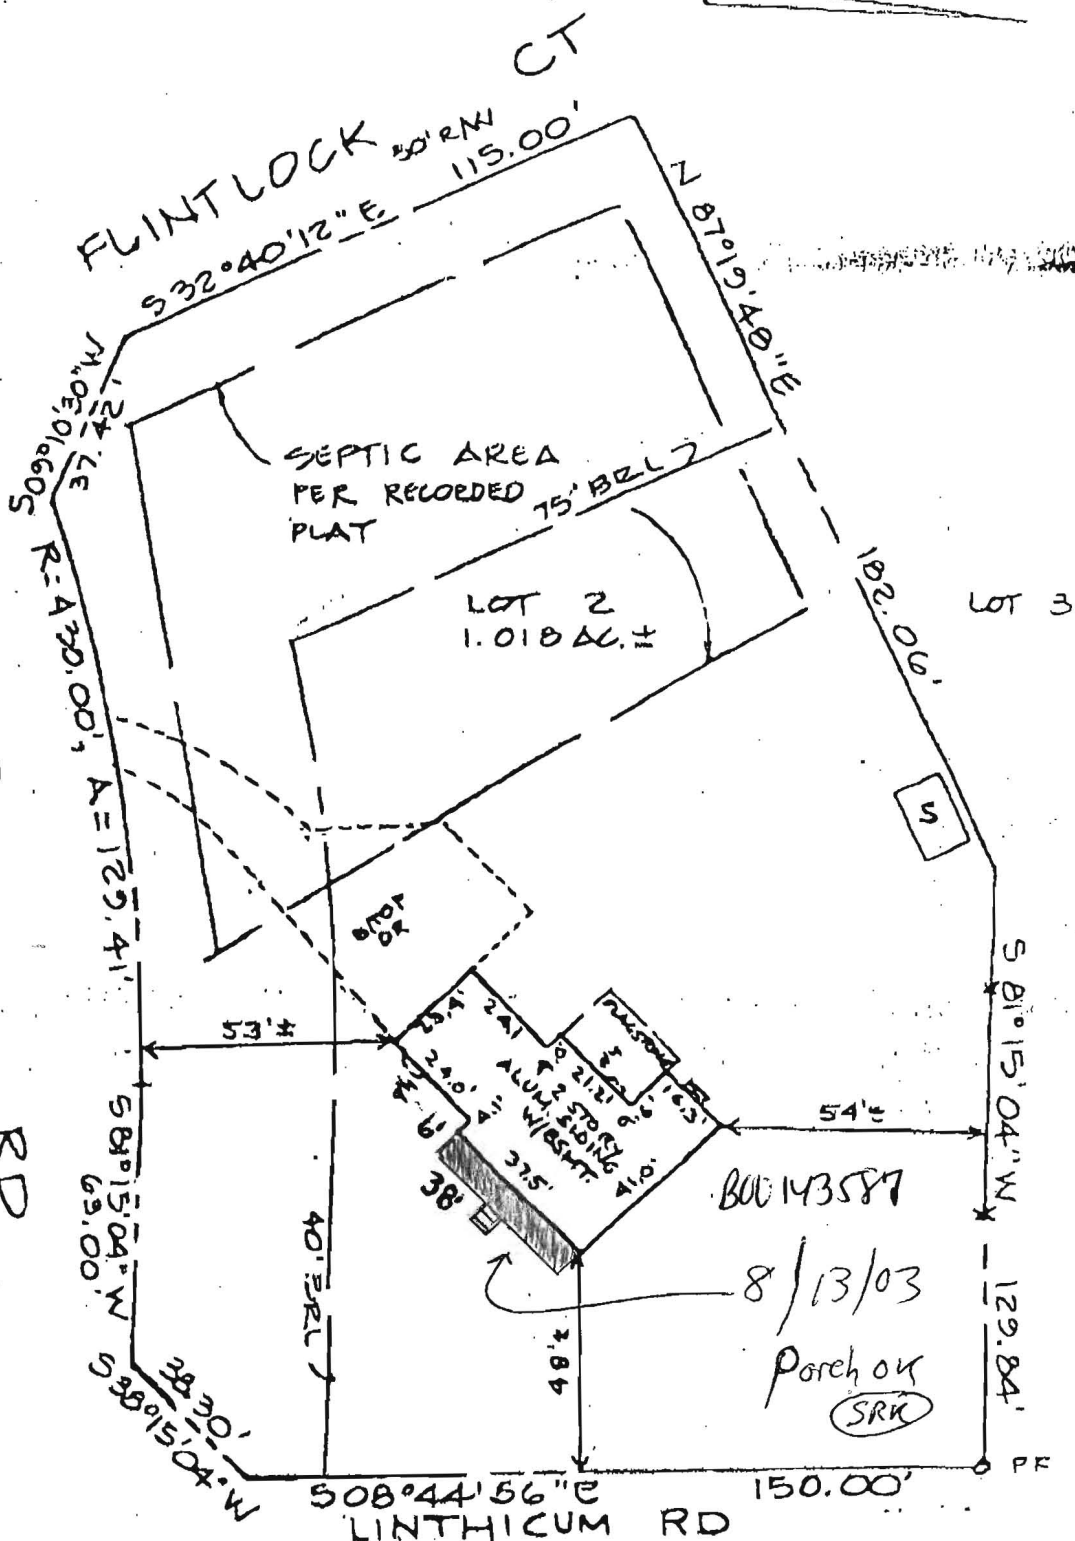


LEGEND

Shed (unsurveyed) 

Blacktop Drive 

Gravel Drive 

Concrete Drive 


This is an Improvements Location Survey only, and must not be used for Boundary purposes. No Title Report furnished. No statement is made as to ownership of property or right or interest therein. Fences are approximate only and may not be shown.



SBC 1 1000 2
 THE HERITAGE
 BOOK:
 Folio: #3775
 Dist: 5
 Co: HOWARD
 MD
 Scale 1"=40'

APPROVED

WALK-THRU BUILDING PERMIT CT
 BP# B00159140 A# 519063
 APP. SAN OF DATE: 11-5-00
 DESC. OF WORK: 16'x16' addition (1-story)

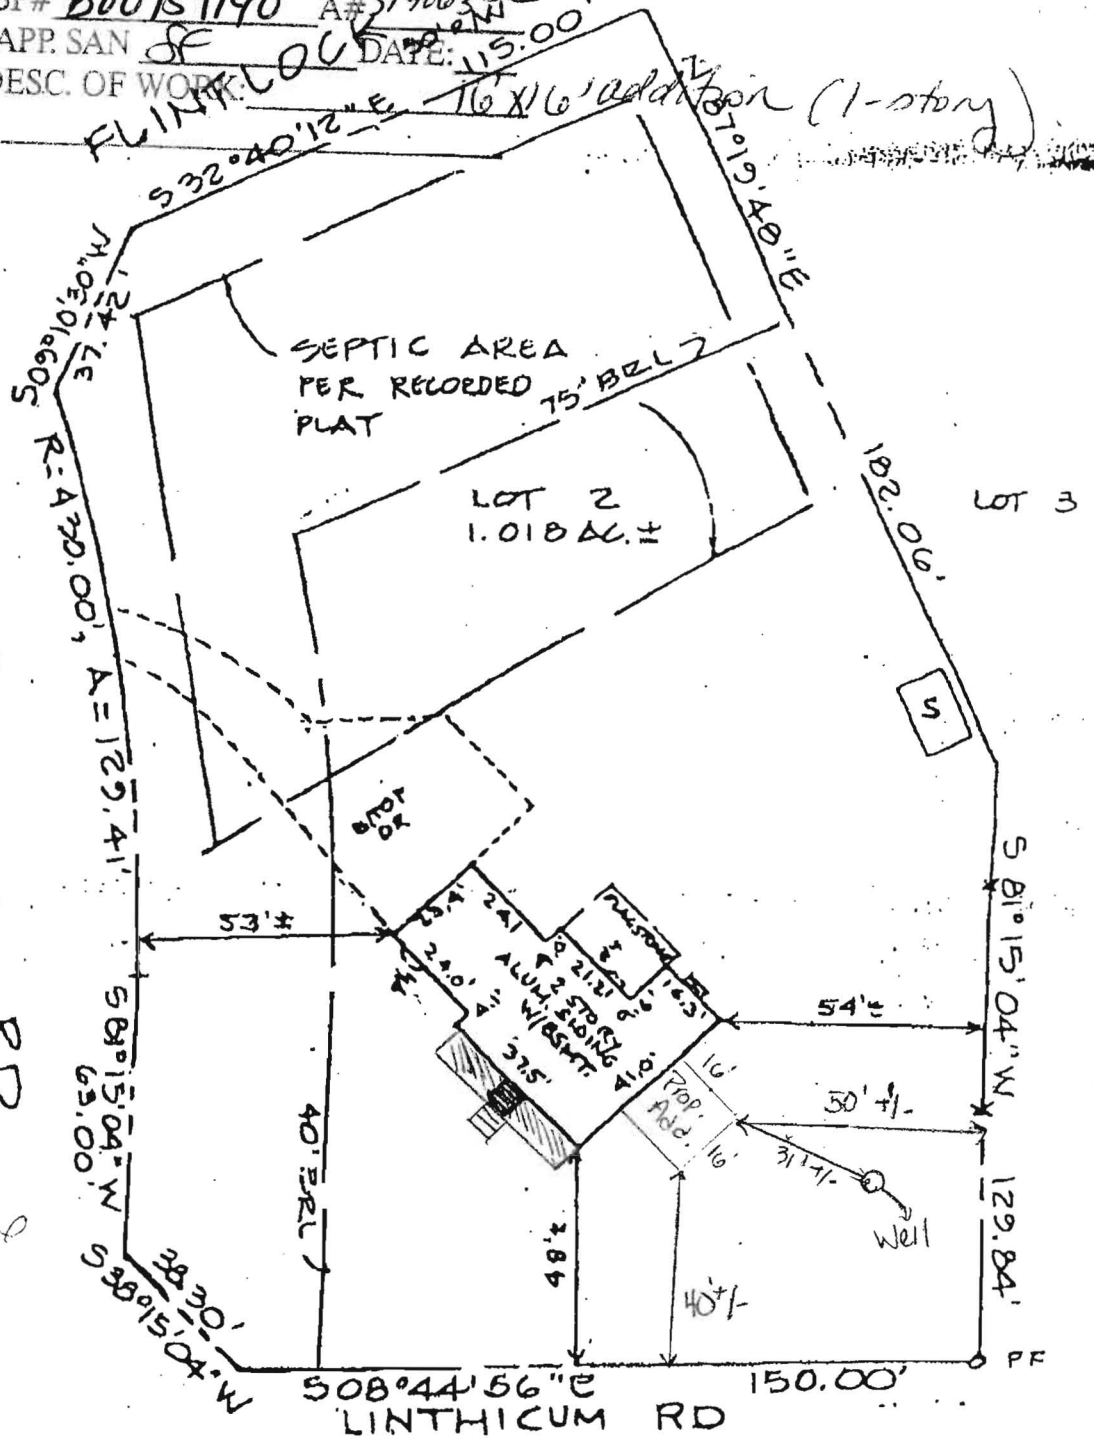

Owner
 Ref + Wendy Daulat
 1149 Sharp Rd
 Glenelg, MD
 21737
 413-398-5910

Builder/Contractor
 B Square Contr, Inc.
 2420 Lees Dr
 New Windsor, MD
 110-635-6511
 21774

SHARP RD
 60' R/W

Accuracy: Approximate average accuracy (SD of sideline distances) for small suburban lots is two feet, and for large lots and metes and bounds parcels varies from two feet to twenty feet. In case of doubt, we recommend a Boundary Survey.

LEGEND	
Shed (unsurveyed)	[S]
Blacktop Drive
Gravel Drive	=====
Concrete Drive	=====

This is an Improvements Location Survey only, and must not be used for Boundary purposes. No Title Report furnished. No statement is made as to ownership of property or right or interest therein. Fences are approximate only and may not be shown.



4104890814

JUL-30-2003 09:15 PM DAULAT