

1 9560 SEQUENCE NO. (KEEP USE ONLY)
(THIS NUMBER IS TO BE PUNCHED IN COLS. 34 ON ALL CARDS)

STATE OF MARYLAND
WELL COMPLETION REPORT
FILL IN THIS FORM COMPLETELY
PLEASE PRINT OR TYPE

THIS REPORT MUST BE SUBMITTED WITHIN
45 DAYS AFTER WELL IS COMPLETED

COUNTY NUMBER **A22266**

DATE RECEIVED
[] [] [] [] [] []

DATE WELL COMPLETED
030883

Depth of Well
160
(TO NEAREST FOOT)

PERMIT NO. **864**
FROM "PERMIT TO DRILL WELL"
90-87-0056

OWNER **KNECHT ENTERPRISES**

STREET OR RFD last name **FLINTLOCK CT**

first name **TOWN GLENVIEW**

SUBDIVISION **THE HERITAGE**

SECTION **1**

LOT **2**

WELL LOG
Not required for driven wells
STATE THE KIND OF FORMATIONS
PENETRATED, THEIR COLOR, DEPTH,
THICKNESS AND IF WATER BEARING

DESCRIPTION (See additional sheets if needed)	FEET FROM	TO
Top Soil	0	2
Silt	2	40
Sand Stone	40	45
Mica	45	60
Sand Stone	60	65
Mica	65	160

WELL HAS BEEN: CROCKETED
(Circle Appropriate Box)
TYPE OF CROCKETING MATERIAL
CONJ. **CM** BENTONITE CLAY **BC**

NO. OF BASE **NO** COMPOUNDS
GALLONS OF WATER
DEPTH OF CROCKET SEAL (to nearest foot)
0 **1** **2** **3** **4** **5** **6** **7** **8** **9** **10**

Casing Record
casing type insert appropriate code below
ST **CO** **PL** **OT**
STEEL CONCRETE PLASTIC OTHER

MAIN CASING TYPE
Nominal diameter (nearest inch) Total depth (nearest foot)
PL **4** **50**

OTHER CASING (if used)
diameter (nearest inch) depth (nearest foot)
4 **50**

SCREEN RECORD
screen type or open hole insert appropriate code below
ST **BP** **HO**
STEEL BRASS OPEN HOLE PLASTIC OTHER

DEPTH OF SCREEN (to nearest foot)
1 **2** **3** **4** **5** **6** **7** **8** **9** **10**

LOT SIZE 1 2 3
DIAMETER OF SCREEN (NEAREST INCH)
4 **5** **6** **7** **8** **9** **10**

GRAVEL PACK
IF WELL DRILLED WAS FLOWING WELL INSERT F IN BOX 66

TELESCOPE CASING
LOG INDICATION
NO **YES** **OTHER DATA**

HOURS PUMPED (nearest hour)
3

PUMPING RATE (gal. per min. to nearest gal.)
1 **2** **3** **4** **5** **6** **7** **8** **9** **10**
MEASURED OR BY SO
WATER LEVEL (distance from land surface)
1 **2** **3** **4** **5** **6** **7** **8** **9** **10**

WATER PUMPING
TYPE OF PUMP USED (for test)
A **P** **T**
AIR LIFT PISTON TURBINE

C **R** **O**
CENTRIFUGAL ROTARY OTHER (specify below)


PUMP INSTALLED
DRILLER WILL INSTALL PUMP (CIRCLED OR "X")
IF DRILLER INSTALLS PUMP, THIS SECTION MUST BE COMPLETED FOR ALL WELLS

TYPE OF PUMP INSTALLED
PLACE (A, C, P, R, A, T, O) IN BOX - SEE ABOVE
CAPACITY: GALLONS PER MINUTE (to nearest gallon)
1 **2** **3** **4** **5** **6** **7** **8** **9** **10**

PUMP HORSE POWER
1 **2** **3** **4** **5** **6** **7** **8** **9** **10**
PUMP COLUMN LENGTH (nearest ft.)
1 **2** **3** **4** **5** **6** **7** **8** **9** **10**

CASING HEIGHT (circle appropriate box and enter casing height)
2 **3** **4** **5** **6** **7** **8** **9** **10**
LAND SURFACE (nearest foot)
1 **2** **3** **4** **5** **6** **7** **8** **9** **10**

LOCATION OF WELL ON LOT
SHOW PERMANENT STRUCTURE SUCH AS BUILDING, SEPTIC TANKS, BARN, LANDMARKS AND INDICATE NOT LESS THAN TWO DISTANCES (MEASUREMENTS TO WELL)

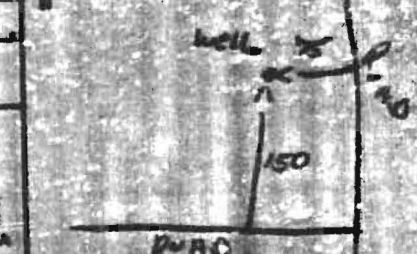

CIRCLE APPROPRIATE LETTER
A WELL WAS ABANDONED AND CEASED WHEN THIS WELL WAS COMPLETED
E ELECTRIC LOG OBTAINED
P TEST WELL CONVERTED TO PRODUCTION WELL

I HEREBY CERTIFY THAT THIS WELL HAS BEEN CONSTRUCTED IN ACCORDANCE WITH COMPA 18.17 "WELL CONSTRUCTION" AND IN CONFORMANCE WITH ALL CONDITIONS SET FORTH IN THE ABOVE CAPTIONED PERMIT, AND THAT THE INFORMATION PRESENTED HEREIN IS ACCURATE AND COMPLETE TO THE BEST OF MY KNOWLEDGE.

DRILLER'S IDENT. NO. **223**
Ralph Mayne


DRILLER'S SIGNATURE
MUST MATCH SIGNATURE ON ASSIGNMENT
Ralph E. Mayne

SITE SUPERVISOR (sign. of driller or person responsible for placement, if different from permittee)

SEC 1, T10N, R10E
 THE HERITAGE
 BOOK:
 Folio: #3775
 Dist: 5
 Co: HOWARD
 MD
 Scale 1"=40'

Please
 show
 St. Location
 & well
 on plan
 Deck being
 built
 over
 existing
 patio - OK
 (KN)

[Handwritten signature]

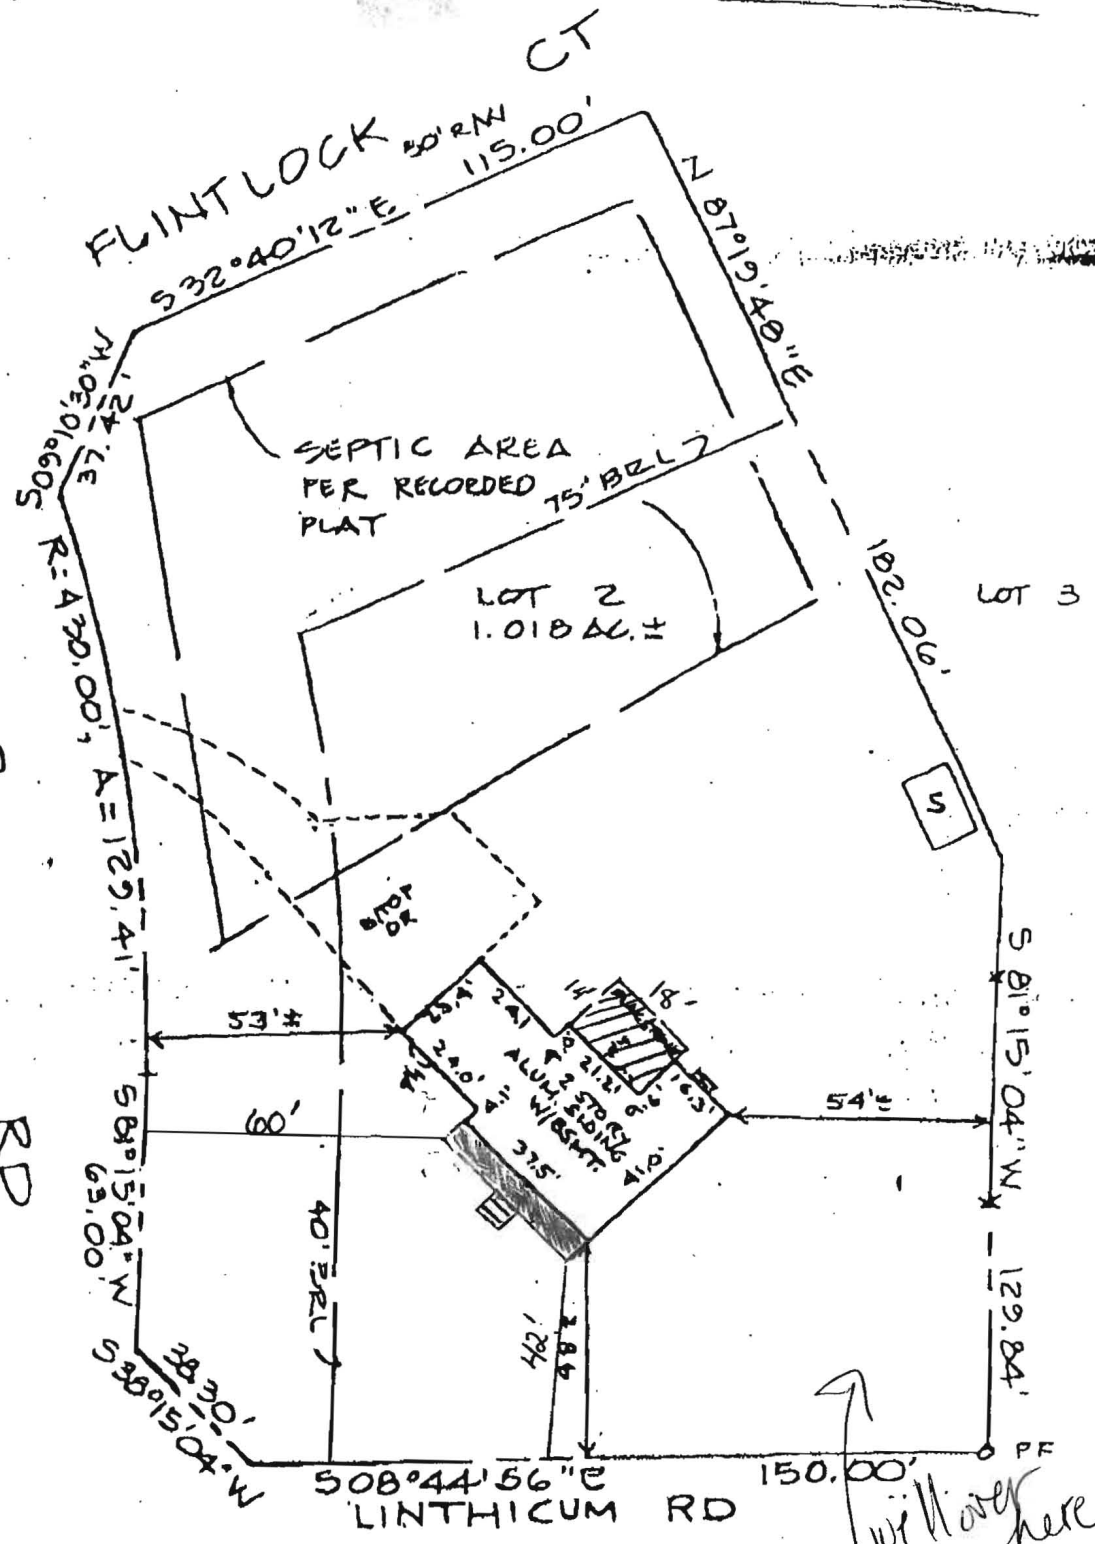

Accuracy: Approximate average accuracy (SD of sideline distances) for sma suburban lots is two feet. and for large lots and metes and bounds parcels values 110 two feet to twenty feet. In case of doubt, we recommend a Boundary Survey

LEGEND	
Shed (unsurveyed)	[S]
Blacktop Drive	=====
Gravel Drive	====
Concrete Drive	=====

This is an Improvements Location Survey only, and must not be used for Boundary purposes. No Title Report furnished. No statement is made as to ownership o property or right or interest therein. Fences are approximate only and may not be shown

