

10/27/64

PERMIT

SEWAGE DISPOSAL SYSTEM

MARYLAND STATE DEPARTMENT OF HEALTH

HOWARD COUNTY

ELLICOTT CITY

DISTRICT 3

DATE 9/26/64

INDEXED

Approved
10/27/64
R.F.
09097
01123

Howard Seeger IS PERMITTED TO INSTALL X ALTER

ADDRESS Laurel, Maryland PHONE PA 7-8326

A SEWAGE DISPOSAL SYSTEM LOCATED AT _____

SUBDIVISION Bea Property ROAD Staborn Drive LOT 6

PROPERTY OWNER Stanley Bea

ADDRESS Murray Rd. Fulton, Md.

SPECIFICATIONS 3 bedrooms

DRAIN FIELD _____ DEPTH _____ FEET, BOTTOM AREA _____ SQ. FT.

RECEPAGE PITS _____ ABSORBENT SIDE-WALL AREA _____ SQ. FT.

SEPTIC TANK CAPACITY 750 GALLONS

FOR GARBAGE GRINDER, INCREASE DISPOSAL AREA 22% & TANK CAPACITY 50%.


OTHER Dry well - 300 sq. ft. side wall area below the inlet pipe.
Place dry well about 150 ft. from front lot line and about 40 ft.
from left side line as seen when facing lot from Staborn Drive.

PLANS APPROVED BY T. J. Gravel DATE 9/23/64

FILL SEPTIC TANK AND DISTRIBUTION BOX WITH WATER BEFORE CALLING FOR AN INSPECTION. COVER NO WORK UNTIL INSPECTED AND APPROVED.

NEITHER THE HOWARD COUNTY COMMISSIONERS NOR THE HEALTH DEPARTMENT IS RESPONSIBLE FOR THE SUCCESSFUL OPERATION OF ANY SYSTEM.

A 01123

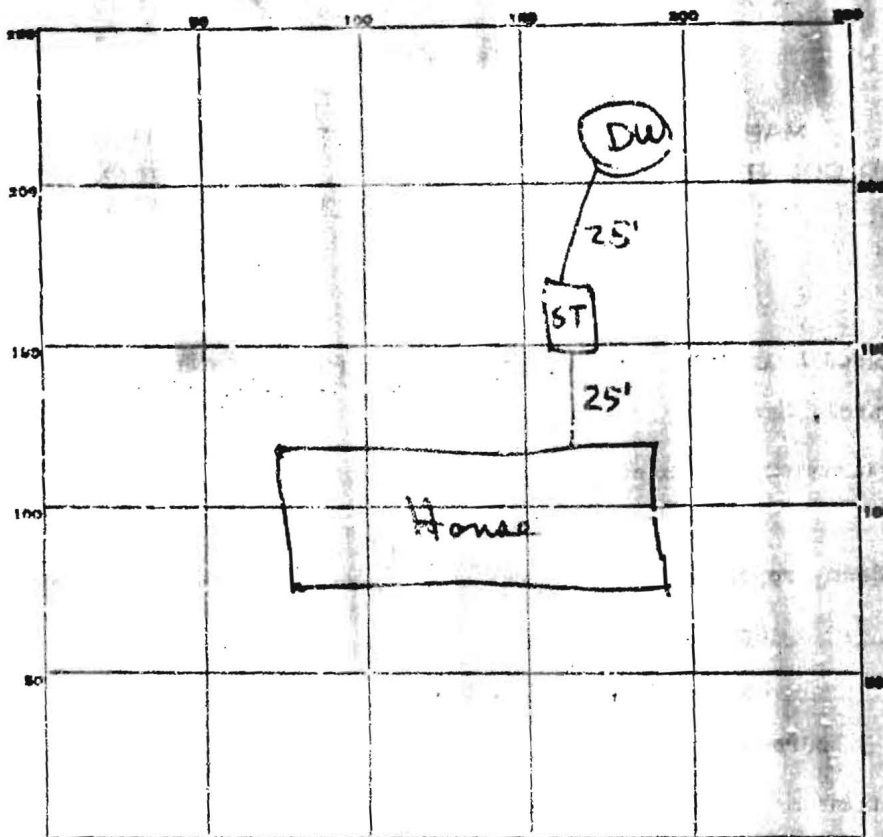

Stable Dr.

PERMIT CARD OK

SEPTIC TANK, LEVEL OK

CLEANOUTS OK

DISTRIBUTION BOX, LEVEL

TILE FIELD, DEPTH _____ FT. TRENCH WIDTH _____ FT.

GRAVEL DEPTH _____ IN. TOTAL LENGTH _____ FT.

NUMBER OF TRENCHES _____ TOTAL BOTTOM AREA _____

SELFAGE PITS, INSIDE DIAMETER 10 FT DEPTH BELOW INLET 9 FT.

ABSORBENT AREA 286 SQ. FT.

REMARKS DW & DW $\phi = 12\text{ ft} = 310\text{ sq ft. sidewalk area}$
(Don't know location of well)

DATE SYSTEM APPROVED 10/27/62

INSPECTOR R. F. Little