

HOWARD COUNTY
PERMIT APPLICATION

PERMIT NUMBER

308001512

Building Address 8170 Stabean Drive

Property Owner's Name Daniel + Laurie Greene

Address 8170 Stabean Drive

Suite/Apt. #: _____ SDP/M/P/Petition #: _____

Census Tract _____ Subdivision _____

City Fulton State MO Zip Code 20759

Section _____ Area _____ Lot _____

Home Phone 301 317 6836 Work Phone 410 225 8140

Tax Map _____ Parcel _____ Grid _____

Applicant's Name & Mailing Address, (if other than stated hereon):

Zoning _____ Map Coordinates _____ Lot size _____

Phone _____ Fax _____

Existing Use _____

Contractor Company _____

Proposed Use _____

Contact Person _____

Estimated Construction Cost \$ _____

Description of Work build deck 38'x14' WITH
steps, elevated partially

Address _____

City _____ State _____ Zip Code _____

License No. _____

Phone _____ Fax _____

Occupant or Tenant Daniel + Laurie Greene

Engineer or Architect Company _____

Contact Name Daniel or Laurie Greene

Contact Person _____

Address 8170 Stabean Drive

Address _____

City Fulton State MO Zip Code 20759

City _____ State _____ Zip Code _____

Phone 301 317 6836 Fax 301 317 6836

City _____ State _____ Zip Code _____

Phone _____ Fax _____

BUILDING DESCRIPTION - COMMERCIAL

BUILDING DESCRIPTION - RESIDENTIAL

Building Characteristics

Utilities

Height: _____

Water Supply:

No. of stories: _____

Public _____

Private _____

Gross area, sq. ft. per floor: _____

Sewage Disposal:

Public _____

Private _____

Use group: _____

Electric Yes ☐ No ☐

Gas Yes ☐ No ☐

Construction type:

Heating System:

Electric ☐ Oil ☐

Natural Gas ☐

Propane Gas ☐

Sprinkler system: N/A ☐

Full _____

Partial _____

Other Suppression _____

of Heads _____

State Certified Modular _____

Building Characteristics

Utilities

SF Dwelling ☐ SF Townhouse ☐

Depth _____ Width _____

1st floor: _____

2nd floor: _____

Basement: _____

Finished Basement ☐ Unfinished Basement ☐

Crawl space ☐ Slab on Grade ☐

No. of Bedrooms _____

Height: _____

Multi-family dwellings:

No. of efficiency units: _____

No. of 1 BR units: _____

No. of 2 BR units: _____

No. of 3 BR units: _____

Other Structure: _____

Dimensions: _____

Footings: _____

Roof Height: _____

State Certified Modular _____

Manufactured Home _____

Water Supply:

Public _____

Private ☒

Sewage Disposal:

Public _____

Private ☒

Electric Yes ☐ No ☐

Gas Yes ☐ No ☐

Heating System:

Electric ☐ Oil ☐

Natural Gas ☐

Propane Gas ☐

Sprinkler system: N/A ☐

NFPA #13D _____

NFPA #13R _____

Other: _____

THE UNDERSIGNED HEREBY CERTIFIES AND AGREES AS FOLLOWS: (1) THAT HE/SHE IS AUTHORIZED TO MAKE THIS APPLICATION; (2) THAT THE INFORMATION IS CORRECT; (3) THAT HE/SHE WILL COMPLY WITH ALL REGULATIONS OF HOWARD COUNTY WHICH ARE APPLICABLE THERETO; (4) THAT HE/SHE WILL PERFORM NO WORK ON THE ABOVE REFERENCED PROPERTY NOT SPECIFICALLY DESCRIBED IN THIS APPLICATION; (5) THAT HE/SHE GRANTS COUNTY OFFICIALS THE RIGHT TO ENTER ONTO THIS PROPERTY FOR THE PURPOSE OF INSPECTING THE WORK PERMITTED AND POSTING NOTICES.

Laurie M. Greene

Applicant's Signature

Laurie M. Greene

Print Name

5/21/08

Date

Title/Company

Checks payable to: **DIRECTOR OF FINANCE OF HOWARD COUNTY**

** PLEASE WRITE NEATLY AND LEGIBLY. **

- FOR OFFICE USE ONLY -

AGENCY DATE SIGNATURE APPROVAL

Land Development, DPZ

State Highways

Building Official

Dev. Engineering, DPZ

Health

Fire Protection

Is Sediment Control approval required prior to issuance?

YES ☐ NO ☐

CONTINGENCY CONSTRUCTION START: ☐

ONE STOP SHOP: ☐

Distribution of Copies

White: Building Official

Green: LDD, DPZ

T:\forms\PERMIT.FRM

DPZ SETBACK INFORMATION

Front: _____

Rear: _____

Side: _____

Side St.: _____

All minimum setbacks met?

YES ☐ NO ☐

Is Entrance Permit required?

YES ☐ NO ☐

Historic District?

YES ☐ NO ☐

Lot Coverage for New/Town Zone _____

SDP/Red-line approval date _____

Yellow: DED, DPZ


Pink: Health

Gold: SHA

Accepted by _____

Rev. 11/4/04

LH9837-9 8170 STABEAN DR FULTON HOW 4/6/98 LEAM Case#REMM
 Fema Panel: 240044 0042B
 Flood Zone: C
 LOT 6
 BEAN PROPERTY
 Book: 9
 Folio: 89
 Dist: 5
 Co: HOWARD
 MD
 Scale 1"=40'

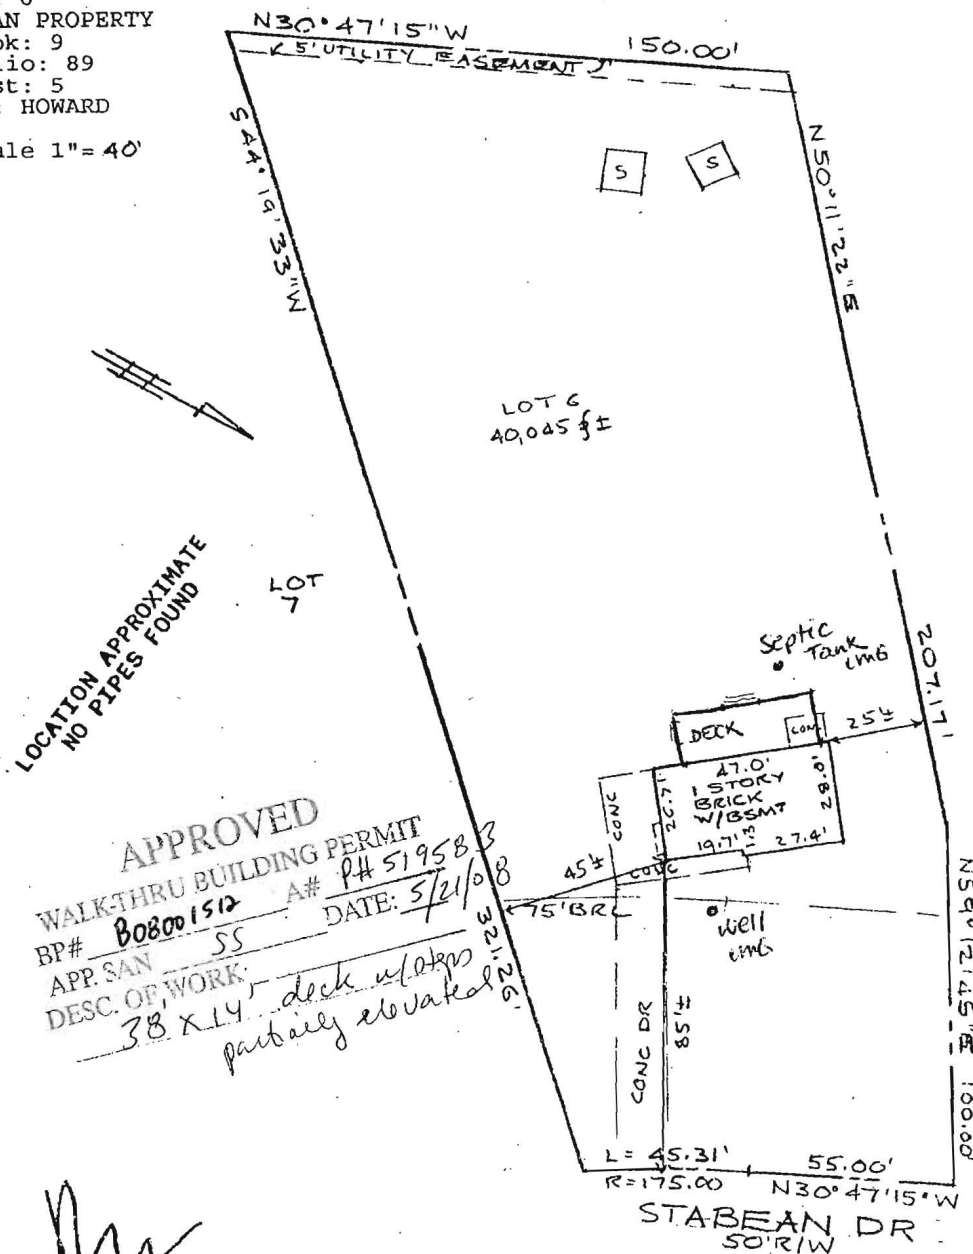

Accuracy: Approximate average accuracy (SD of sideline distances) for small suburban lots is two feet, and for large lots and metes and bounds parcels varies from two feet to twenty feet. In case of doubt, we recommend a Boundary Survey.



DAVID M. GREEN, Prop LS 311 MD
 Executive Vice President

LEGEND
 Shed (unsurveyed) [S]
 Blacktop Drive
 Gravel Drive
 Concrete Drive =====

This is an Improvements Location Survey only, and must not be used for Boundary purposes. No Title Report furnished. No statement is made as to ownership of property or right or interest therein. Fences are approximate only and may not be shown. Not to be used for construction purposes (incl. permits) of any kind.

SURVEY ASSOCIATES OF MARYLAND INC

9420 ANNAPOLIS ROAD
 LANHAM MD 20706
 TEL 301 459 2760
 FAX 301 459 4409

LOCATION
 SURVEY

108 OLD SOLOMONS ISLAND RD #100
 ANNAPOLIS MD 21401
 TEL 410 266 7211
 FAX 410 266 0918