

Addition To garage (Tractor shed)

John P. Wilkerson

KT-216

12/17/03

Proposed Tractor
Shed Addition O.K.



(BB)

$$\begin{array}{r} 6 \\ 28 \\ \times 18 \\ \hline 224 \\ 28 \\ \hline 504 \end{array}$$

Addition

504 Square Feet

46'

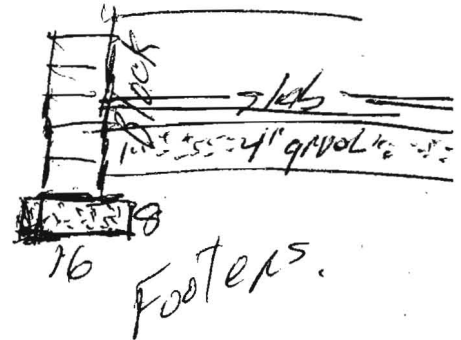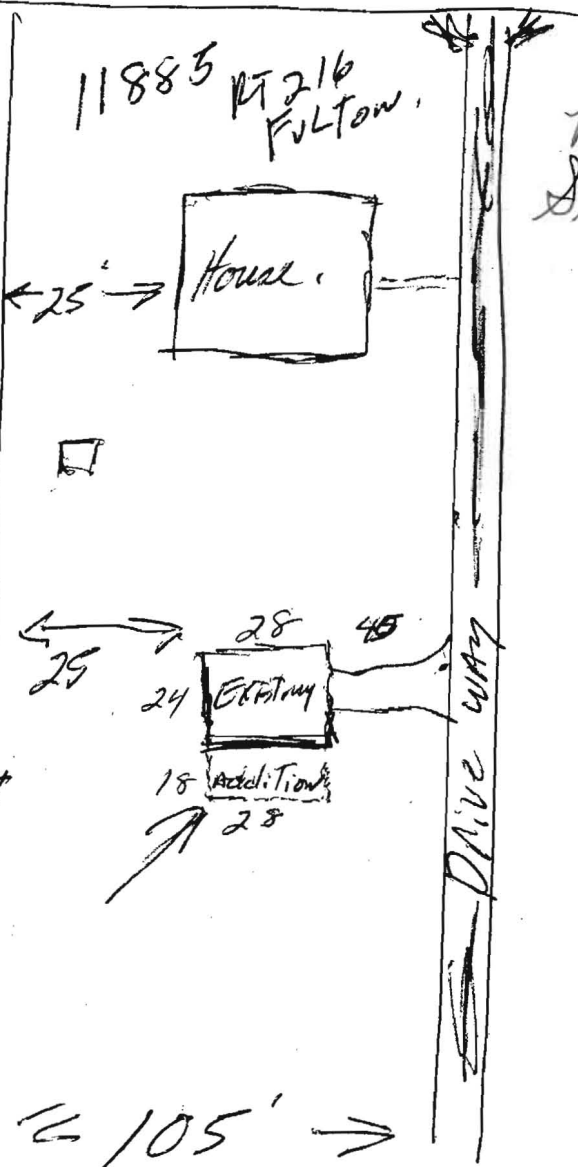

16" wide
8" ~~thick~~ thick.

30" deep
Belowground.

4" slab - 8" block - 2x6 PT. plate on block.

2x4 wall
2x8 - RAFTER
2x8 Double BEAM
METAL ROOF
1" per 1' slope
2x6 Headers
Windows

center
Addition

