

APPLICATION

SEWAGE DISPOSAL TESTING

MARYLAND STATE DEPARTMENT OF HEALTH

HOWARD COUNTY

ELLCOTT CITY

Septic Tank - 750 gal.

DISTRICT 5

Dry Well - 300 sq. ft. absorbent subsoil area to begin below the inlet pipe. The first 3 ft. of original ground not included in subsoil area.

DATE 8/7/62

Place Dry Well about 6 ft. behind existing house and about 130 ft. from street driveway on left side of house as you face from Rt. 216

TO: THE COUNTY HEALTH OFFICER
ELLCOTT CITY, MARYLAND

I, HEREBY, APPLY FOR THE NECESSARY TESTS IN ORDER TO CONSTRUCT OR RECONSTRUCT A SEWAGE DISPOSAL SYSTEM.

PROPERTY OWNER

Wilkerson, John D.

ADDRESS

Fuitem

PHONE

PA 5-4613

PROPERTY LOCATION:

SUBDIVISION

LOT NO.

ROAD AND DESCRIPTION

(Brady Property) - Rt 216 - 1/4 of a mile from Pindell School Rd going towards Rt 29

OCCUPANT

PHONE

PERSON TO CONSTRUCT SYSTEM

ADDRESS

PHONE

SIZE OF LOT

1 acre

TYPE BLDG.

3

NUMBER OF RESIDENCES

IF NOT SINGLE RESIDENCE DESCRIBE

SIGNATURE OF APPLICANT

John D. Wilkerson

APPROVED BY

D. W. Menaghan

FOR

Dry Well

DATE

8-4-62

REJECTED BY

FOR

REASON OF SYSTEM


DATE

HOLD PENDING FURTHER TESTS

DATE

REASONS FOR REJECTION OR HOLDING

THIS IS NOT A PERMIT

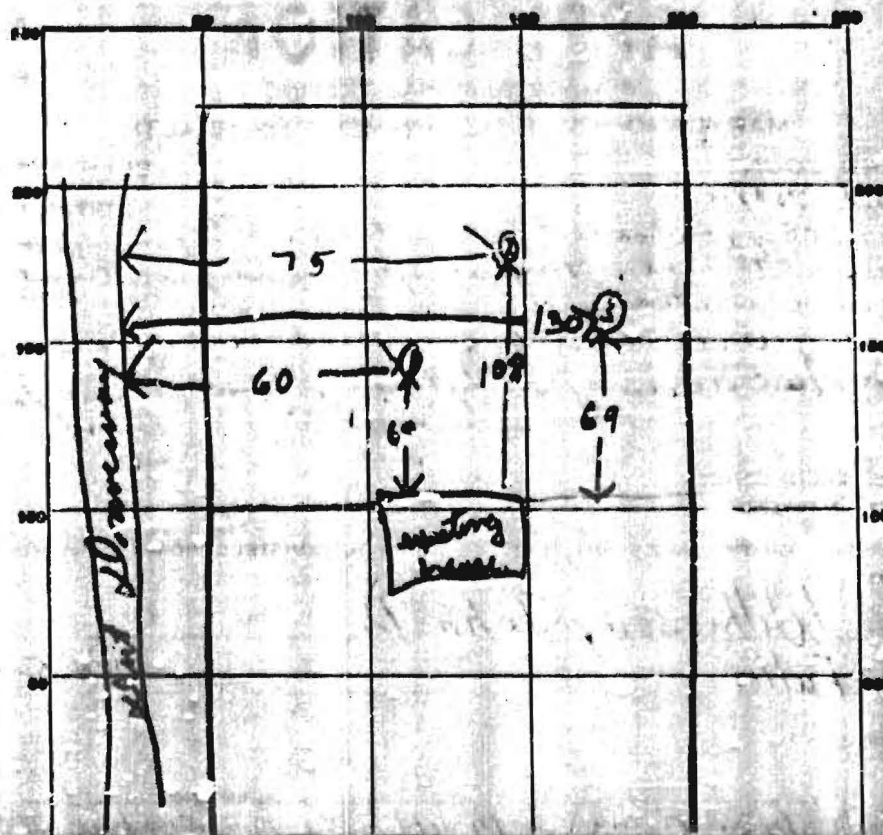

Page 216

[illegible]

BOIL AUGER FINDING

TESTED BY: Dum 849-62

REMARKS

ALSO PRESENT Abnath

LOT NO.