

Final OK
7/6/78 518590-A

7/6/78
9:30 a.m.

PERMIT

SEWAGE DISPOSAL SYSTEM

MARYLAND STATE DEPARTMENT OF HEALTH*

P 28111

A Repair

HOWARD COUNTY

INDEXED

ELLICOTT CITY

DISTRICT 5th

DATE 5/31/78

Donald Parlette

IS PERMITTED TO INSTALL ALTER X

ADDRESS 6575 Route 32, Clarksville, Md. 21029 PHONE 286-2140

SUBDIVISION Mooresfield ROAD 11722 Wayneridge St. LOT 3, Blk. C

PROPERTY OWNER Mr. Ken Ellis

ADDRESS 11722 Wayneridge Street, Fulton, Md. Phone: 725-6190

SPECIFICATIONS

SEPTIC TANK CAPACITY _____ GALLONS

DRAIN FIELD _____ DEPTH _____ FEET, BOTTOM AREA _____ SQ. FT.

DEEP TRENCH _____ DEPTH _____ FEET, BOTTOM AREA _____ SQ. FT.

SEEPAGE PITS _____ ABSORBENT SIDE-WALL AREA _____ SQ. FT.

INLET PIPE _____ FT. BELOW ORIGINAL GRADE. MAXIMUM DEPTH _____ FT. BELOW ORIGINAL GRADE

EFFECTIVE DEPTH AT _____ FT. BELOW ORIGINAL GRADE.

LOCATE DISPOSAL AREA _____ FT. FROM _____ LOT LINE AND _____ FT. FROM _____ LOT LINE AS SEEN WHEN
FACING LOT FROM

REPAIR - Call for an appointment when ground is opened up and Sanitarian will
recommend repair system.

7/6/78 - OK for trench 15 ft deep - 9 1/2 ft stone - 38 ft long.

PLANS APPROVED BY Palmer F. Wine DATE 5/21/78

COVER NO WORK UNTIL INSPECTED AND APPROVED.

NEITHER THE HOWARD COUNTY COUNCIL NOR THE HEALTH DEPARTMENT IS RESPONSIBLE FOR THE SUCCESSFUL OPERATION OF ANY SYSTEM.

NOTE: IF TRENCH IS USED CALL FOR INSPECTION BEFORE PLACING GRAVEL IN TRENCH.

NOTE: NO DRY WELL SHALL EXCEED 15 FOOT IN DIAMETER.

NOTE: ALL PIPE FROM HOUSE TO DISPOSAL AREA MUST BE CAST IRON.


PERMIT VOID AFTER THREE YEARS.

NOTE: INSTALL STAND PIPE ON SEPTIC TANK AND DRY WELL. STAND PIPES MUST BE 6 INCHES IN DIAMETER. CAST IRON, CONCRETE OR TERRA
COTTA ACCEPTED.

*INSTALLER IS RESPONSIBLE FOR OBTAINING FINAL APPROVAL ON THIS PERMIT.

518590-A
28111

$\frac{38}{18}$
 $\frac{324}{18}$
 $\frac{38}{9\frac{1}{2}}$
 $\frac{19}{348}$
 $\frac{1}{1}$

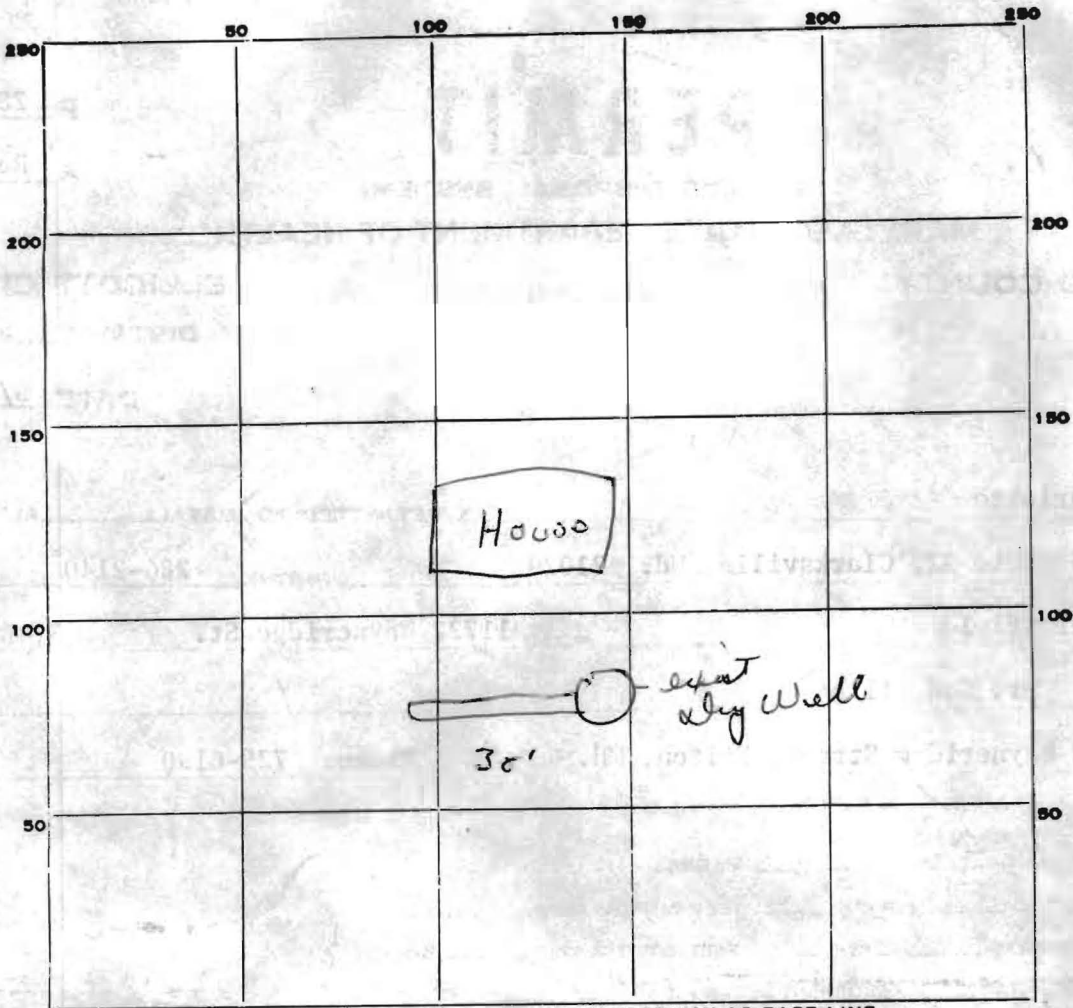

INDICATE NORTH. - NAME ADJOINING ROADWAY AS BASE LINE.

PERMIT CARD 2/1/78

SEPTIC TANK, LEVEL _____

CLEANOUTS _____

DISTRIBUTION BOX, LEVEL _____

TILE FIELD, DEPTH _____ FT. TRENCH WIDTH 2' FT.

GRAVEL DEPTH 9 1/2 IN. TOTAL LENGTH 35 FT. ppv

NUMBER OF TRENCHES 1 TOTAL BOTTOM AREA 361

SEEPAGE PITS, INSIDE DIAMETER _____ FT. DEPTH BELOW INLET _____ FT.

ABSORBENT AREA _____ SQ. FT.

REMARKS 7/10/78 - OK to put gravel in trench
7/16/78 Trench filled to 2' below original top

DATE SYSTEM APPROVED 7/16/78 INSPECTOR David P. Lee