

LAYOUT _____ INSP 4 _____

INSP 2 _____ INSP 5 _____

INSP 3 _____ INSP 6 _____

ISSUE DATE: _____

APPROVAL DATE: 11/18/03

**PERMIT
INDEXED**

P 519647

A REP WELL

**ON-SITE SEWAGE DISPOSAL SYSTEM
HOWARD COUNTY HEALTH DEPARTMENT
BUREAU OF ENVIRONMENTAL HEALTH**

03-298872

FOGLES WELL DRILLING IS PERMITTED TO INSTALL ☐ ALTER ☐

ADDRESS: 580 O'BRECHT ROAD PHONE NUMBER: 410-795-5670

SUBDIVISION: EVERGREEN VALLEY ESTATES LOT NUMBER: 75

ADDRESS: 11813 TRIADELPHIA ROAD PROPERTY OWNER: ROBERT WILLSON

SEPTIC TANK CAPACITY (GALLONS): _____ OUTLET BAFFLE FILTER REQUIRED ☐

PUMP CHAMBER CAPACITY (GALLONS): _____ COMPARTMENTED TANK REQUIRED ☐

NUMBER OF BEDROOMS: _____

SQUARE FEET PER BEDROOM: _____

LINEAR FEET OF TRENCH REQUIRED: _____

TRENCHES:	Trench to be _____ feet wide. Inlet _____ feet below original grade. Bottom maximum depth _____ feet below original grade. Effective area begins at _____ feet below original grade. _____ feet of stone below distribution pipe.
LOCATION:	
NOTES:	

PLANS APPROVED: _____ DATE: _____

NOTE: PERMIT VOID AFTER 2 YEARS

NOTE: CONTRACTOR RESPONSIBLE FOR SCHEDULING A PRE-CONSTRUCTION INSPECTION FOR ALL INSTALLATIONS

NOTE: WATERTIGHT SEPTIC TANKS REQUIRED

NOTE: ALL PARTS OF SEPTIC SYSTEM SHALL BE 100 FEET FROM ANY WATER WELL

NOTE: MANHOLE RISERS REQUIRED ON ALL SEPTIC TANKS AND PUMP CHAMBERS UNLESS SPECIFICALLY AUTHORIZED

**NEITHER THE HOWARD COUNTY COUNCIL NOR THE HEALTH DEPARTMENT IS
RESPONSIBLE FOR THE SUCCESSFUL OPERATION OF ANY SYSTEM
PERMITTEE RESPONSIBLE FOR OBTAINING FINAL APPROVAL ON THIS PERMIT
CALL 410-313-2640 FOR INSPECTION OF SEPTIC SYSTEM**

REP WELL P519647

PERMIT

SEWAGE DISPOSAL SYSTEM

MARYLAND STATE DEPARTMENT OF HEALTH

HOWARD COUNTY

Partial OK - H.F.

ELLCOTT CITY

DISTRICT 5

DATE 11/2/65

INDEXED

Rutman Construction Co. IS PERMITTED TO INSTALL 2 ALTERNATE

ADDRESS 363 Chapel Avenue, Ellicott City, Md. PHONE NO 8-2808

A SEWAGE DISPOSAL SYSTEM LOCATED AT _____

SUBDIVISION Drumscross Valley Estates 11573 ROAD Trindale Rd. LOT 20

PROPERTY OWNER same as above Robert Williams

ADDRESS _____

SPECIFICATIONS - 3 bedrooms

DRAIN FIELD _____ DEPTH _____ FEET, BOTTOM AREA _____ SQ. FT.

SEWAGE PITS _____ ABSORBENT SIDE-WALL AREA _____ SQ. FT.

SEPTIC TANK CAPACITY 750 GALLONS

FOR GARBAGE GRINDER, INCREASE DISPOSAL AREA PER A TANK CAPACITY 225.

OTHER Tile field - 300 sq. ft. bottom area installed at a depth of 3 to 4 ft.

Place the tile field 50 to 150 ft. from the back lot line and 10 to 20 ft. from the right side lot line as seen when facing lot from Trindale Rd.

PLANS APPROVED BY J. H. Kellers DATE 5/12/65

FILL SEPTIC TANK AND DISTRIBUTION BOX WITH WATER BEFORE CALLING FOR AN INSPECTION. COVER HO WORK UNTIL INSPECTED AND APPROVED.

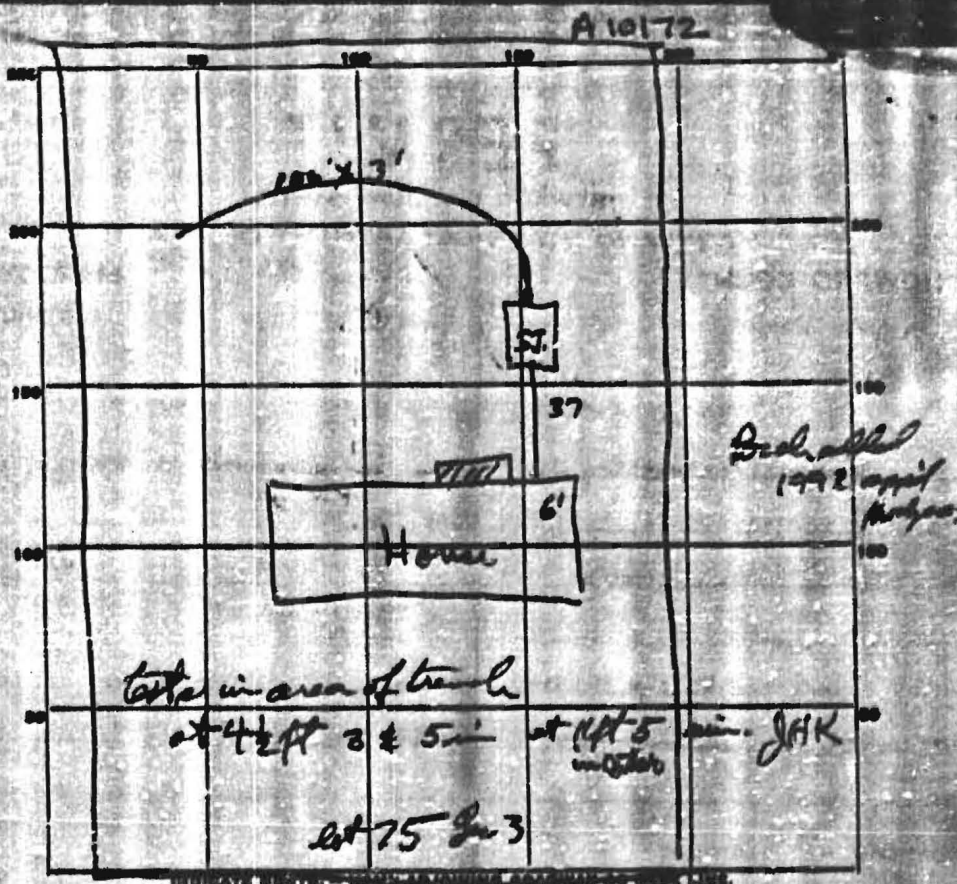
NEITHER THE HOWARD COUNTY COMMISSIONERS NOR THE HEALTH DEPARTMENT IS RESPONSIBLE FOR THE SUCCESSFUL OPERATION OF ANY SYSTEM.

BLDG. PERMIT SIGNED
AND RETURNED

Chapman
Serial 41257

1.2

(3)

A10172
5/14/65Bedrock
1992
up to
surfacetote in area of trench
at 4 1/2 ft 3 & 5 in

at 1 ft 5 in. JHK

at 75 in 3

Trench Rd

PERMIT CARD

SEPTIC TANK, LEVEL 760 gal. concrete

CLEANOUTS OK

DISTRIBUTION BOX, LEVEL

TILE FIELD, DEPTH _____ FT. TRENCH WIDTH 3 FT.

GRAVEL DEPTH _____ IN. TOTAL LENGTH 100 FT.

NUMBER OF TRENCHES _____ TOTAL BOTTOM AREA 300

SEPTAGE PITS, INSIDE DIAMETER _____ FT. DEPTH BELOW INLET _____ FT.

ABSORBENT AREA _____ SQ. FT.

REMARKS 4/15 OK to cover pipes & 1/2 of tank R.F.

11/4/65 still incomplete R/F

11 Jan 66 still incomplete R/F

14 FEB 66 " " 355

4-18-66 Final OK. JHK

DATE SYSTEM APPROVED 4-18-66

INSPECTOR J. Hennigan