

INDEXED

PERMIT

SEWAGE DISPOSAL SYSTEM

MARYLAND STATE DEPARTMENT OF HEALTH

HOWARD COUNTY

ELLCOTT CITY

DISTRICT 4

DATE 11/23/71

Jack Frank

IS PERMITTED TO INSTALL ☒ ALTER

ADDRESS Ten Oaks road, Glenora, Maryland

PHONE 294-2929

A SEWAGE DISPOSAL SYSTEM LOCATED AT _____

SUBDIVISION Winfield Estates

ROAD Shady Lane

LOT 6, Blk. B, Sec. 3

PROPERTY OWNER T. R. Frank

ADDRESS _____

SPECIFICATIONS - 3 bedrooms

DRAIN FIELD _____ DEPTH _____ FEET. BOTTOM AREA _____ SQ. FT.

SEEPAGE PITS _____ ABSORBENT SIDE WALL AREA _____ SQ. FT.

SEPTIC TANK CAPACITY 1,000 GALLONS

FOR GARBAGE GRINDER, INCREASE DISPOSAL AREA 25% & TANK CAPACITY 50%

OTHER Dry well to be 100 sq. ft. of absorbent sidewall area per bedroom.
Inlet to enter 3 ft. below original grade. Maximum depth of dry well to be
9 ft. below original grade. Minimum dry well 11 ft. from left side line and 100 ft.
from rear lot line as lot is seen from standing on Shady Lane facing lot.

NOTE: ALL SIPS FROM HOUSE TO SEPTIC TANK MUST BE CONCRETE.

PERMIT VOID AFTER THREE YEARS.
INSTALL STOOD PIPE ON SEPTIC TANK AND DRY WELL.

BLDG. PERMIT SIGNED
AND RETURNED

PLANS APPROVED BY James T. Wright

DATE 11/17/71


FILL SEPTIC TANK AND DISTRIBUTION BOX WITH WATER BEFORE CALLING FOR AN INSPECTION. COVER NO WORK UNTIL INSPECTED AND APPROVED.

NEITHER THE HOWARD COUNTY COMMISSIONERS NOR THE HEALTH DEPARTMENT IS RESPONSIBLE FOR THE SUCCESSFUL OPERATION OF ANY SYSTEM.

Dwain requested larger system so Mr. Frank added 25 ft. long trench - 2 ft wide with 6 ft. of gravel below pipe.

15077

INDEXED

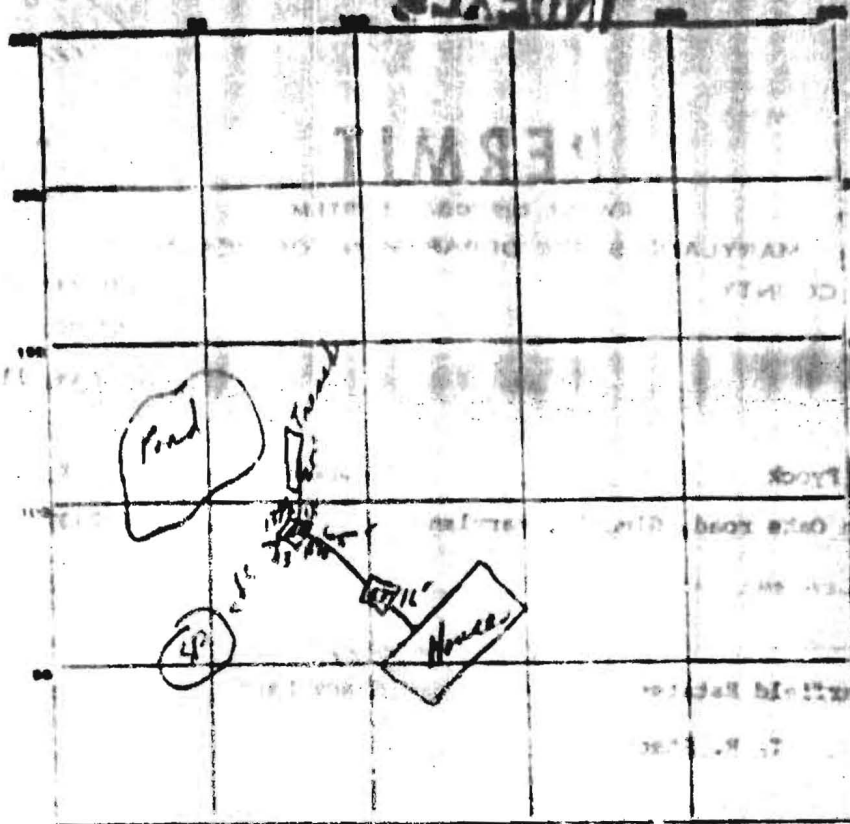

INDICATE NORTH - NAME ADJOINING ROADWAY AS BASE LINE

PERMIT CARD Signal
SEPTIC TANK LEVEL OK S.T. / D.W. OK / OK
CLEANOUTS OK / OK
DISTRIBUTION BOX LEVEL

PILE FIELD, DEPTH FT. TRENCH WIDTH 2 FT.
GRAVEL DEPTH 6 ft TOTAL LENGTH 25 FT.
NUMBER OF TRENCHES 1 TOTAL BOTTOM AREA
SEEPAGE PITS INSIDE DIAMETER 52 FT. DEPTH BELOW INLET 6 FT.
1 Trench 6" deep 75' long 2' 30" wide
ABSORBENT AREA 612 SQ. FT.

REMARKS 4' x 6' Trench was filled on final inspection - depth
gross by J. F. Good Jr. C.E.S.

16
3/53
3/3
22

DATE SYSTEM APPROVED 11/28/71 INSPECTOR C. Atkinson