

APPLICATION

SEWAGE DISPOSAL TESTING

MARYLAND STATE DEPARTMENT OF HEALTH

HOWARD COUNTY *Septic tank for 3 bedrooms 1000 gals* ELLICOTT CITY

Dr. well to be 800 gals of capacity, natural, 12/31/69
also per previous. depth to enter 3 ft below grade.
Map in north of city well to be 8 ft below original grade.
locate on well 81 ft from upper side line and 105 ft from rear
at time the lot is new from a building on shady lane facing lot.

TO: THE COUNTY HEALTH OFFICER
ELLICOTT CITY, MARYLAND

I, HEREBY, APPLY FOR THE NECESSARY TESTS IN ORDER TO CONSTRUCT OR RECONSTRUCT A SEWAGE DISPOSAL SYSTEM.

PROPERTY OWNER Maple Hill Farm Associates

ADDRESS 9300 Fontana Ave., Jessbrook, Md. 20801 PHONE _____

PROPERTY LOCATION:

SUBDIVISION Warfield Estates LOT NO. 6 Blk. B, Sec. 3

ROAD AND DESCRIPTION Shady Lane

OCCUPANT _____ PHONE _____

PERSON TO CONSTRUCT SYSTEM _____

ADDRESS 160X 872X 160X 160 PHONE _____

SIZE OF LOT _____ TYPE BLOC 3 or 4
NUMBER OF RESIDENCES

IF NOT SINGLE RESIDENCE DESCRIBE _____

SIGNATURE OF APPLICANT /s/ MacIntosh & Hunter


APPROVED BY W. T. Knight FOR Dr. Well DATE 3/17/71
SIGN OF SYSTEM

REJECTED BY _____ FOR _____ DATE _____
SIGN OF SYSTEM

HOLD PENDING FURTHER TESTS _____ DATE _____

REASONS FOR REJECTION OR HOLDING _____

THIS IS NOT A PERMIT

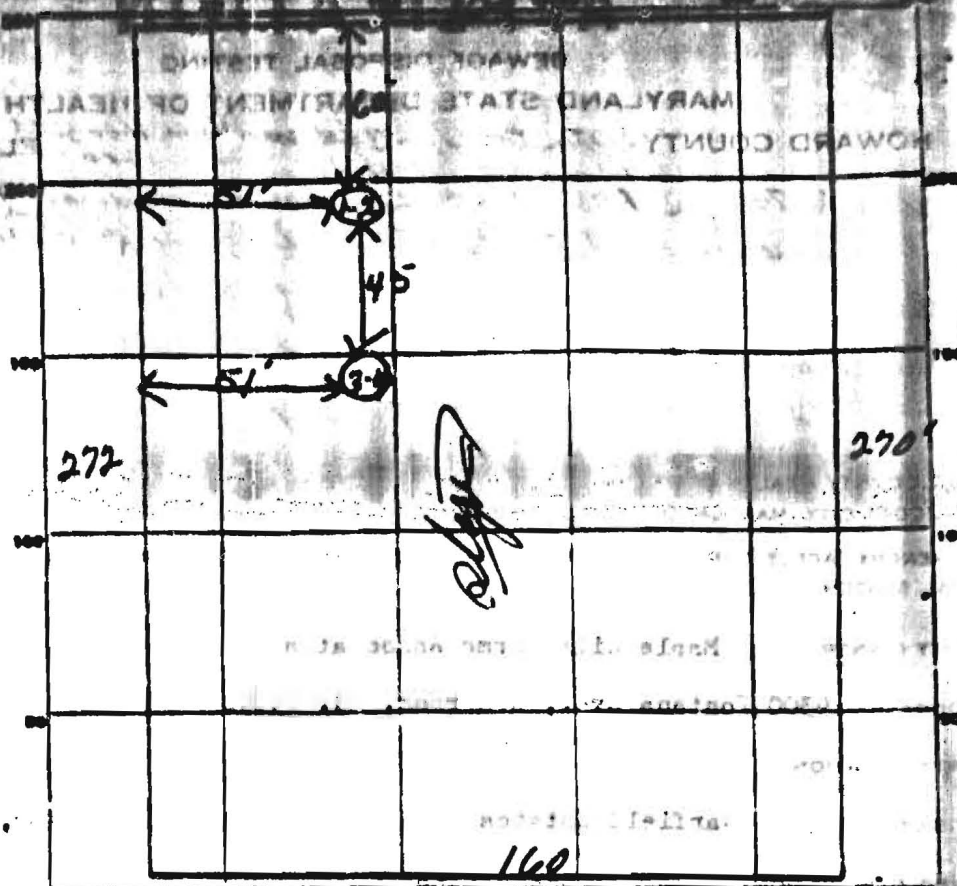

INDICATE NORTH - NAME ADJOINING ROADWAY AS BASE LINE.

shaded lane

DATE	TEST NO.	DEPTH	PRE-WET		TEST - 1" DROP		TIME
			START	STOP	START	STOP	
2/5/70	1	9'	938	145	144	149	5m
	2	3'	138	140	140	142	3m
	3	9'	145	147	142	150	3m
	4	3'	144	146	146	149	3m

5m AP

lat 6

BMB

avg 4m

inlet 3'

BOIL AUGER FINDING

2/5/70

TESTED BY JTW

REMARKS

THIS IS NOT A PERMIT