


OK TO SIGN SUNROOM 13 2ND STORY ONLY APPROX 10%
 ONLY 25% from Septa Corp 50% in above ground swimming
 pool & in car case for Day Well, Tuller to owner

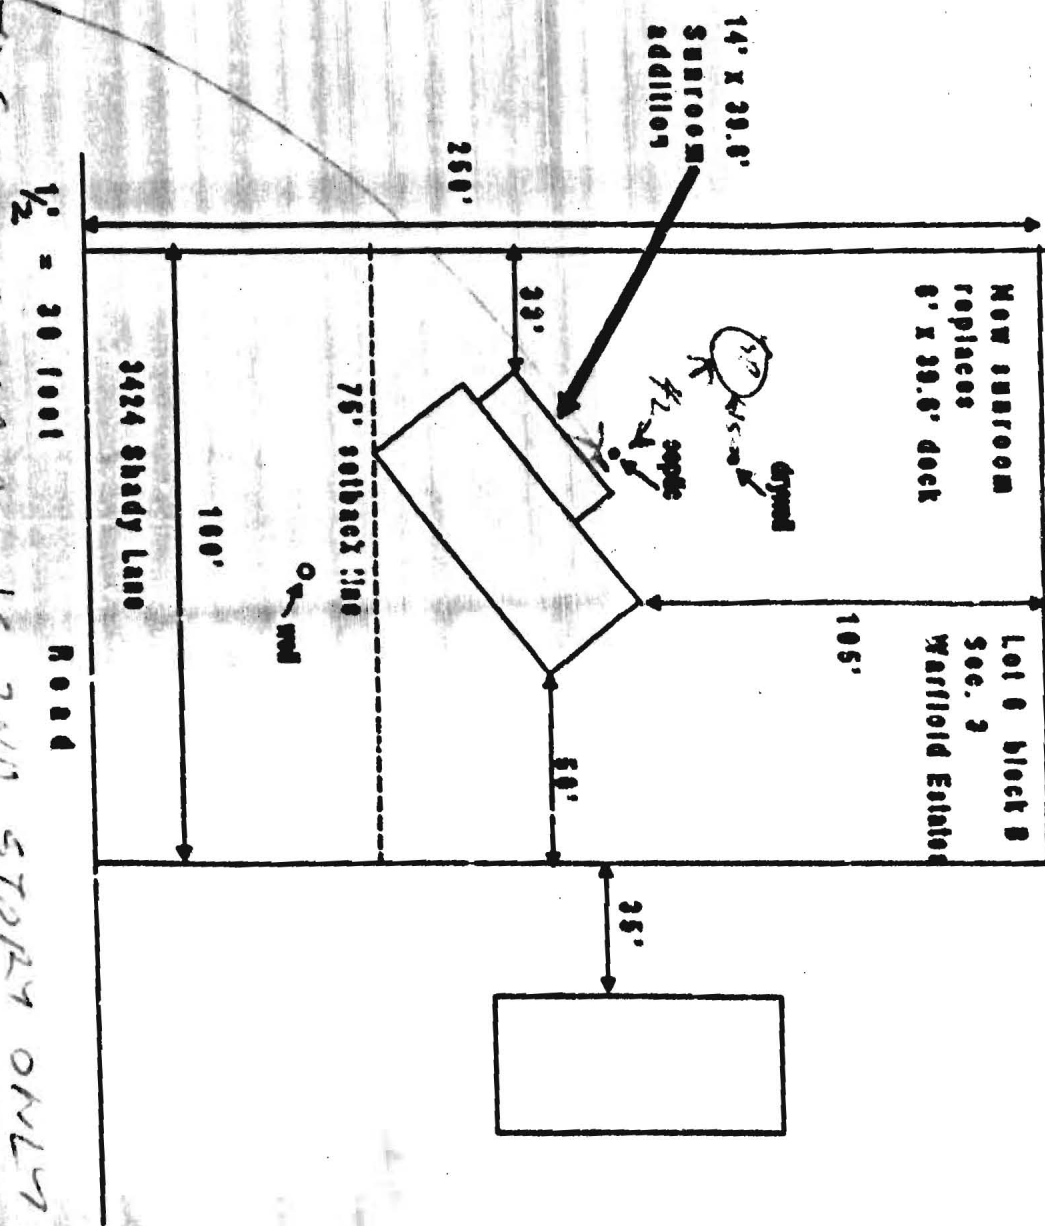

$\frac{1}{2}$ = 30 1001 ROAD