

PUB. SEWER STATUS VERIFIED BY \_\_\_\_\_

ISSUE DATE: \_\_\_\_\_

APPROVAL DATE: \_\_\_\_\_

# PERMIT INDEXED

P re-index \_\_\_\_\_

A 519872-D \_\_\_\_\_

## ON-SITE SEWAGE DISPOSAL SYSTEM HOWARD COUNTY HEALTH DEPARTMENT BUREAU OF ENVIRONMENTAL HEALTH

03-289273

IS PERMITTED TO INSTALL ☐ ALTER ☒

ADDRESS: \_\_\_\_\_

PHONE NUMBER: \_\_\_\_\_

SUBDIVISION: Woodmark

LOT NUMBER: 29

ADDRESS: 12248 Yearling Court

PROPERTY OWNER: Nutshorn

SEPTIC TANK CAPACITY (GALLONS): \_\_\_\_\_

PUMP CHAMBER CAPACITY (GALLONS): \_\_\_\_\_

NUMBER OF BEDROOMS: \_\_\_\_\_

SQUARE FEET PER BEDROOM: \_\_\_\_\_

LINEAR FEET OF TRENCH REQUIRED: \_\_\_\_\_

TRENCHES:	Trench to be _____ feet wide. Inlet _____ feet below original grade. Bottom maximum depth _____ feet below original grade. Effective area begins at _____ feet below original grade. _____ feet of stone below distribution pipe.
LOCATION:	
PURPOSE:	

PLANS APPROVED: \_\_\_\_\_ DATE: \_\_\_\_\_

NOTE: PERMIT VOID AFTER 2 YEARS

NOTE: CONTRACTOR RESPONSIBLE FOR SCHEDULING A PRE-CONSTRUCTION INSPECTION FOR ALL INSTALLATIONS

NOTE: WATERTIGHT SEPTIC TANKS REQUIRED

NOTE: ALL PARTS OF SEPTIC SYSTEM SHALL BE 100 FEET FROM ANY WATER WELL

NOTE: MANHOLE RISERS REQUIRED ON ALL SEPTIC TANKS AND PUMP CHAMBERS

**NEITHER THE HOWARD COUNTY COUNCIL NOR THE HEALTH DEPARTMENT IS  
RESPONSIBLE FOR THE SUCCESSFUL OPERATION OF ANY SYSTEM  
PERMITTEE RESPONSIBLE FOR OBTAINING FINAL APPROVAL ON THIS PERMIT  
CALL 410-313-2640 FOR INSPECTION OF SEPTIC SYSTEM**

4519872-D

# PERMIT

SEWAGE DISPOSAL SYSTEM

MARYLAND STATE DEPARTMENT OF HEALTH

HOWARD COUNTY

## INDEXED

ELLICOTT CITY

DISTRICT 34

DATE 9/4/72

Substitute and Levy

IS PERMITTED TO INSTALL X ALTER

ADDRESS 7000 Langview Road, Singersville, Md.

PHONE 531-9866

A SEWAGE DISPOSAL SYSTEM LOCATED AT

SUBDIVISION Woodmont, Inc.

12248 Bearling Court

LOT 29, Blk. E, Sec.

PROPERTY OWNER Charles James Roderick Nitzhorn

ADDRESS

SPECIFICATIONS 3 bedrooms

DRAIN FIELD DEPTH FEET. BOTTOM AREA SQ. FT.

SEEPAGE PITS ABSORBENT SIDE WALL AREA SQ. FT.

SEPTIC TANK CAPACITY 1000 GALLONS

FOR GARBAGE GRINDER, INCREASE DISPOSAL AREA 25% & TANK CAPACITY 50%.

OTHER DRY WELL - 112 sq. ft. absorbent area per bedroom to begin below the first 5 ft. of original ground. Maximum depth permitted for dry well is 11 ft. below original grade. Place the dry well 100 ft. from rear lot line and 100 ft. from front lot line as shown when facing lot from the street.

NOTE: ALL PIPE FROM HOUSE TO DRY WELL MUST BE CAST IRON.

PERMIT VOID AFTER THREE YEARS.

NOTE: INSTALL WOOD PIPE IN SEPTIC TANK AND DRY WELL.

PLANS APPROVED BY Donald V. Hennigan

DATE 9/26/72


FILL SEPTIC TANK AND DISTRIBUTION BOX WITH WATER BEFORE CALLING FOR AN INSPECTION. COVER NO WORK UNTIL INSPECTED AND APPROVED.

NEITHER THE HOWARD COUNTY COMMISSIONERS NOR THE HEALTH DEPARTMENT IS RESPONSIBLE FOR THE SUCCESSFUL OPERATION OF ANY SYSTEM.

BLOD. PERMIT SIGNED  
AND RETURNED 11/3/74

Serial # 8659

4519872-D

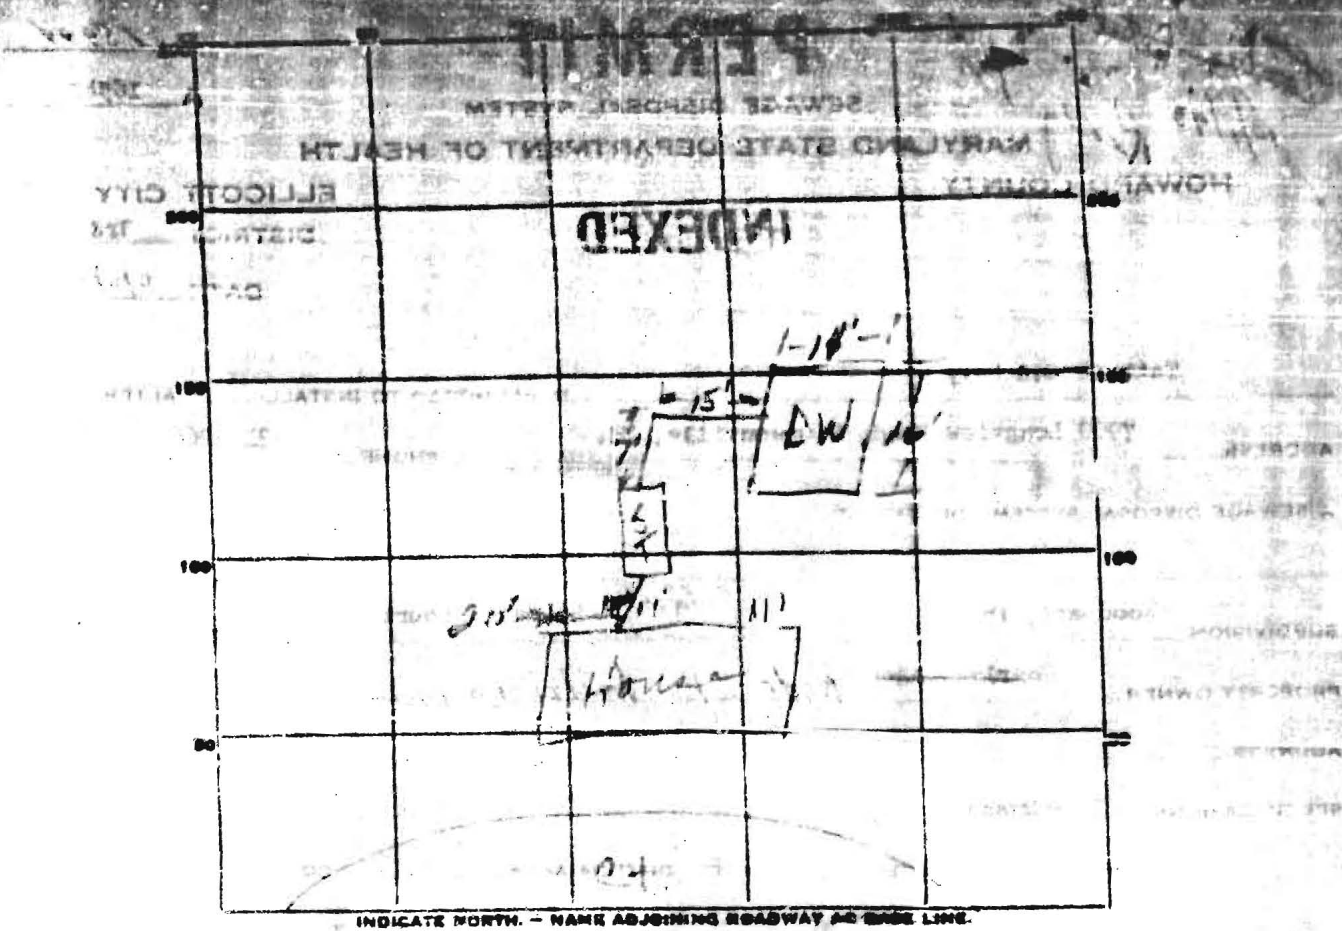

PERMIT CARD None seen NO A.H.  
 SEPTIC TANK, LEVEL 1250 CLEANOUTS Three caps  
 DISTRIBUTION BOX, LEVEL \_\_\_\_\_  
 TILE FIELD, DEPTH \_\_\_\_\_ FT. TRENCH WIDTH \_\_\_\_\_ FT.  
 GRAVEL DEPTH \_\_\_\_\_ IN. TOTAL LENGTH \_\_\_\_\_ FT.  
 NUMBER OF TRENCHES \_\_\_\_\_ TOTAL BOTTOM AREA \_\_\_\_\_  
 SEEPAGE PITS, INSIDE DIAMETER 14x16 FT. DEPTH BELOW INLET 1 1/2 FT.  
 ABSORBENT AREA 390 SQ. FT. OK for 3 beds  
 REMARKS 4/17/73 - Tank longer cleanout for DW to bring  
to grade. Need caps for both cleanouts  
Spoke to workman concerning this. He will  
offer up complete. Also let card. NW2  
10/1/73 - Tank & dry well cleanouts  
installed  
 DATE SYSTEM APPROVED 10/1/73 INSPECTOR Raymond Hodge