

APPLICATION

PERCOLATION TESTING

A 50463

P _____

DISTRICT CH

DATE 10/24/94

HOWARD COUNTY HEALTH DEPARTMENT

BUREAU OF ENVIRONMENTAL HEALTH

3525 H ELLICOTT MILLS DRIVE/ELLICOTT CITY, MARYLAND 21043

TELEPHONE 313-2640

TO: THE COUNTY HEALTH OFFICER
ELLICOTT CITY, MARYLAND

I HEREBY APPLY FOR THE NECESSARY TEST PRIOR TO APPLICATION FOR PERMIT TO CONSTRUCT (OR RECONSTRUCT) A SEWAGE DISPOSAL SYSTEM.

PROPERTY OWNER Amelia Riggs C/o SDC Group, Inc. RYAN HAMES

ADDRESS 8480 Balt. Nat. Pike Suite 417 PHONE 465-6105
P.O. Box 417 Ellicott City Md
21043

AGENT OR PROSPECTIVE BUYER _____

ADDRESS _____ PHONE _____

PROPERTY LOCATION:

SUBDIVISION Riggs Property LOT NO. 12

ROAD AND DESCRIPTION Located @ SW. Corner of the intersection of Roxbury
Mill Road (Rte 97) & Frederick Road (Rte 144) 14618 Riggs MEADOW DRIVE

TAX MAP 8 & 14 PARCEL # 96

SIZE OF LOT _____ TYPE BLDG. OLD PERMIT SIGNED
6-29-98
Serial # 112561
(SINGLE FAMILY DWELLING OR COMMERCIAL)

THE SYSTEM INSTALLED UNDER THIS APPLICATION IS ACCEPTABLE ONLY UNTIL PUBLIC FACILITIES BECOME AVAILABLE. I FULLY UNDERSTAND THE
FEE CONNECTED WITH THE FILING OF THIS PERC TEST APPLICATION IS NON-REFUNDABLE UNDER ANY CIRCUMSTANCES. I ALSO AGREE TO
COMPLY WITH ALL M.O.S.H.A. REQUIREMENTS IN TESTING THIS LOT. James O. McLean U.P.
(SIGNATURE OF APPLICANT)

APPROVED BY _____ FOR _____ DATE _____

DISAPPROVED BY _____ FOR _____ DATE _____

HOLD PENDING FURTHER TESTS _____

REASONS FOR REJECTION OR HOLDING _____

PERCOLATION TEST PLAT/PRELIMINARY PLAT - TITLE OR I.D. # _____ DATE _____

SITE DEVELOPMENT PLAN/FINAL PLAT - TITLE OR I.D. # _____ DATE _____

THIS IS NOT A PERMIT

Lot 11

COUNTY #

SOIL PROFILE

0' 718
orange
brn
SiClm
4' pink to
red
matrix
color
many
yellow
blk/cream
mottles
probably
from
parent
rock
12'

SOIL PROFILE

0'

see
Attached
diagram

INDICATE NORTH - NAME ADJOINING ROADWAY AS BASE LINE.

A

45' reddish
brn
ci silm
bright
red
brn
silm
5-10%
rock
flags
not
interconnected
12'

DATE	TEST NO.	DEPTH	PRE-WET		TEST - 1" DROP		TIME
			START	STOP	START	STOP	
11-29-95	420-A	Visual	to 7'	- rock refusal	at 7'		F
	718	Visual	to 12.0	- see profile	-		DK
1-5-95	A	5 112	7.09 ¹⁵	7.10 ³⁰	7.10 ³⁰	7.12 ³⁰	2min

REMARKS _____


TYPE OF SOIL _____


TESTED BY _____ ALSO PRESENT _____

TRENCH DESIGN DATA: AVERAGE PERCOLATION TIME _____ TRENCH WIDTH _____

INLET DEPTH _____ MAXIMUM BOTTOM DEPTH _____ SQ. FT./BEDROOM _____

4/24/97 Well site of no nsp made AEM

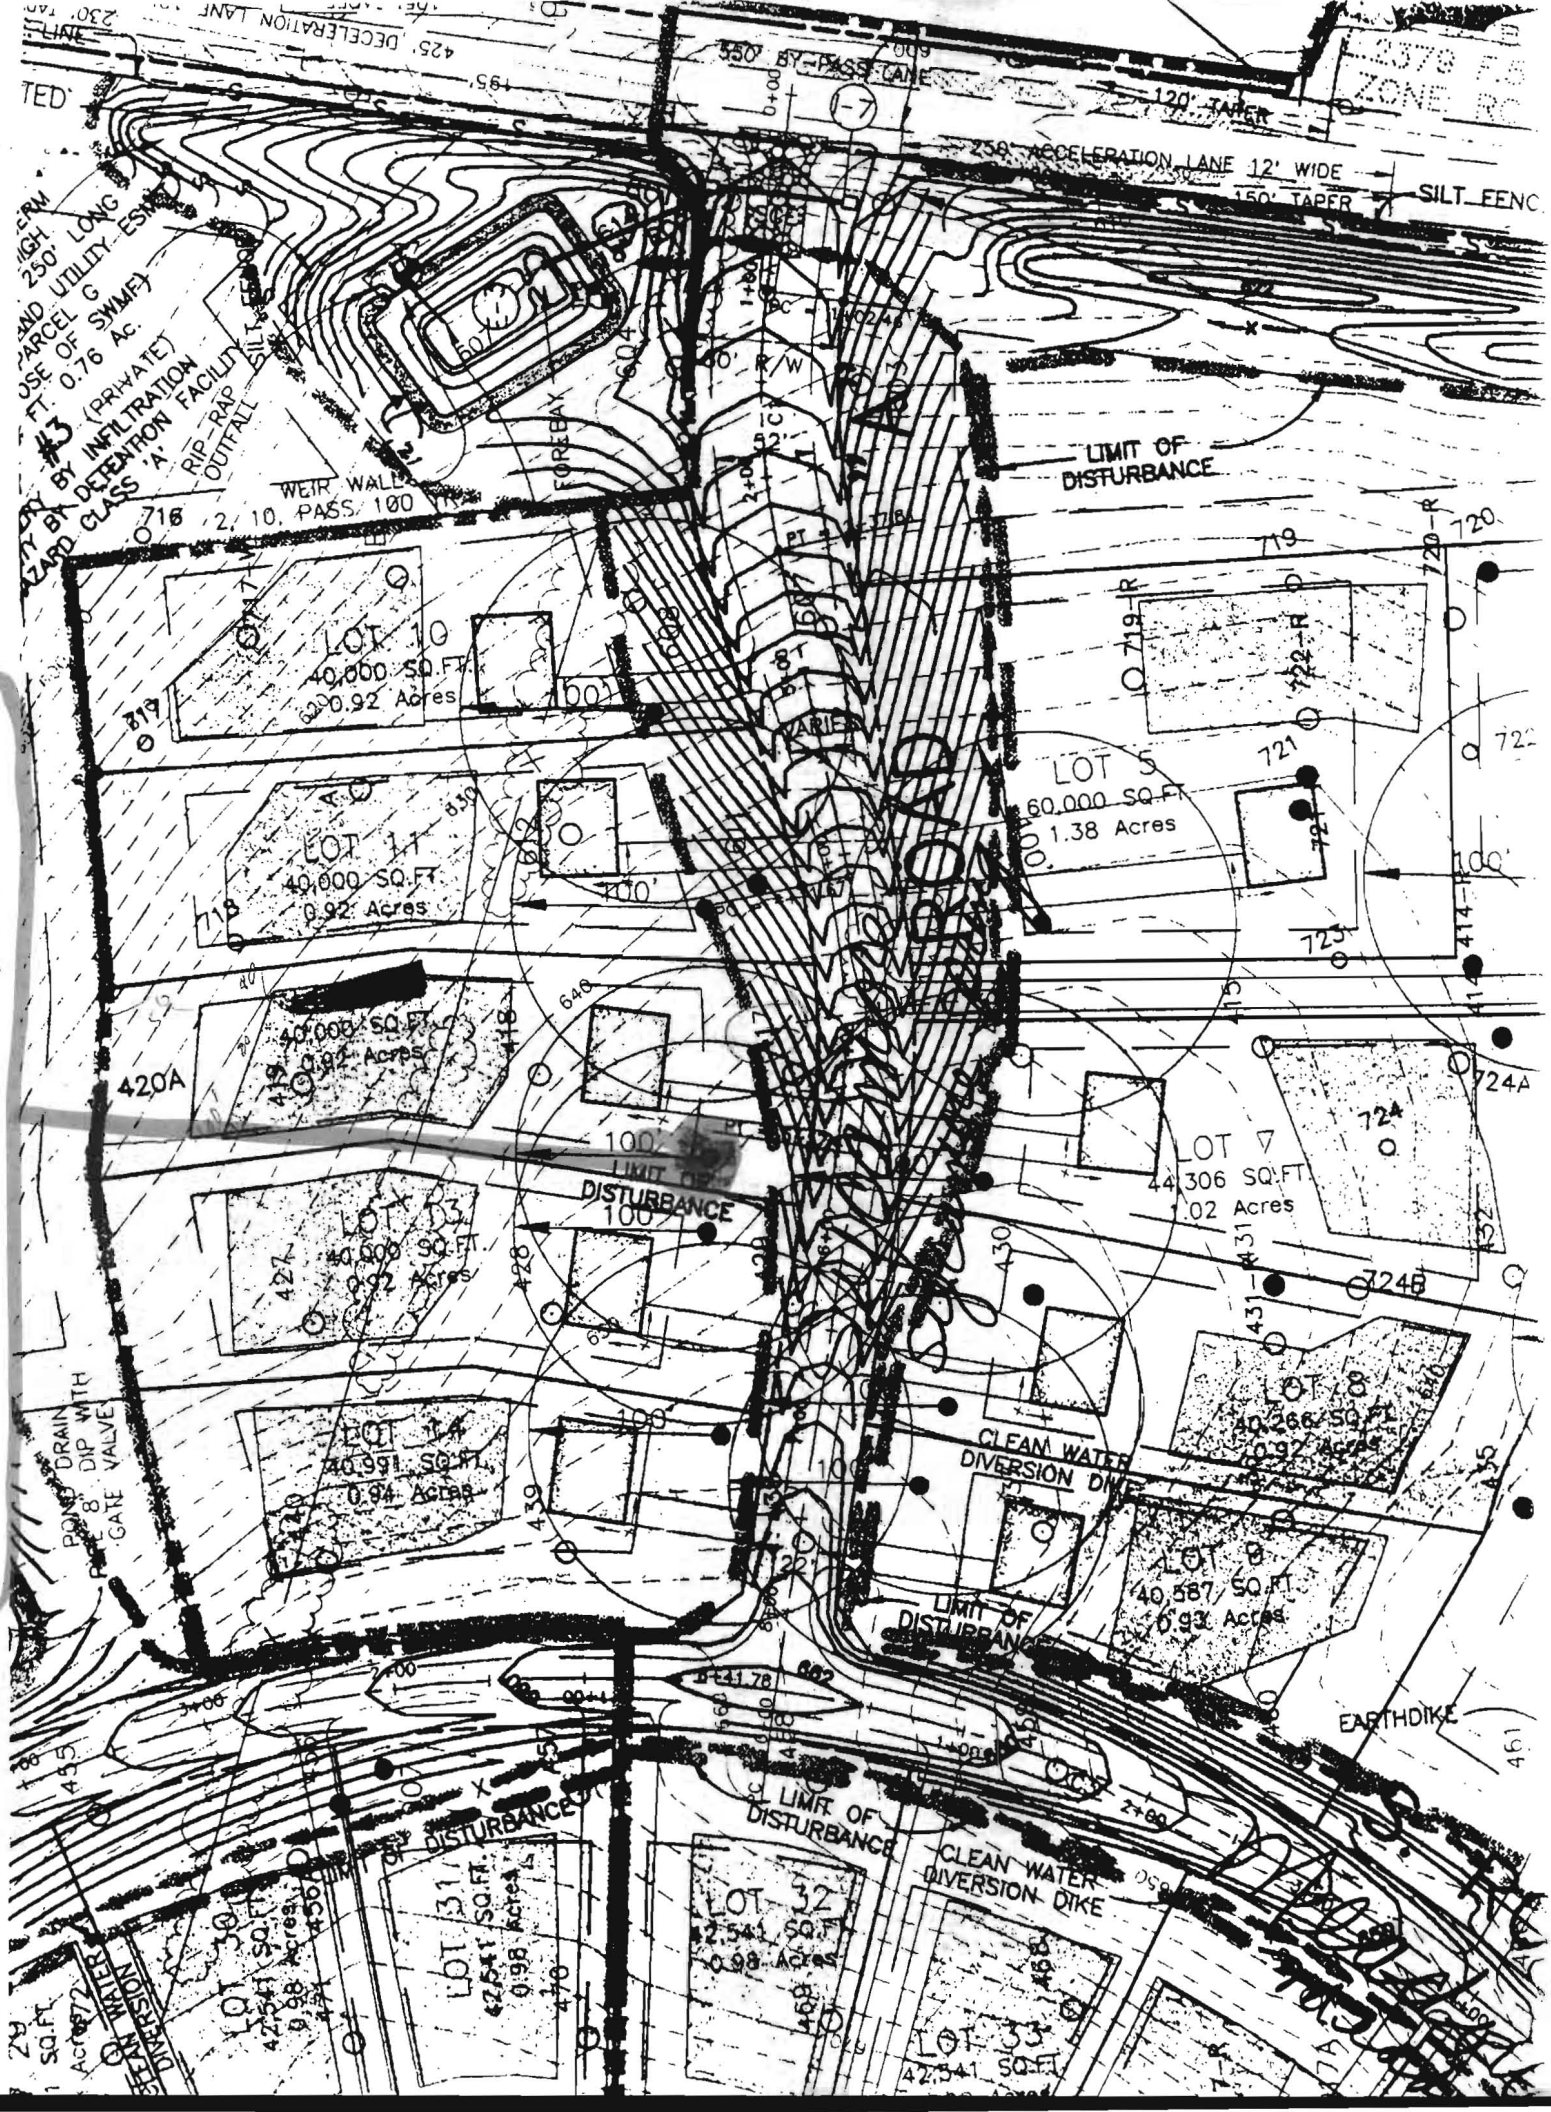

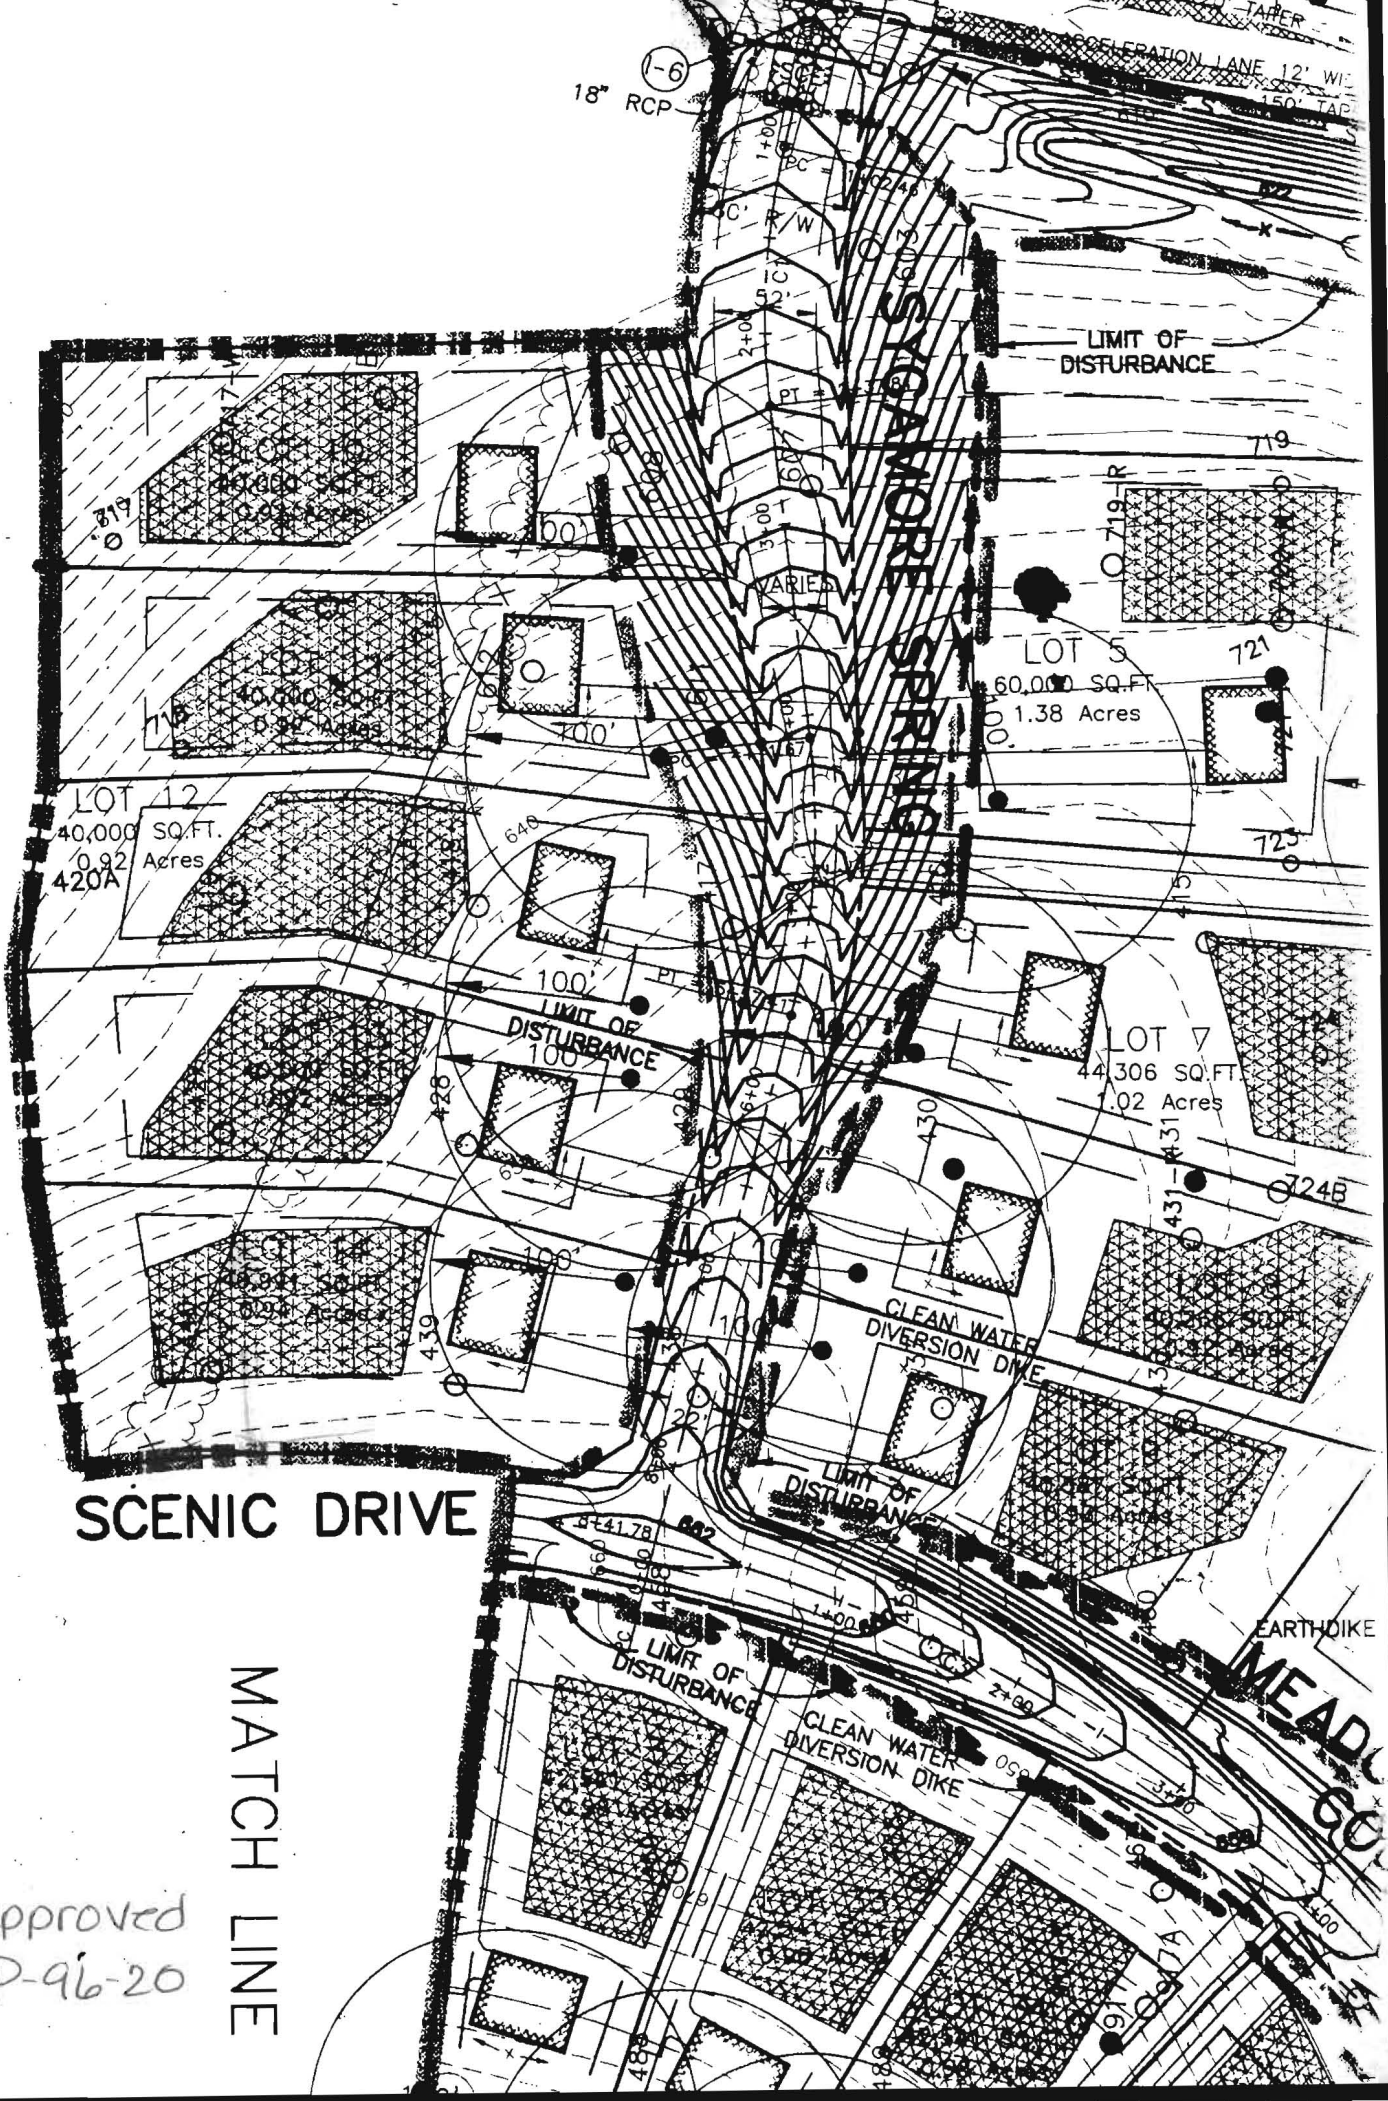

Approved
P-96-20