

APPLICATION

PERCOLATION TESTING

A Repair
P 47874

HOWARD COUNTY HEALTH DEPARTMENT
BUREAU OF ENVIRONMENTAL HEALTH
P.O. BOX 476 ELLICOTT CITY, MARYLAND 21043
TELEPHONE 461-9933

DISTRICT _____
DATE 3/2/92

TO: THE COUNTY HEALTH OFFICER
ELLICOTT CITY, MARYLAND

I, HEREBY, APPLY FOR THE NECESSARY TEST IN ORDER TO CONSTRUCT (OR RECONSTRUCT) A SEWAGE DISPOSAL SYSTEM.

PROPERTY OWNER Paul & Rock Casner

ADDRESS 12268 Woodspurge Court PHONE _____
Ellicott City, Maryland

PROSPECTIVE BUYER _____

ADDRESS _____ PHONE _____

PROPERTY LOCATION:

SUBDIVISION Woodmark LOT NO. 6 Repair Perc
Blk B; Sec. 2

ROAD AND DESCRIPTION 12268 Woodspurge Court

TAX MAP _____ PARCEL # _____

SIZE OF LOT _____ TYPE BLDG SFD
(SINGLE FAMILY DWELLING OR COMMERCIAL)

THE SYSTEM INSTALLED UNDER THIS APPLICATION IS ACCEPTABLE ONLY UNTIL PUBLIC FACILITIES BECOME AVAILABLE. I FULLY UNDERSTAND THE
FEE CONNECTED WITH THE FILING OF THIS PERC TEST APPLICATION IS NON-REFUNDABLE UNDER ANY CIRCUMSTANCES. I ALSO AGREE TO COMPLY
WITH ALL M.O.S.H.A. REQUIREMENTS IN TESTING THIS LOT. _____

(SIGNATURE OF APPLICANT)

APPROVED BY _____ FOR _____ DATE _____

REJECTED BY _____ FOR _____ DATE _____


HOLD PENDING FURTHER TESTS _____ DATE _____

REASONS FOR REJECTION OR HOLDING _____

THIS IS NOT A PERMIT

SOIL PROFILE

0-4.5	Red br si c/m
4.5-9.0	Red br c s:si lm some broken rock, (quartz) L 5% water seepage in wall 7.0 ft
9.0	Bottom w/ water

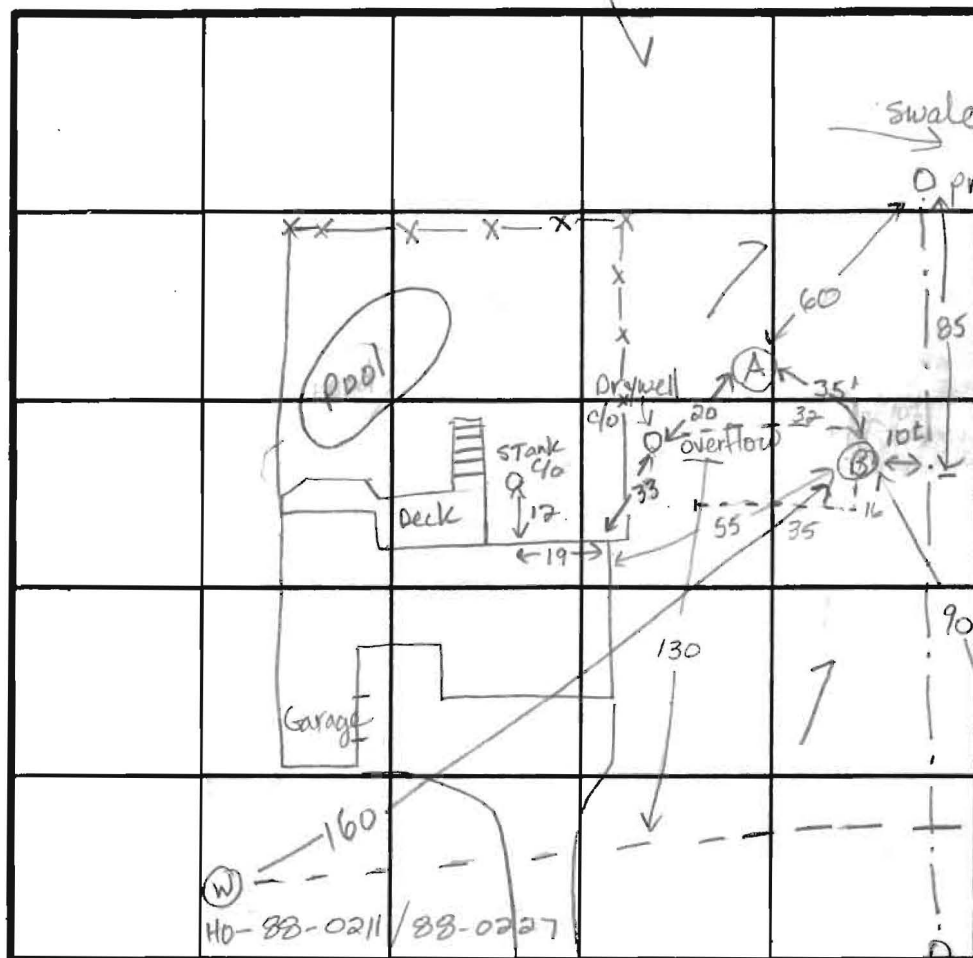

INDICATE NORTH - NAME ADJOINING ROADWAY AS BASE LINE

WOODSPURGE COURT

Prop Corner

0-4.5 Yellow-br
s1 c 1m
4.5-11.0 Yellow-tan
s s1 1m
L 5%
decomposed
rock.
11.0 Bottom

[illegible]

REMARKS _____

TYPE OF SOIL CLAY

TESTED BY June E. Nielsen ALSO PRESENT Enchs