

APPLICATION

SEWAGE DISPOSAL TESTING

MARYLAND STATE DEPARTMENT OF HEALTH

HOWARD COUNTY

ELLICOTT CITY

A 13025

P

DISTRICT 3

DATE 8/10/67

Septic Tank - 3 bedrooms - 750 gal
" " " " - 1000 gal
Dry Well - 100 sq. ft absorbent sidewall once per bedroom to begin below
inlet pipe. Inlet pipe 4 ft below orig. grade. Max depth permitted
for dry well below orig. grade is 12 ft
Place Dry Well 105 ft from rear lot line and 75 ft from right
sideline as seen when facing from Woodbury Etc.

TO: THE COUNTY HEALTH OFFICER
ELLICOTT CITY, MARYLAND

I, HEREBY, APPLY FOR THE NECESSARY TESTS IN ORDER TO CONSTRUCT (OR RECONSTRUCT) A SEWAGE
DISPOSAL SYSTEM.

PROPERTY OWNER Woodmark, Inc., Mark A. Wakefield, Jr.

ADDRESS 231 Chatham Rd., Ellicott City, Md. PHONE HO 5-1345

PROPERTY LOCATION:

SUBDIVISION Woodmark, Inc. LOT NO. 6, Blk. B, Sec. 2

ROAD AND DESCRIPTION Court "B"

OCCUPANT PHONE

PERSON TO CONSTRUCT SYSTEM

ADDRESS PHONE

SIZE OF LOT 170' x 240' x 175' x 208' TYPE BLDG. 3 or 4

NUMBER OF BEDROOMS

IF NOT SINGLE RESIDENCE DESCRIBE

SIGNATURE OF APPLICANT /s/ Mark Wakefield

APPROVED BY [Signature] FOR [Signature] DATE 3-12-68

(KIND OF SYSTEM)


REJECTED BY FOR DATE

(KIND OF SYSTEM)

HOLD PENDING FURTHER TESTS DATE

REASONS FOR REJECTION OR HOLDING

THIS IS NOT A PERMIT

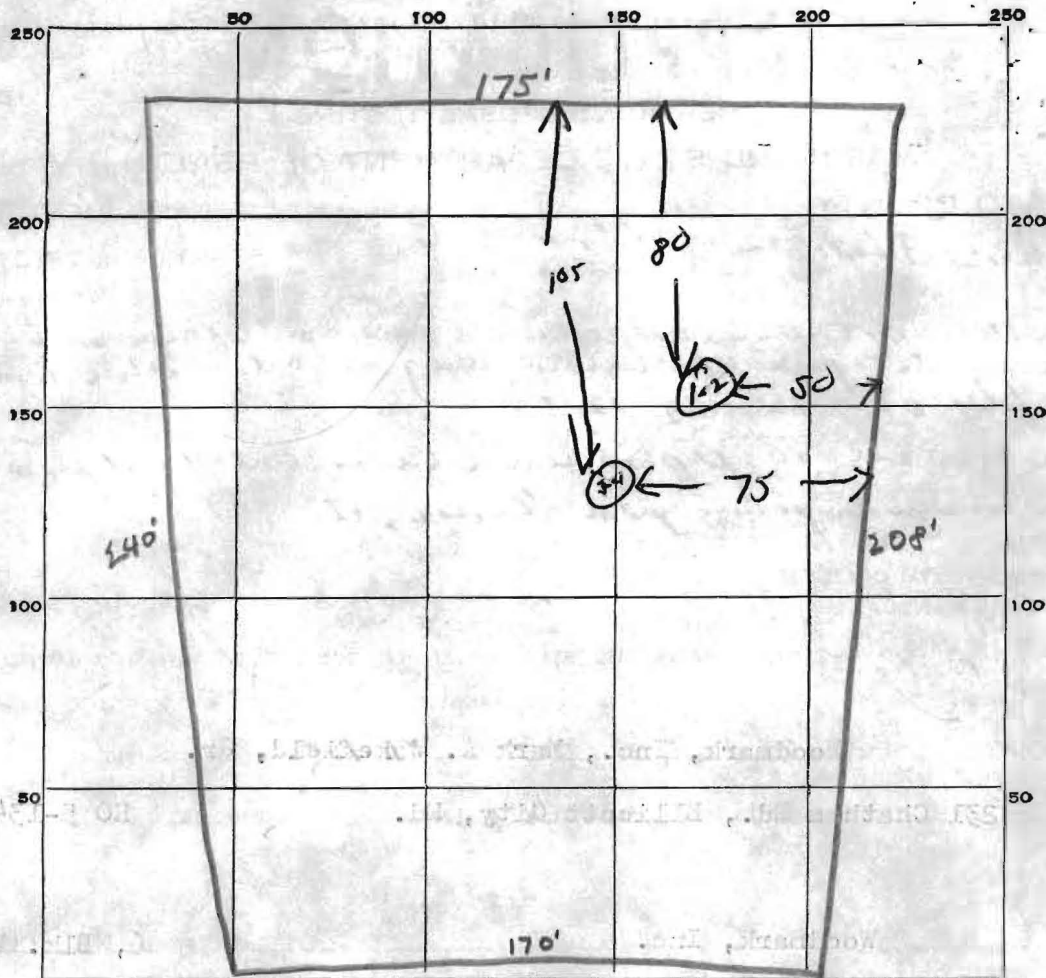

INDICATE NORTH. - NAME ADJOINING ROADWAY AS BASE LINE.

Court B

DATE	TEST NO.	DEPTH	PRE-WET		TEST - 1" DROP		TIME
			START	STOP	START	STOP	
8/9/67	1	4 1/2 ft	2 02	2 04	2 04	2 10	6 min
	2	11 1/2 ft	2 02	2 05	2 05	2 09	4 min
	3	4 ft	2 05	2 08	2 08	2 19	11 min
	4	11 ft	2 05	2 07	2 07	2 11	4 min

SOIL AUGER FINDING _____

TESTED BY DW

REMARKS use pit (3.4) for DW

Lot 6B

7

N 32° 03' 26" E
222.32'

41° 30' 0"
142'-6"

10.5'

5/10 PE
51°

Dry well
75'
Elev At Perc. 394.00
Exist Elev. 400
Wlet 4 398
+ SWK
EXIST ELEV. 401
INLET 402
INLET SIG 403

N 10° 13' 41" E
141'-2"

50'
Well

69'-6"

24'-0"

22'-0"

53'-0"

66'

LOT 6

75'

L = 53.43'
R = 516.25'

WOODSPURGE COURT

390

395

400

405

405

410

410