

APPLICATION

SEWAGE DISPOSAL TESTING

A 10323

P

MARYLAND STATE DEPARTMENT OF HEALTH

HOWARD COUNTY

3 Bedrooms

750 Tank

000

Dry Well 300 sqft
sidewall area below
inlet

ELLICOTT CITY

4 Bedrooms

1000 Tank

1000

Dry well - 400 sqft
sidewall area below
inlet

DISTRICT 5

DATE 6/15/65

Place the dry well 100 ft to 130 ft from the
TO: THE COUNTY HEALTH OFFICER
ELLICOTT CITY, MARYLAND back lot line and 20 ft to

I, HEREBY, APPLY FOR THE NECESSARY TESTS IN ORDER TO CONSTRUCT (OR RECONSTRUCT) A SEWAGE
DISPOSAL SYSTEM. 50 ft from the left side of

PROPERTY OWNER V. L. Vinella the lot as seen when

ADDRESS 12631 Circle Dr., Glen Hills, PHONE 301-762-3007
Rockville, Maryland facing the lot from

PROPERTY LOCATION: south view

SUBDIVISION Green Hill Manor LOT NO. 2, Blk. A

ROAD AND DESCRIPTION South View Ct. MONTELL COURT

OCCUPANT PHONE

PERSON TO CONSTRUCT SYSTEM

ADDRESS PHONE

SIZE OF LOT 43,200 sq. ft. TYPE BLDG. 3 or 4
NUMBER OF BEDROOMS

IF NOT SINGLE RESIDENCE DESCRIBE

SIGNATURE OF APPLICANT /s/ V. L. Vinella


APPROVED BY Raymond Hodges Dry Well DATE 17 MAR 66

REJECTED BY FOR (KIND OF SYSTEM) DATE

HOLD PENDING FURTHER TESTS DATE

REASONS FOR REJECTION OR HOLDING


THIS IS NOT A PERMIT

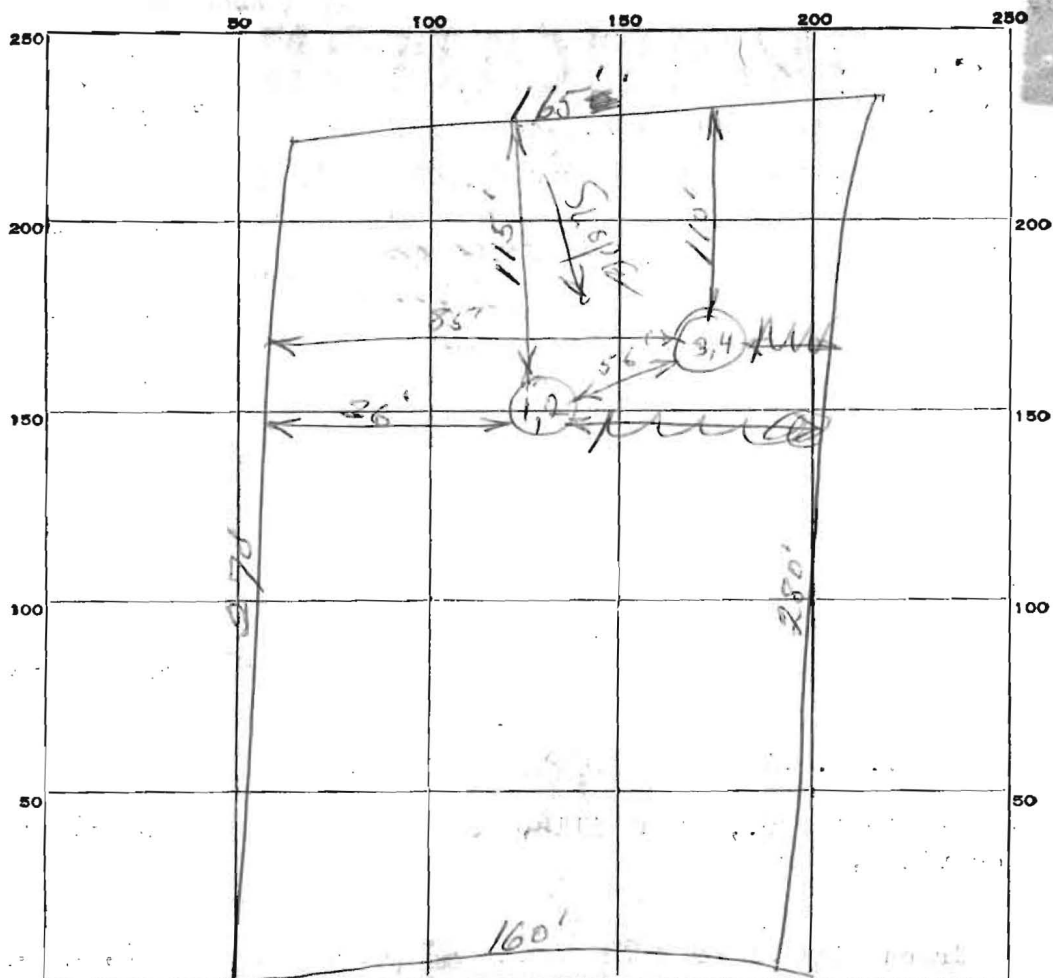[illegible]

SOIL AUGER FINDINGS

TESTED BY.

REMARKS.

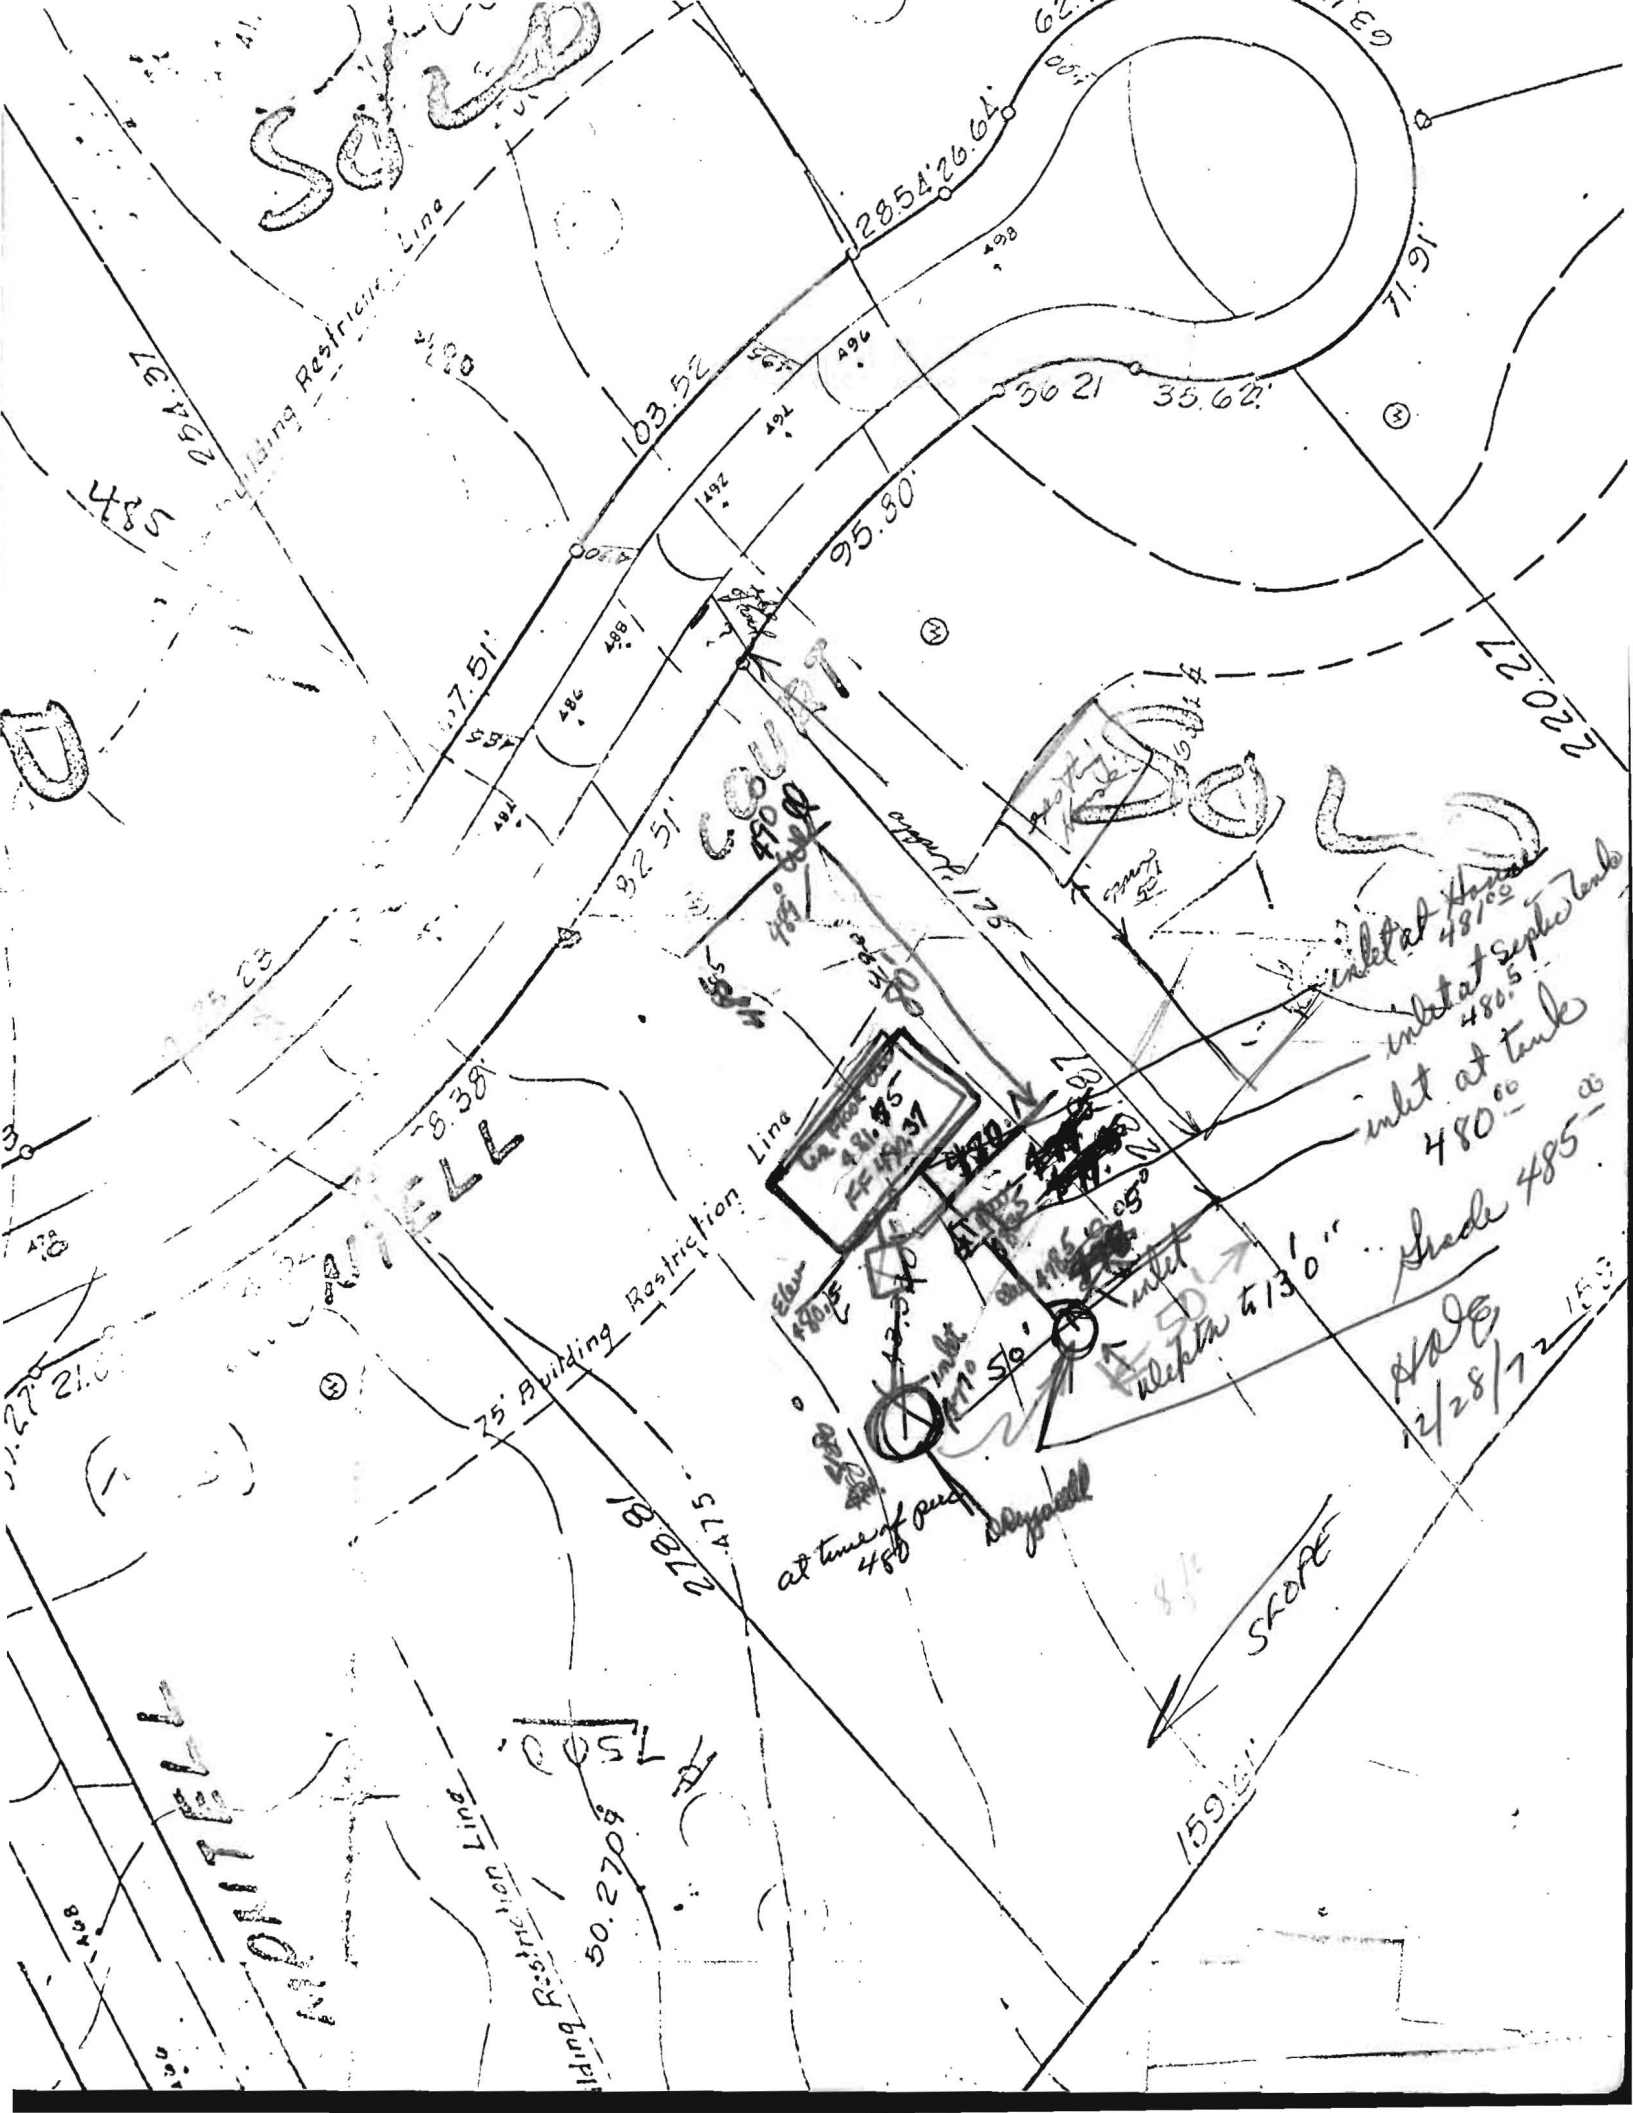


CONSUMER INFORMATION NOTES:

1. This plan is a benefit to a consumer insofar as it is required by a lender or a title insurance company or its agent in connection with contemplated transfer, financing or re-financing.
2. This plan is not to be relied upon for the establishment or location of fences, garages, buildings, or other existing or future improvements.
3. This plan does not provide for the accurate identification of property boundary lines, but such identification may not be required for the transfer of title or securing financing or re-financing.
4. Building line and/or Flood Zone information is taken from available sources and is subject to interpretation of originator.

Setback distances as shown to the principal structure from property lines are approximate. The level of accuracy for this drawing should be taken to be no greater than plus or minus 1.5 FEET.

Flood Zone "C" per H.U.D. Flood Panel No. 240044-0037B

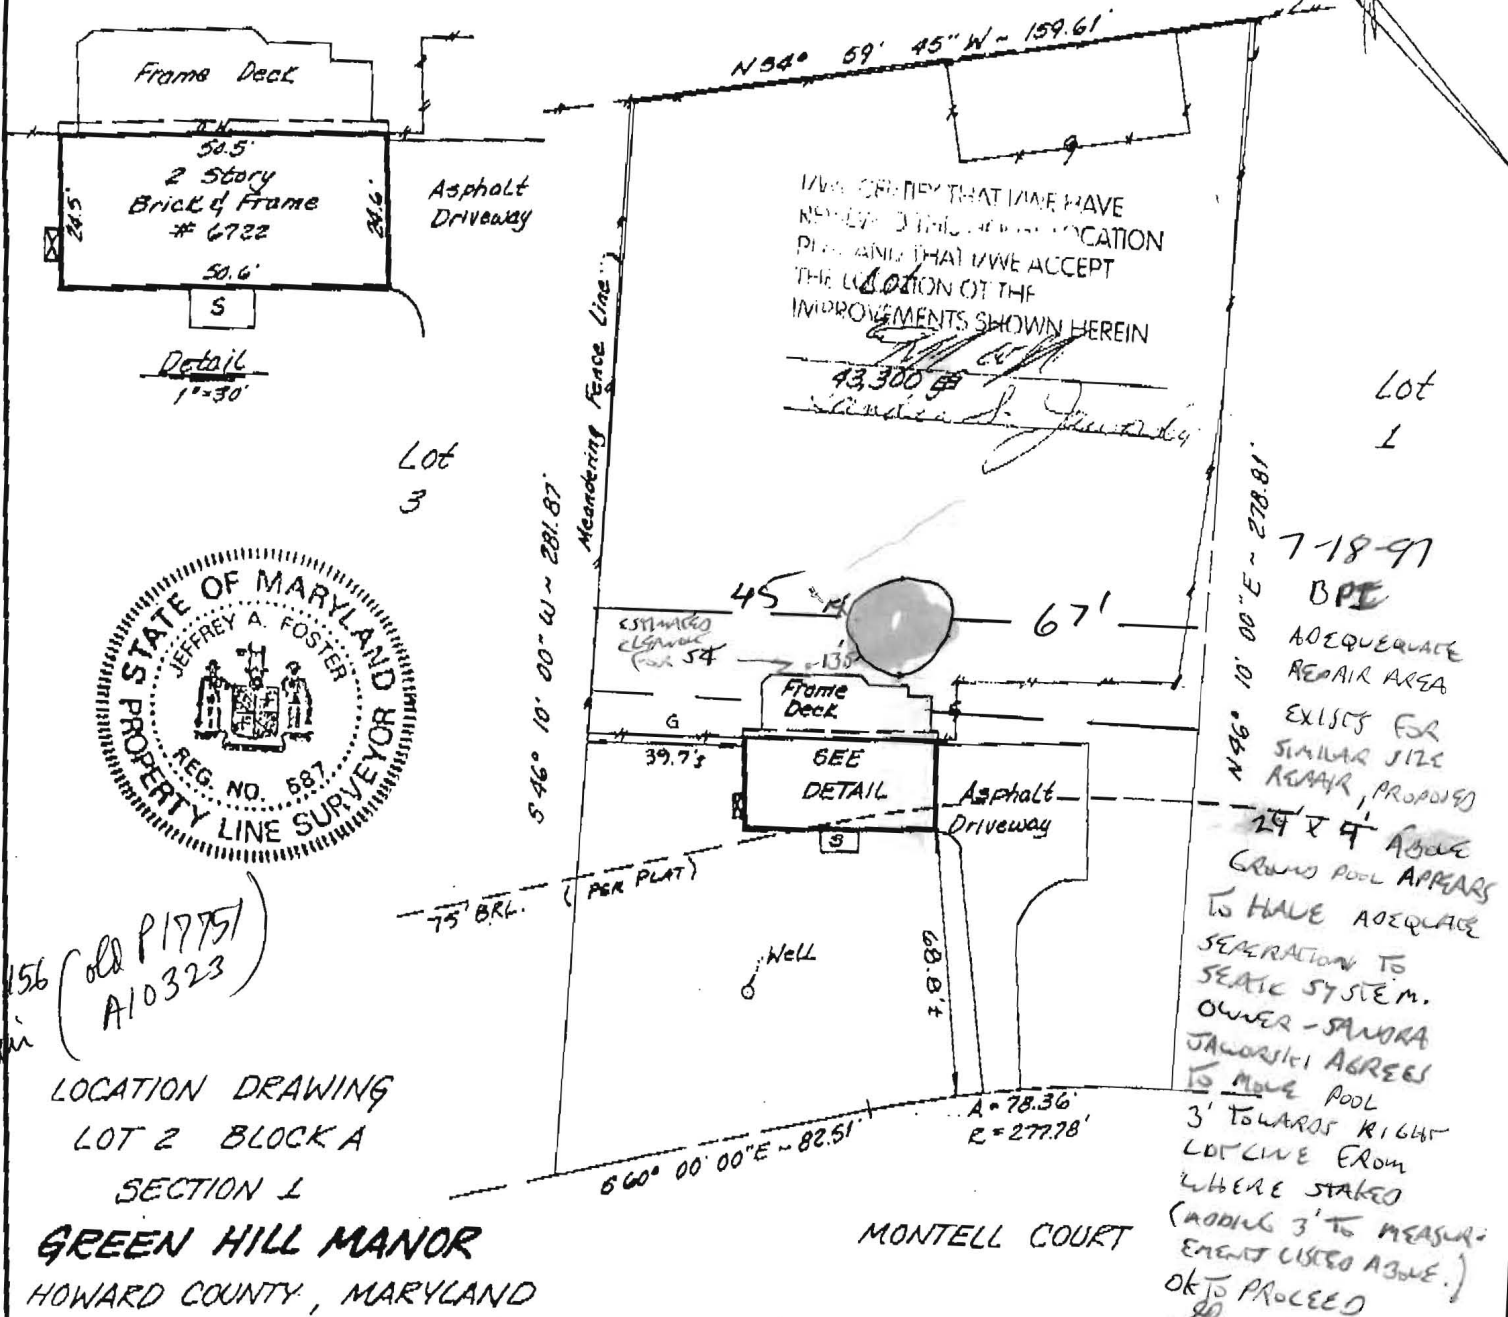

SURVEYOR'S CERTIFICATE

"THE INFORMATION SHOWN HEREON HAS BEEN BASED UPON THE RESULTS OF A FIELD INSPECTION PURSUANT TO THE DEED OR PLAT OF RECORD. EXISTING STRUCTURES SHOWN HAVE BEEN FIELD LOCATED BASED UPON MEASUREMENTS FROM PROPERTY MARKERS FOUND OR FROM EVIDENCE OF LINES OF APPARENT OCCUPATION."

Jeffrey A. Foster 587

REFERENCES

PLAT BK. W.H.H.

PLAT NO. 10

LIBER 1310

FOLIO 451



SNIDER & ASSOCIATES
SURVEYORS - ENGINEERS
LAND PLANNING CONSULTANT
2 Professional Drive, Suite 216
Gaithersburg, Maryland 20879
301/948-5100, Fax 301/948-1280

DATE OF LOCATIONS

SCALE: 1"=50'

WALL CHECK:

DRAWN BY: P.O.B

HSE. LOC.: 3-5-97

JOB NO.: 97-500

24' diameter
4 ft. height

2 ft past pool gravel