

# PERMIT

## SEWAGE DISPOSAL SYSTEM

### DEPARTMENT OF HEALTH AND MENTAL HYGIENE

P 50156  
A 10323  
A REPAIR

#### HOWARD COUNTY HEALTH DEPARTMENT

##### BUREAU OF ENVIRONMENTAL HEALTH

X461-9933 313-2640

DISTRICT 5th

DATE 7/20/94

DATE SYSTEM APPROVED 10/29/94

INSPECTOR [Signature]

INDEXED

Sandy Jaworski (Johnson Plumbing Heating) IS PERMITTED TO INSTALL ALTER X

ADDRESS 6272 Montell Court, Highland, Maryland 20777 PHONE 301-570-5593

SUBDIVISION Green Hill Manor LOT 2, Blk. A ROAD 6722 Montell Court

PROPERTY OWNER Frank and Sandy Jaworski

ADDRESS 6722 Montell Court  
Highland, Maryland 20777

SEPTIC TANK CAPACITY Existing GALLONS

NUMBER OF BEDROOMS

SQUARE FEET PER BEDROOM

LINEAR FEET OF TRENCH REQUIRED

REPAIR - PURPOSE - In support of proposed building permit application - Serial Number:  
55182 - increasing number of bedrooms.

Call for inspection when ground is opened so sanitarian can recommend repair. 07/18/94

50 long Trench, 10 1/2' Bottom, 5' gravel fill (inlet pipe at 7' to tie in with existing dry well  
Lent #6 (concrete))

PLANS APPROVED BY DATE

COVER NO WORK UNTIL INSPECTED AND APPROVED

NEITHER THE HOWARD COUNTY COUNCIL NOR THE HEALTH DEPARTMENT IS RESPONSIBLE FOR THE SUCCESSFUL OPERATION OF ANY SYSTEM

NOTE: CLEANOUT REQUIRED EVERY 70 FEET OF SEWER LINE AND/OR AT 90° SWEEPS IN LINES FROM HOUSE TO DRAIN FIELDS, 90° ELBOWS NOT ACCEPTABLE.

NOTE: ALL PARTS OF SEPTIC SYSTEMS (I.E. TANK, DISTRIBUTION BOX TRENCHES) TO BE 100 FEET FROM WELL (UNLESS OTHERWISE SPECIFICALLY AUTHORIZED)

NOTE: IF DEEP TRENCH(ES) ARE USED CALL FOR INSPECTION BEFORE AND AFTER PLACING GRAVEL IN TRENCH(ES)

NOTE: NO DRY WELL SHALL EXCEED 15 FOOT IN DIAMETER NO ABSORPTION TRENCH TO EXCEED 100 FEET IN LENGTH

NOTE: ALL PIPE FROM HOUSE TO SEPTIC TANK MUST BE CAST IRON OR SCHEDULE 35/40 PVC OR ABS

PERMIT VOID AFTER TWO YEARS


NOTE: INSTALL STAND PIPE ON SEPTIC TANK AND DRY WELL STAND PIPES MUST BE 6 INCHES IN DIAMETER CAST IRON, CONCRETE OR TERRA COTTA OR PVA OR ABS ACCEPTED. IF TOP OF SEPTIC TANK IS DEEPER THAN 3 FEET, MANHOLE TO GRADE REQUIRED.

NOTE: DISTRIBUTION BOXES MUST HAVE BAFFLES

\*INSTALLER IS RESPONSIBLE FOR OBTAINING FINAL APPROVAL ON THIS PERMIT

PERMIT SIGNED  
AND RETURNED 7-18-94  
Serial # B10106902  
above ground pipe

50156

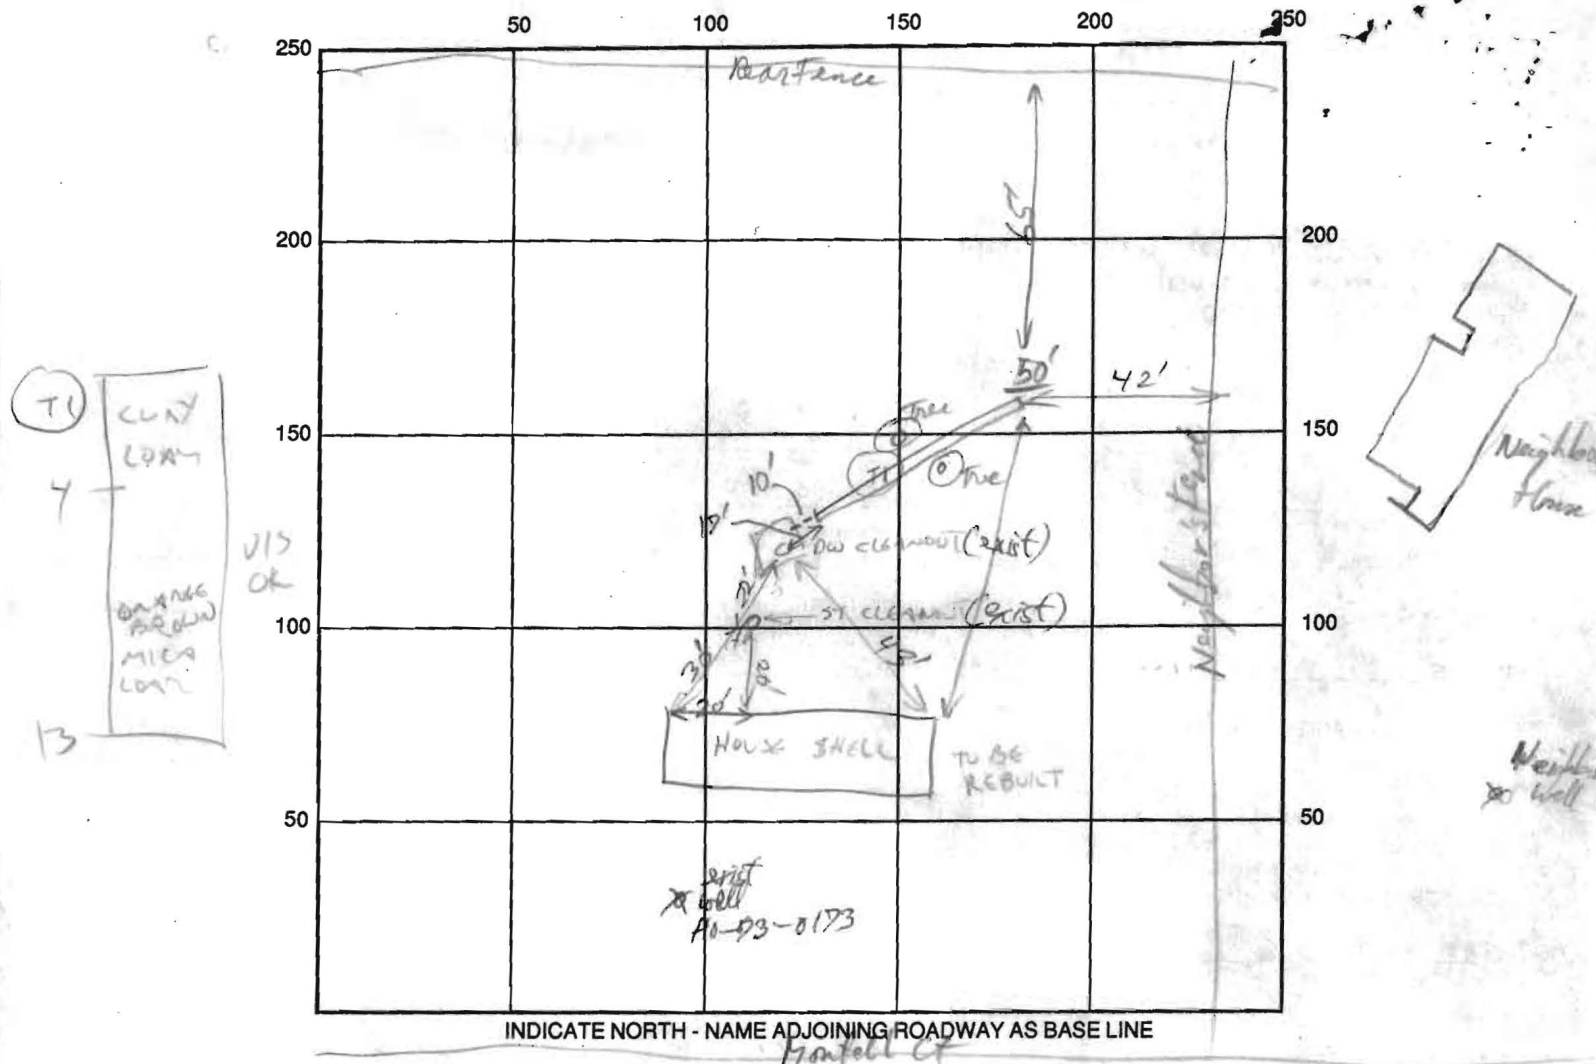

SEPTIC TANK LEVEL Existing CLEANOUTS Exist DW + ST

DISTRIBUTION BOX LEVEL VA

DRAIN FIELD/TITLE DEPTH 10 1/2 FT. TRENCH WIDTH 2 FT. INLET DEPTH 6' gravel 7' per FT.

EFFECTIVE GRAVEL DEPTH 5' FT. TOTAL LENGTH 50 FT. connected to

NUMBER OF TRENCHES one ONE SIDEWALL/BOTTOM AREA 250 SQ. FT.

DRYWALL INSIDE DIAMETER existing FT. EFFECTIVE DEPTH BELOW INLET \_\_\_\_\_ FT.

ABSORBENT AREA \_\_\_\_\_ SQ. FT.


REMARKS: 10/16/94 Test OK to 13' VERY LITTLE LIQUID BUILDUP IN DRYWELL.

OK TO ADD 50' TRENCH w/ 5'-5 1/2" STONE. (CW)

drainpipe is at 7 ft below grade, bottom @ 10 1/2 ft, due to depth of existing drywell, OK  
to put 5 ft gravel (1 ft above pipe). ok to cover when finished - good soils entire length of trench  
Apr 19/97/99

DATE SYSTEM APPROVED 10/27/94 INSPECTOR [Signature]

7/14/94 Field insp

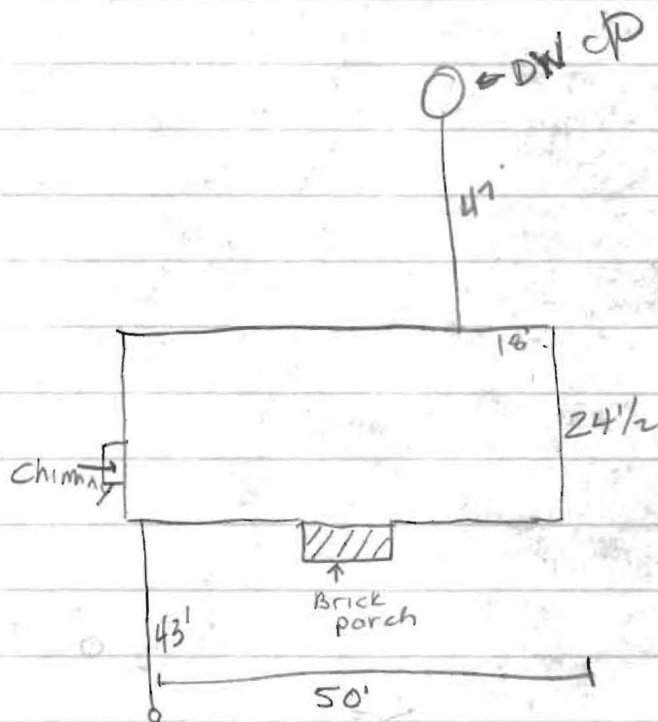


HO-73-0173 Exploratory well log location 10/27/94 RP


longest thing I could find  
didn't touch water & it was 7' long

-7/15/94

Suggest Repair - System old Adding 1 bedroom

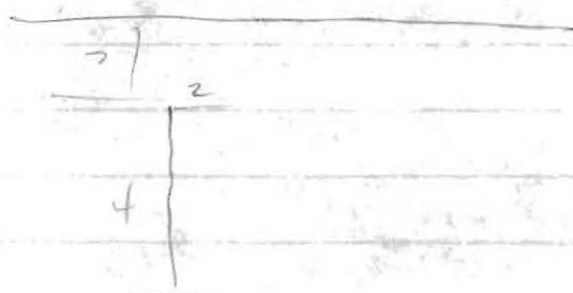

- \* LEGEND \*
- Existing contours --- 486 ---  
Proposed contours --- 488 ---  
Ex. Spot Elevations 489.3  
Prop. Spot Elevations + 83.5  
Contour Intervals 2 Ft.  
Limit of Disturbance ■■■■  
Silt Fence ——— S  
Stabilized Construction { }  
Entrance { } SCE

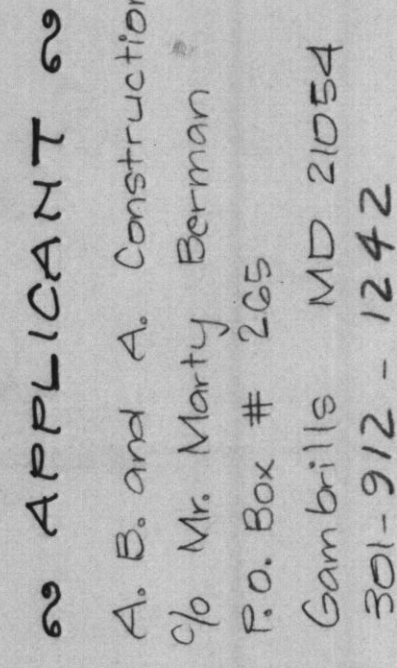

APPLICANT  
A. B. and A. Construction  
% Mr. Marty Berman  
P.O. Box # 265  
Gambills MD 21054  
301-912 - 1242

NO TITLE REPORT FURNISHED.  
PLAT SUBJECT TO RESTRICTIONS & EASEMENTS  
OF RECORD OR OTHERWISE

6722 MONTELL CT  
TOPOGRAPHIC SURVEY and SITE

LOT 2 BLOCK "A"

# GREEN HILL MANOR

Plat Book 10 274

5<sup>TH</sup> ELECTION DISTRICT

|                  |               |            |
|------------------|---------------|------------|
| DATE: 06-16-1994 | SCALE: 1"=20' | SHEET } of |
|------------------|---------------|------------|

**W.L. MEEKINS, INC.**  
3101 Ritchie Road  
Forestville, Maryland 20747  
Phone: 736-5366 / 736-7115  
736-6387 / 736-5568; 10  
W.L. Meekins, Land Surveyor  
Md.#2134 - Va.#576