

29 MAR 64 incomplete BH  
9/23/64  
Howard County  
9/23/64 - get in A.M.

# PERMIT

SEWAGE DISPOSAL SYSTEM

MARYLAND STATE DEPARTMENT OF HEALTH

HOWARD COUNTY

ELLICOTT CITY

DISTRICT 5

DATE 11-26-63

INDEXED

Hudson Co.

IS PERMITTED TO INSTALL ☒ ALTER ☐

ADDRESS \_\_\_\_\_

PHONE \_\_\_\_\_

A SEWAGE DISPOSAL SYSTEM LOCATED AT \_\_\_\_\_

SUBDIVISION Evergreen Valley

ROAD Trindolph Rd.

LOT 6, sec 2

PROPERTY OWNER Hudson Co.

ADDRESS \_\_\_\_\_

SPECIFICATIONS

for 3 bedrooms 30 sq ft. leading to depth of 4 ft on shallow side  
DRAIN FIELD \_\_\_\_\_ DEPTH \_\_\_\_\_ FEET, BOTTOM AREA \_\_\_\_\_ SQ. FT.

SEWAGE PITS \_\_\_\_\_ ABSORBENT SIDEWALL AREA \_\_\_\_\_ SQ. FT.

SEPTIC TANK CAPACITY 450 GALLONS

FOR GARBAGE GRINDER, INCREASE DISPOSAL AREA 25% & TANK CAPACITY 50%.

OTHER Place system 120 ft. from rear lot line and 4 ft from

left lot line as shown in facing lot from Trindolph Rd.  
House has 4 bedrooms 24 MAR 64 BH


PLANS APPROVED BY J. H. Hagan

DATE 1-23-64

FILL SEPTIC TANK AND DISTRIBUTION BOX WITH WATER BEFORE CALLING FOR AN INSPECTION. COVER NO WORK UNTIL INSPECTED AND APPROVED.

NEITHER THE HOWARD COUNTY COMMISSIONERS NOR THE HEALTH DEPARTMENT IS RESPONSIBLE FOR THE SUCCESSFUL OPERATION OF ANY SYSTEM.

106296

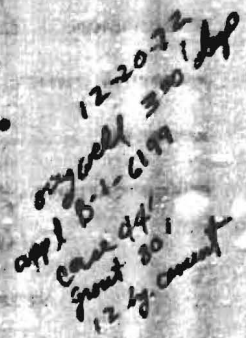

DATE SYSTEM APPROVED 2/28/87 INSPECTOR [Signature]