

APPROVED


WALK-THRU BUILDING PERMIT

BP# 600157902 A# 520074-A


APP. SAN KJS DATE: 1-26-00

DESC. OF WORK: new garage

well
④ 94-3996

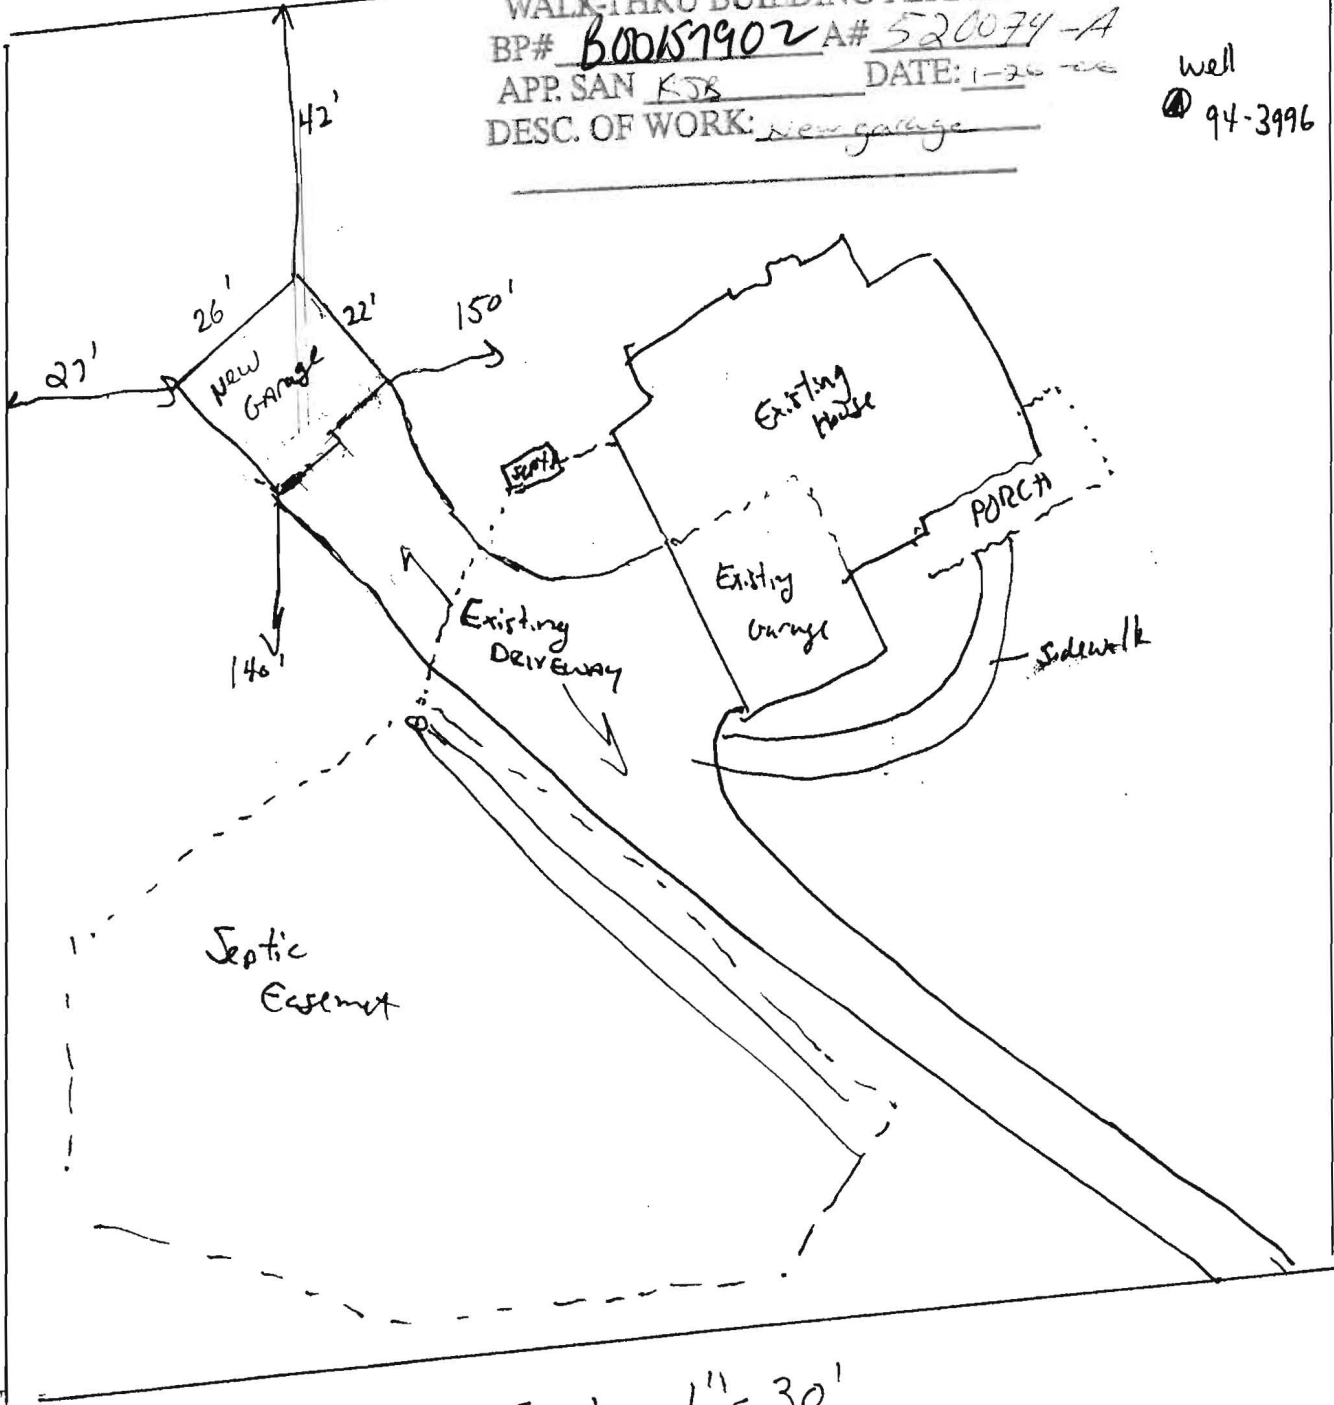

Scale 1" = 30'

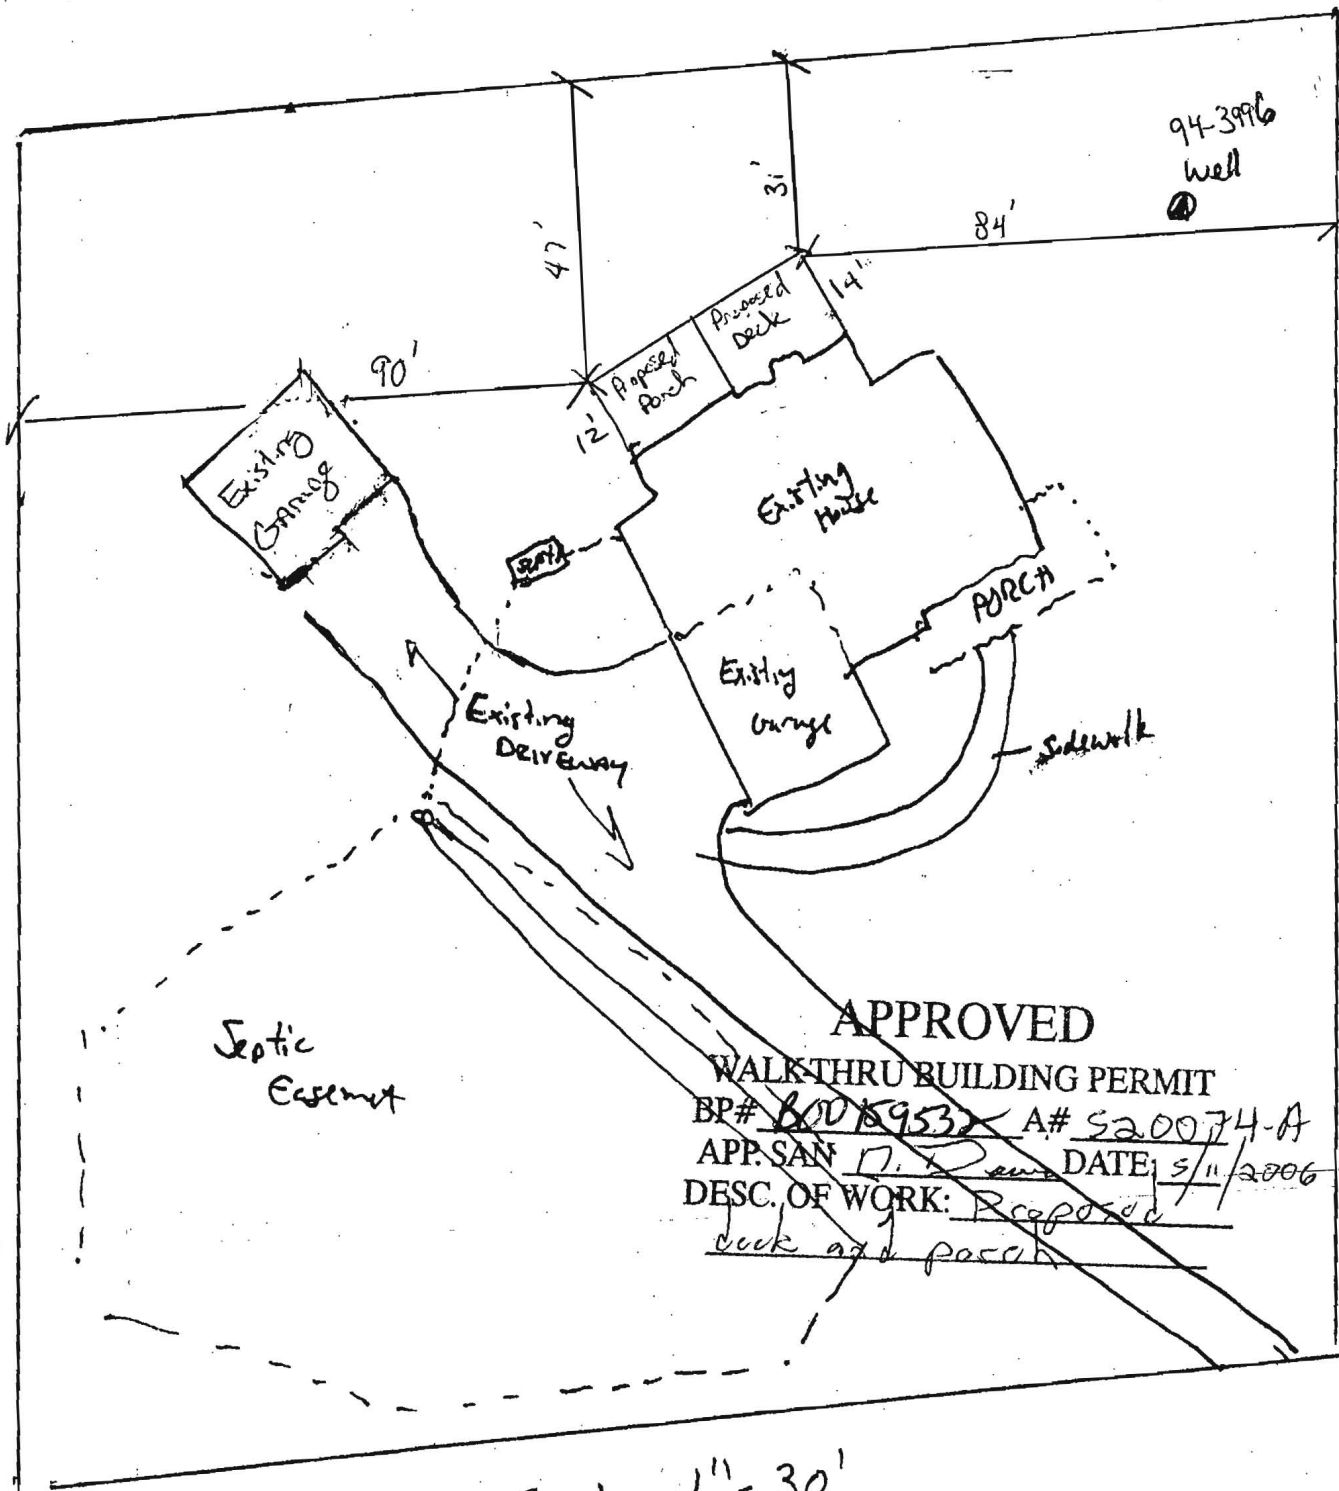


APPROVED
WALKTHRU BUILDING PERMIT
BP# 80089532 A# 520074-A
APP. SAN 17.2 DATE 5/11/2006
DESC. OF WORK: Proposed
deck and porch

Scale 1" = 30'
5/11/2006

4/22/05
 Proposed LP tank
 location OK - septic tanks
 not installed yet, however, proposed
 septic tank locations would
 be 10'± to LP tank
 location
 KN

TON PARCEL 'B'
 PROPERTY
 #13271

YERS
 (8
 L)

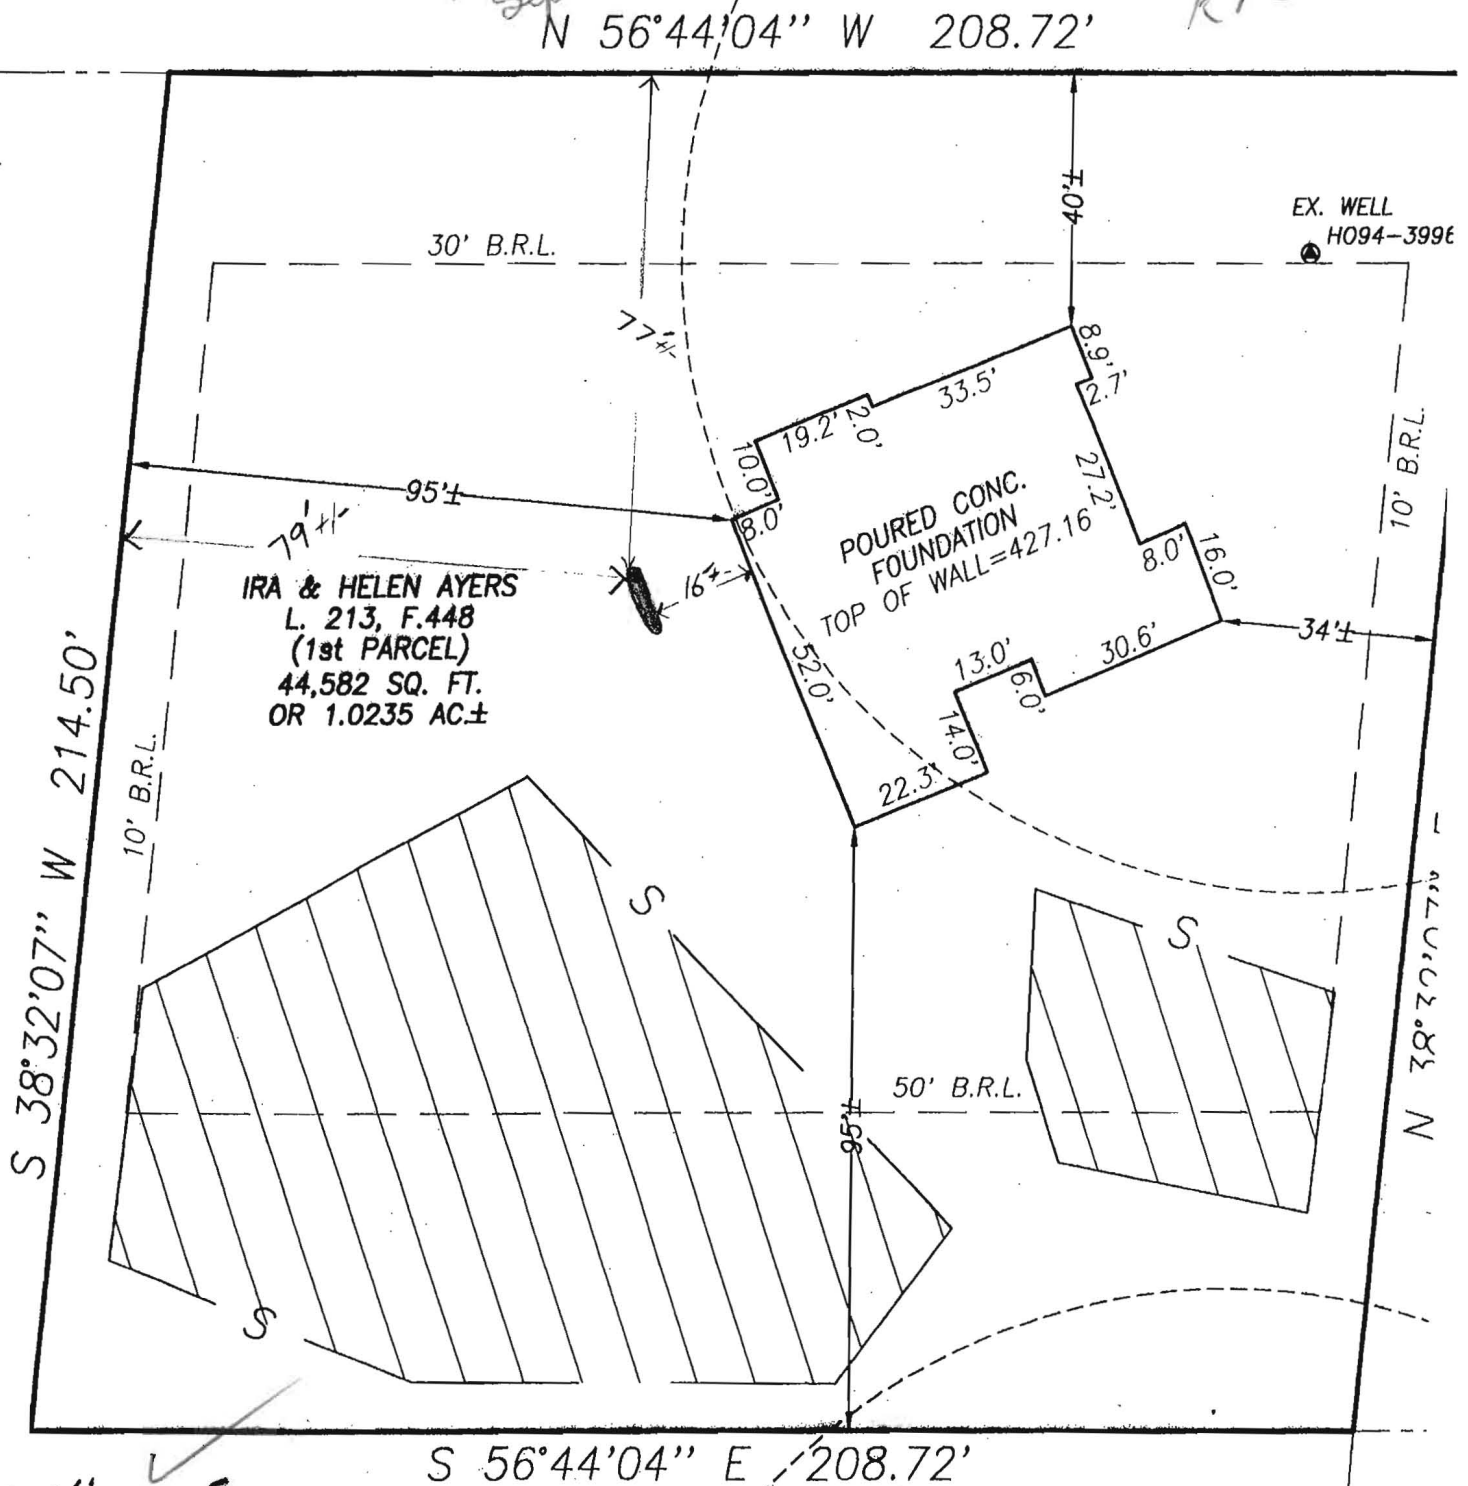

Scale 1" = 30'