

2/3/04 9:30

PUB. SEWER STATUS VERIFIED BY _____

ISSUE DATE: 2/5/04

APPROVAL DATE: 2/11/04

PERMIT
INDEXED

P 520051

A Repair

ON-SITE SEWAGE DISPOSAL SYSTEM
HOWARD COUNTY HEALTH DEPARTMENT
BUREAU OF ENVIRONMENTAL HEALTH

03-291669

Jenkins Brothers

IS PERMITTED TO INSTALL ☐ ALTER ☒

ADDRESS: 7670 Smiths Private Rd, Sykesville

PHONE NUMBER: 410-461-9282

SUBDIVISION: _____

LOT NUMBER: _____

ADDRESS: 596 River Road

PROPERTY OWNER: Frank Mood

SEPTIC TANK CAPACITY (GALLONS):

Existing

PUMP CHAMBER CAPACITY (GALLONS):

N/A

NUMBER OF BEDROOMS:

3

SQUARE FEET PER BEDROOM:

180

LINEAR FEET OF TRENCH REQUIRED:

75'

Trench Inlet - 2.5'
Trench Depth - 7.5'
75' Length, 2' Wide
5' of Gravel

Can Pump out Drywell
and Fill With Gravel or Dirt

TRENCHES:	Trench to be _____ feet wide. Inlet _____ feet below original grade. Bottom maximum depth _____ feet below original grade. Effective area begins at _____ feet below original grade. _____ feet of stone below distribution pipe.
LOCATION:	
PURPOSE:	Existing septic system has failed. Call for inspection when ground is opened so sanitarian can recommend repair.

PLANS APPROVED: Brian Baker

DATE: _____

NOTE: PERMIT VOID AFTER 2 YEARS

NOTE: CONTRACTOR RESPONSIBLE FOR SCHEDULING A PRE-CONSTRUCTION INSPECTION FOR ALL INSTALLATIONS

NOTE: WATERTIGHT SEPTIC TANKS REQUIRED


NOTE: ALL PARTS OF SEPTIC SYSTEM SHALL BE 100 FEET FROM ANY WATER WELL

NOTE: MANHOLE RISERS REQUIRED ON ALL SEPTIC TANKS AND PUMP CHAMBERS

**NEITHER THE HOWARD COUNTY COUNCIL OR THE HEALTH DEPARTMENT IS
RESPONSIBLE FOR THE SUCCESSFUL OPERATION OF ANY SYSTEM
PERMITTEE RESPONSIBLE FOR OBTAINING FINAL APPROVAL ON THIS PERMIT
CALL 410-313-2640 FOR INSPECTION OF SEPTIC SYSTEM**

P520051

NOT TO SCALE

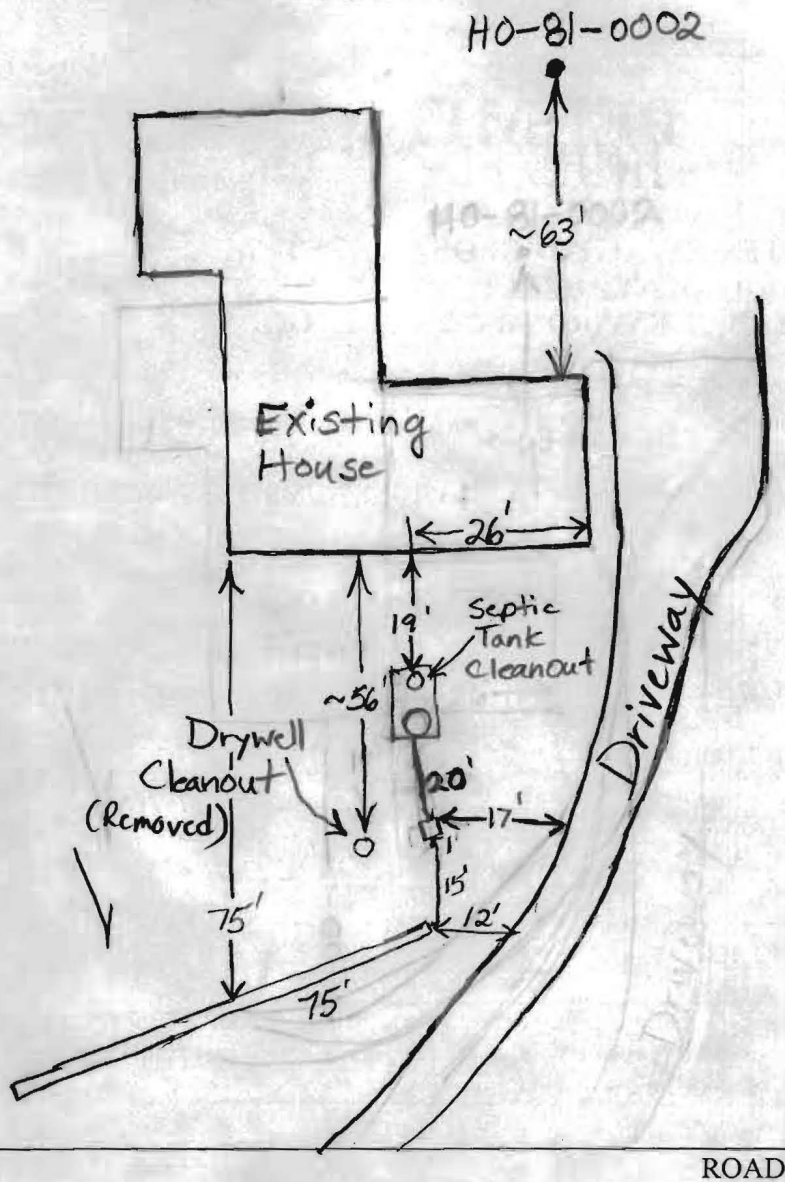

TRENCH/DRAINFIELD DATA		
WIDTH	INLET	BOTTOM
<u>2</u>	<u>2.5</u>	<u>7.5</u>
NUMBER OF TRENCHES	<u>1</u>	
TOTAL LENGTH	<u>75'</u>	
ABSORPTION AREA	<u>375 sqft.</u>	
DISTRIBUTION BOX LEVEL		
DISTRIBUTION BOX BAFFLE		
DISTRIBUTION BOX PORT	<u>No</u>	



SEPTIC TANK DATA	
SEPTIC TANK 1 LEVEL	
CAPACITY	<u>Existing</u> GAL
SEAM LOC	
TANK LID DEPTH	
BAFFLES	
BAFFLE FILTER	
MANHOLE LOC	<u>Rear</u>
6" PORT LOC	<u>Front</u>
WATERTIGHT TEST	
SEPTIC TANK 2 LEVEL	<u>N/A</u>
CAPACITY	
SEAM LOC	
TANK LID DEPTH	
BAFFLES	
BAFFLE FILTER	
MANHOLE LOC	
6" PORT LOC	
WATERTIGHT TEST	

PRE-CONSTRUCTION 2/5/04 To install one 75' trench on contour above the drywell or directly below it. The drywell can be filled with gravel and used as a backup for the trench (distribution box required), or can be filled with dirt and abandoned. (BB) 2/11/04 O.K. to cover trench. Tank, drywell are covered. Jenkins said he replaced rear baffle. Distribution box partially covered. Line disconnected from tank to drywell, drywell filled with gravel, lid crushed, cleanout removed and gravel covered with dirt per Jenkins. O.K. to cover everything else. (BB)

FINAL INSPECTOR B. Baker DATE OF APPROVAL 2/11/04

LIBER 611; PAGE 613

3 acres

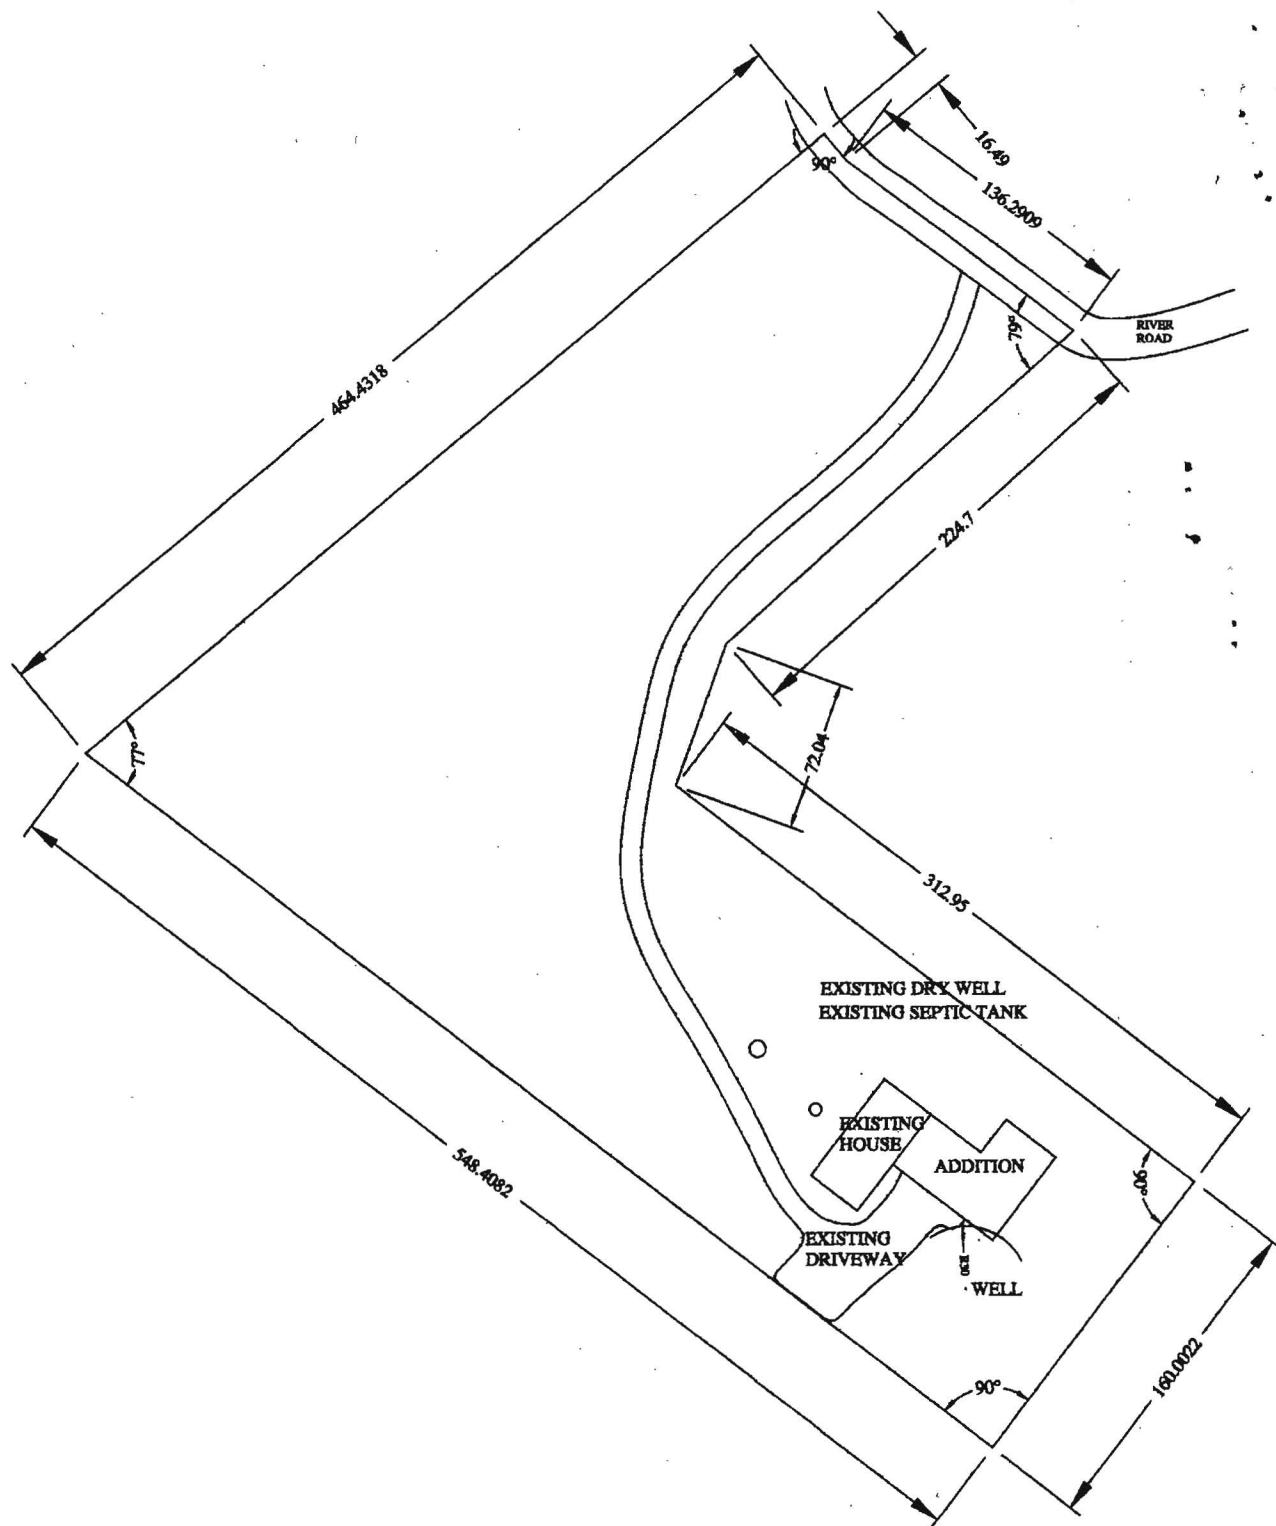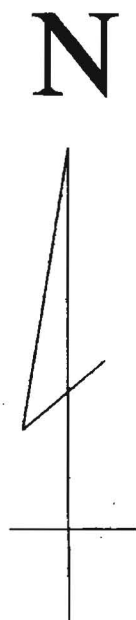

MOOD ADDITION

