

PERMIT
SEWAGE DISPOSAL SYSTEM
HOWARD COUNTY HEALTH DEPARTMENT
BUREAU OF ENVIRONMENTAL HEALTH
410-313-2640

P _____

A 513373B

ISSUE DATE _____

APPROVAL DATE _____

INDEXED

_____ IS PERMITTED TO INSTALL _____ ALTER _____

ADDRESS _____ PHONE _____

SUBDIVISION _____ LOT NUMBER _____ ADDRESS 596 River Road

PROPERTY OWNER Franklin Mood PROPERTY OWNER'S ADDRESS 596 River Road

SEPTIC TANK CAPACITY _____ GALLONS

PUMP CHAMBER CAPACITY _____ GALLONS

NUMBER OF BEDROOMS _____

SQUARE FEET PER BEDROOM _____

LINEAR FEET OF TRENCH REQUIRED _____

TRENCHES: Trenches to be _____ feet wide. Inlet _____ feet below original grade. Bottom maximum depth _____ feet below original grade. _____ feet of stone below distribution box.

LOCATION: _____

Garage/workroom
Mod 23891 6/2/00

PLANS APPROVED _____ DATE _____

PERMIT VOID AFTER 2 YEARS

NOTE: CONTRACTOR RESPONSIBLE FOR SCHEDULING A PRE-CONSTRUCTION INSPECTION FOR ALL INSTALLATIONS

NOTE: TOP OF SEPTIC TANKS ARE TO BE NO DEEPER THAN 3.0 FEET BELOW FINISH GRADE

NOTE: WATERTIGHT SEPTIC TANKS REQUIRED

NOTE: CLEANOUT REQUIRED EVERY 70 FEET OF SEWER LINE AND/OR AT 90° SWEEPS IN LINES FROM HOUSE TO DRAIN FIELDS, 90° ELBOWS ARE NOT ACCEPTABLE

NOTE: ALL PARTS OF SEPTIC SYSTEMS (I.E. TANK, DISTRIBUTION BOX, DRAINFIELDS) TO BE 100 FEET FROM ANY WATER WELL UNLESS OTHERWISE SPECIFICALLY AUTHORIZED

NOTE: NO ABSORPTION TRENCH TO EXCEED 100 FEET IN LENGTH UNLESS SPECIFICALLY AUTHORIZED

NOTE: ALL PIPE FROM HOUSE TO SEPTIC TANK MUST BE CAST IRON OR SCHEDULE 35/40 PVC OR ABS

NOTE: MANHOLE RISERS REQUIRED ON ALL SEPTIC TANKS AND PUMP CHAMBERS

NOTE: DISTRIBUTION BOXES MUST HAVE BAFFLES

NOTE: IF PUMPED SEPTIC SYSTEM REQUIRED, (1) SEPTIC PUMP DETAIL TO BE PROVIDED BY INSTALLER PRIOR TO ISSUANCE OF SEPTIC PERMIT (2) PUMP PERFORMANCE TEST IS NECESSARY PRIOR TO HEALTH DEPARTMENT APPROVAL OF SEPTIC PERMIT

NEITHER THE HOWARD COUNTY COUNCIL NOR THE HEALTH DEPARTMENT IS RESPONSIBLE FOR THE
SUCCESSFUL OPERATION OF ANY SYSTEM
PERMITTEE RESPONSIBLE FOR OBTAINING FINAL APPROVAL ON THIS PERMIT
CALL 410-313-2640 FOR INSPECTION OF SEPTIC SYSTEM

H 513373B

NOT TO SCALE

TRENCH DATA

TRENCH WIDTH _____

TRENCH INLET DEPTH _____

TRENCH BOTTOM DEPTH _____

DEPTH OF STONE _____

NUMBER OF TRENCHES _____

TOTAL TRENCH LENGTH _____

ABSORBENT AREA _____

DISTRIBUTION BOX LEVEL _____

BAFFLE IN DISTRIBUTION BOX _____

SEPTIC TANK DATA

SEPTIC TANK _____ GALLONS

MANHOLE RISER _____

6 INCH INSPECTION PORT _____

PUMP CHAMBER DATA

PUMP CHAMBER
GALLONS _____

MANHOLE RISER _____


ALARM _____

PUMP PERFORMANCE TEST _____

PRE-CONSTRUCTION INSPECTION: _____

INSPECTION COMMENTS: _____

INSPECTOR _____ DATE SYSTEM APPROVED _____

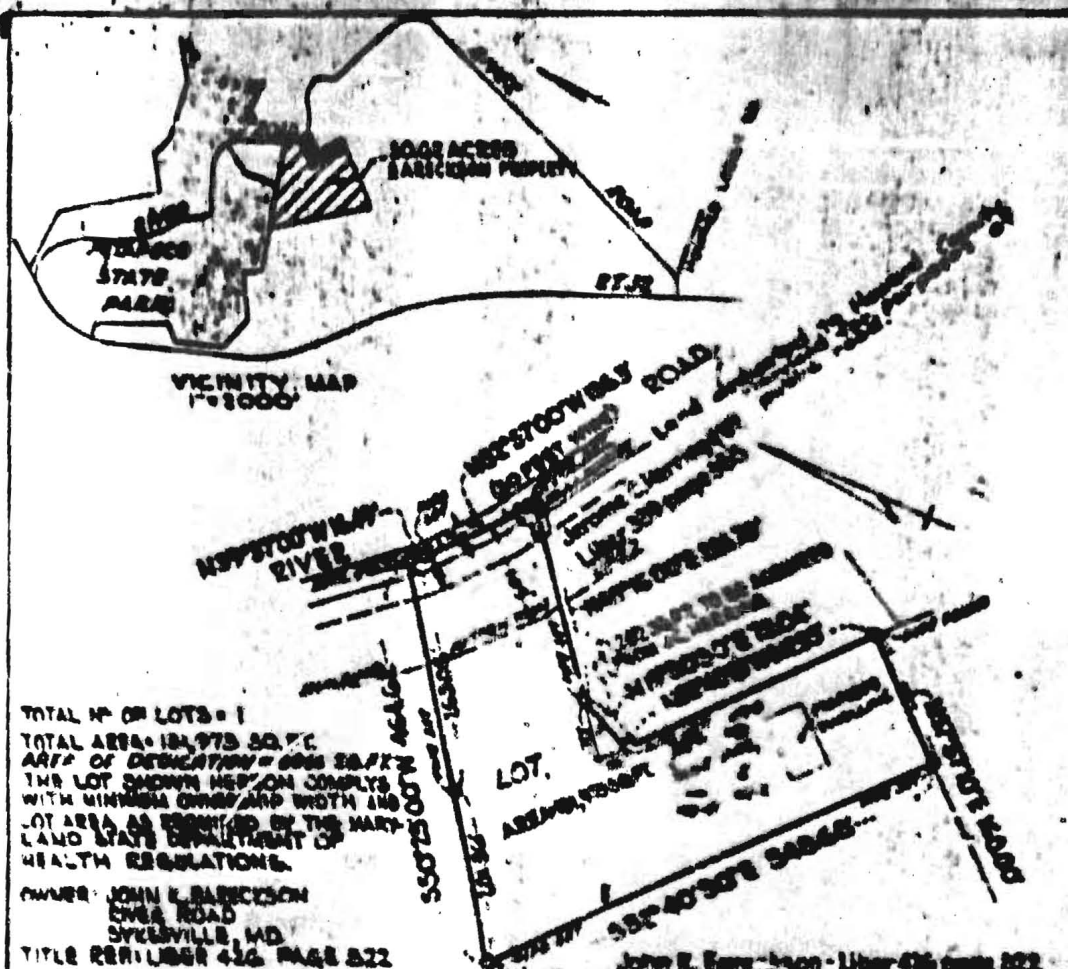

TOTAL NO. OF LOTS = 1
 TOTAL AREA = 134,973 SQ. FT.
 AREA OF DEDICATION = 6000 SQ. FT.
 THE LOT SHOWN HEREON COMPLIES
 WITH MINIMUM DIMENSIONS AND WIDTH AND
 LOT AREA AS REQUIRED BY THE MARY-
 LAND STATE DEPARTMENT OF
 HEALTH REGULATIONS.

OWNER: JOHN E. BARCKSON
 CHESA ROAD
 SYKESVILLE, MD.
 TITLE REF: LIBER 426 PAGE 322

OWNER: JEROME C. HERRING, JR.
 RIVER ROAD
 SYKESVILLE, MD.
 TITLE REF: LIBER 369 PAGE 368

ELECTION DISTRICT NO. 3
 HOWARD COUNTY
 STATE TAX MAP NO. 4
 PARCEL 3
 ZONED R-40

SUBDIVISION PLAT
 BARCKSON PROPERTY
 SCALE: 1" = 200'
 DATED: 6-5-72

APPROVED: PRIVATE WATER AND PRIVATE SEWER

COUNTY HEALTH OFFICER

DATE

APPROVED: DIVISION OF LAND DEVELOPMENT AND
 TRANSPORTATION PLANNING

PLANNING DIRECTOR

DATE

OWNERS CERTIFICATE

I the undersigned owner of the property
 shown hereon, my heirs or assigns, accept this
 plan of subdivision and do hereby establish
 the building restriction line shown hereon
 in order to comply with the general plan of
 highways of Howard County, and including the land
 dedication herein for the widening of River Rd.

JOHN E. BARCKSON

JEROME C. HERRING

T.M. HOFFMAN & ASSOC. INC.
 SURVEYORS & PLANNERS
 1005 W. ROGERS AVE., BALTO., MD.

21115

IDENTITY AND

WATER WELL, II
ELEV. ELEV. II



INT. ELEV. 0.0
INT. ELEV. 3.0

Deposited

72.95'

WATER

0.15

8/18/72

1:60

ALL ELEVATIONS RELATIVE
TO SEPTIC TANK

72.94'

WATER

PERMIT

SEWAGE DISPOSAL SYSTEM

MARYLAND STATE DEPARTMENT OF HEALTH

HOWARD COUNTY

ELLICOTT CITY

DISTRICT 3rd

DATE 10/15/78

INDEXED

Laborer Building Service

IS PERMITTED TO INSTALL 1 ALTER

ADDRESS Bramble Road, Box 21A, Harriettsville, Md. PHONE 732-2442

A SEWAGE DISPOSAL SYSTEM LOCATED AT _____

SUBDIVISION _____

ROAD River Road - see collector 1
call for directions

PROPERTY OWNER Frank Reed & Wife

ADDRESS River Road, Spheerville, Md.

SPECIFICATIONS 3 bedrooms

DRAIN FIELD _____ DEPTH _____ FEET, BOTTOM AREA _____ SQ. FT.

SEEPAGE PITS _____ ABSORBENT SIDEWALL AREA _____ SQ. FT.

SEPTIC TANK CAPACITY 1000 GALLONS

FOR GARAGE GRINDER, INCREASE DISPOSAL AREA SET & TANK CAPACITY SEE 31

OTHER DRY WELL - 100 sq. ft. absorbing sidewall area to begin below the first 30 ft. of non-absorbent ground. Maximum depth permitted for dry well is 13 ft. below original grade. Place dry well about 75 ft. from rear lot line (340.00 lot line) and about 300 ft. from left side line (100.00 line) as soon when facing lot from River Road.

NOTE: ALL PIPE FROM HOUSE TO SEPTIC TANK MUST BE CAST IRON.

PERMIT VALID AFTER THREE YEARS.

NOTE: INSTALL STAND PIPE ON SEPTIC TANK AND DRY WELL.

PLANS APPROVED BY Donald W. Monaghan

DATE 6/3/78


FILL SEPTIC TANK AND DISTRIBUTION BOX WITH WATER BEFORE CALLING FOR AN INSPECTION. COVER NO WORK UNTIL INSPECTED AND APPROVED.

NEITHER THE HOWARD COUNTY COMMISSIONERS NOR THE HEALTH DEPARTMENT IS RESPONSIBLE FOR THE SUCCESSFUL OPERATION OF ANY SYSTEM.

5.10
123
26

37.6
91
3384

596 River Road

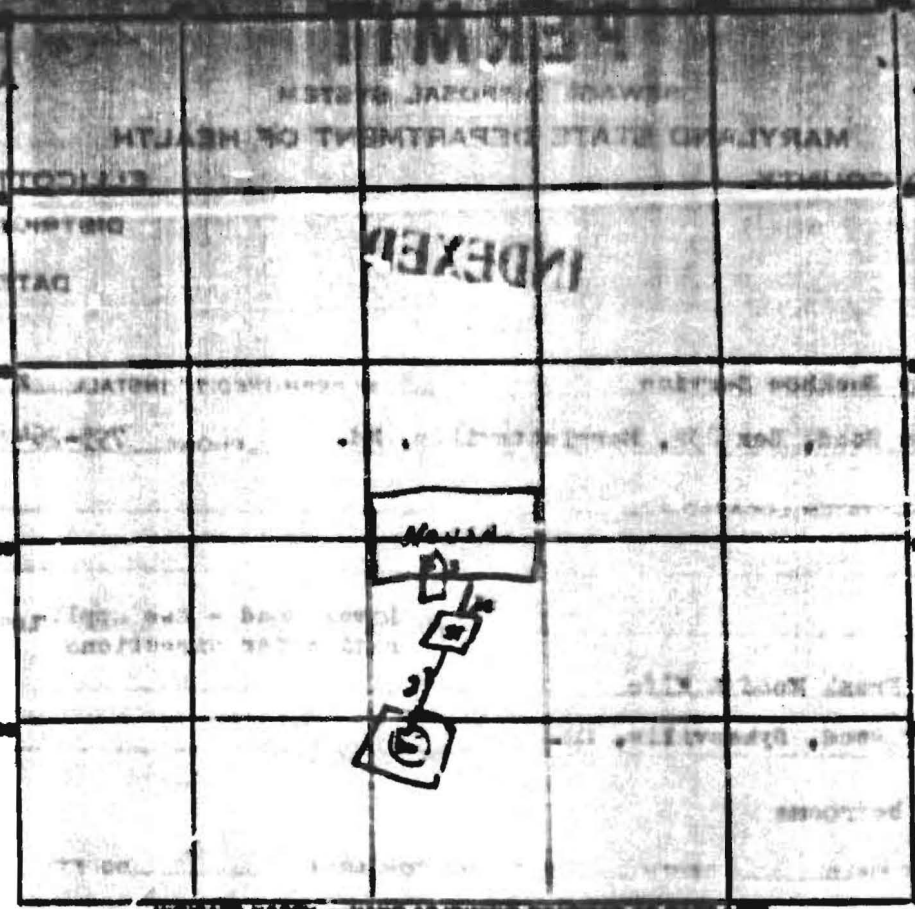

PERMIT CARD CK

SEPTIC TANK, LEVEL OK CLEANING OK

DISTRIBUTION BOX, LEVEL _____

TILE FIELD, DEPTH _____ FT. TRENCH WIDTH _____

GRAVEL, DEPTH _____ IN. TOTAL LENGTH _____ FT.

NUMBER OF TRENCHES _____ TOTAL BOTTOM AREA _____

SEEPAGE PT. outside DRAINAGE DIAMETER 12 FT. DEPTH BELOW GROUND 9ft +

ABSORBENT AREA 338 + SQ. FT.

REMARKS _____

DATE SYSTEM APPROVED 11/16/72 INSPECTOR D. M. M...