

APPLICATION

SEWAGE DISPOSAL TESTING

MARYLAND STATE DEPARTMENT OF HEALTH

HOWARD COUNTY 750 Gallon Tank

ELLICOTT CITY

Tile Field - 470 sq ft bottom area or

DISTRICT 3

Leaching Bed - 600 sq ft bottom area with DATE 8-2-66
with bottom filled to grade 4 ft to 6 ft.

Place the underground drainage system in the
10 ft to 50 ft from the left side of the lot as seen
when facing the lot from Thompson Drive and
70 ft to 160 ft from the front lot line

TO: THE COUNTY HEALTH OFFICER
ELLICOTT CITY, MARYLAND

INDEXED

I, HEREBY, APPLY FOR THE NECESSARY TESTS IN ORDER TO CONSTRUCT (OR RECONSTRUCT) A SEWAGE DISPOSAL SYSTEM.

PROPERTY OWNER

Ruby Katherine Nancy

ADDRESS

Thompson Dr. E.C.

PHONE

011

40

PROPERTY LOCATION

SUBDIVISION

LOT NO.

ROAD AND DESCRIPTION

*Thompson Dr - approx 1 mile from
Rt 144 on left. (2410 Thompson DRIVE)*

OCCUPANT

PHONE

PERSON TO CONSTRUCT SYSTEM

ADDRESS

PHONE

SIZE OF LOT

1 acre (135' x 308')

TYPE BLDG.

3

IF NOT SINGLE RESIDENCE DESCRIBE

SIGNATURE OF APPLICANT

Mr. William C. Isaac

*147. Balt Nat Pike
E.C. - 465-3046*

APPROVED

Raymond Hedges

FOR

Tile field

DATE

15 AUG 66

REJECTED BY

FOR

REASON OF SYSTEM

DATE

HOLD PENDING FURTHER TESTS

DATE

REASONS FOR REJECTION OR HOLDING


BLDG. PERMIT DULNED

AND RETURNED

*2-17-97
Said # 6010068-96
garage*

THIS IS NOT A PERMIT

A 58574-B

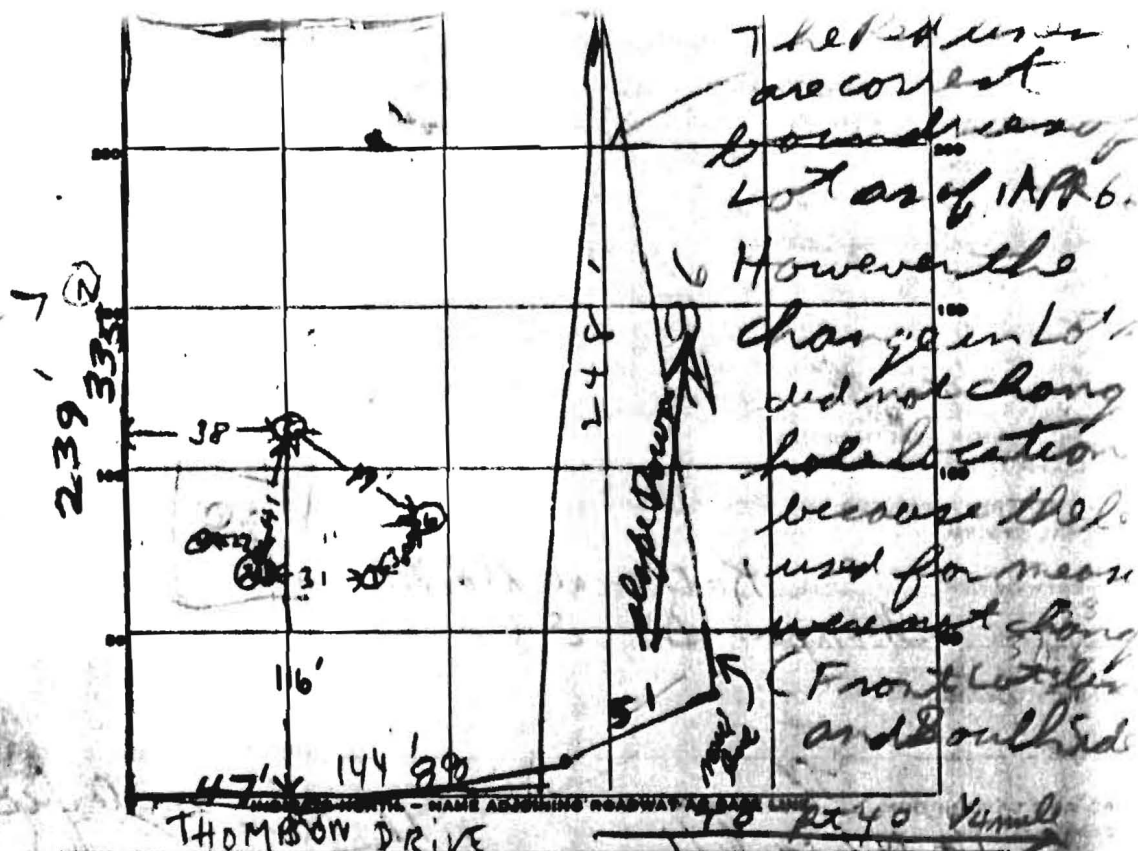

DATE	TEST NO.	DEPTH	PRE-WET		TEST - 1" DROP		TIME
			START	STOP	START	STOP	
8/15/62	1	3 1/2 ft	9:41	10:20	10:20	11:00	8 ft
8/15/62	2	8 1/2 ft	9:44	9:48	9:48	9:53	5 ft
8/15/62	3	4 1/2 ft	9:47	9:59	9:59	10:31	32 ft
8/15/62	4	3 ft	9:49	9:51	9:51	9:55	4 ft
8/15/62	5	3 1/2 ft	10:00	10:19	10:19	10:55	36 ft
8/15/62	6	3 ft	10:03	10:43	10:43	11:00	28 ft
HO - 6'7" - W - 9.3 Ed Brown #8 perpendicular / 90 ft from road, west side							

WELL

72792
DWR

SON-AUGER-FINDING *Dry Well not approved because of suspicion of under*
TESTED BY *B. Hodges & H.C. 7 residents*
REMARKS *House to be located between test hole & front lot*
ALSO PRESENT *P. Dillert & M. Seal* LOT NO. *10*

TESTED BY B. Hedges & F. C. F. Robinson

REMARKS: House to be located between test hole bar front lot

ALSO PRESENT: P. D. H. & M. Seal LOT NO.